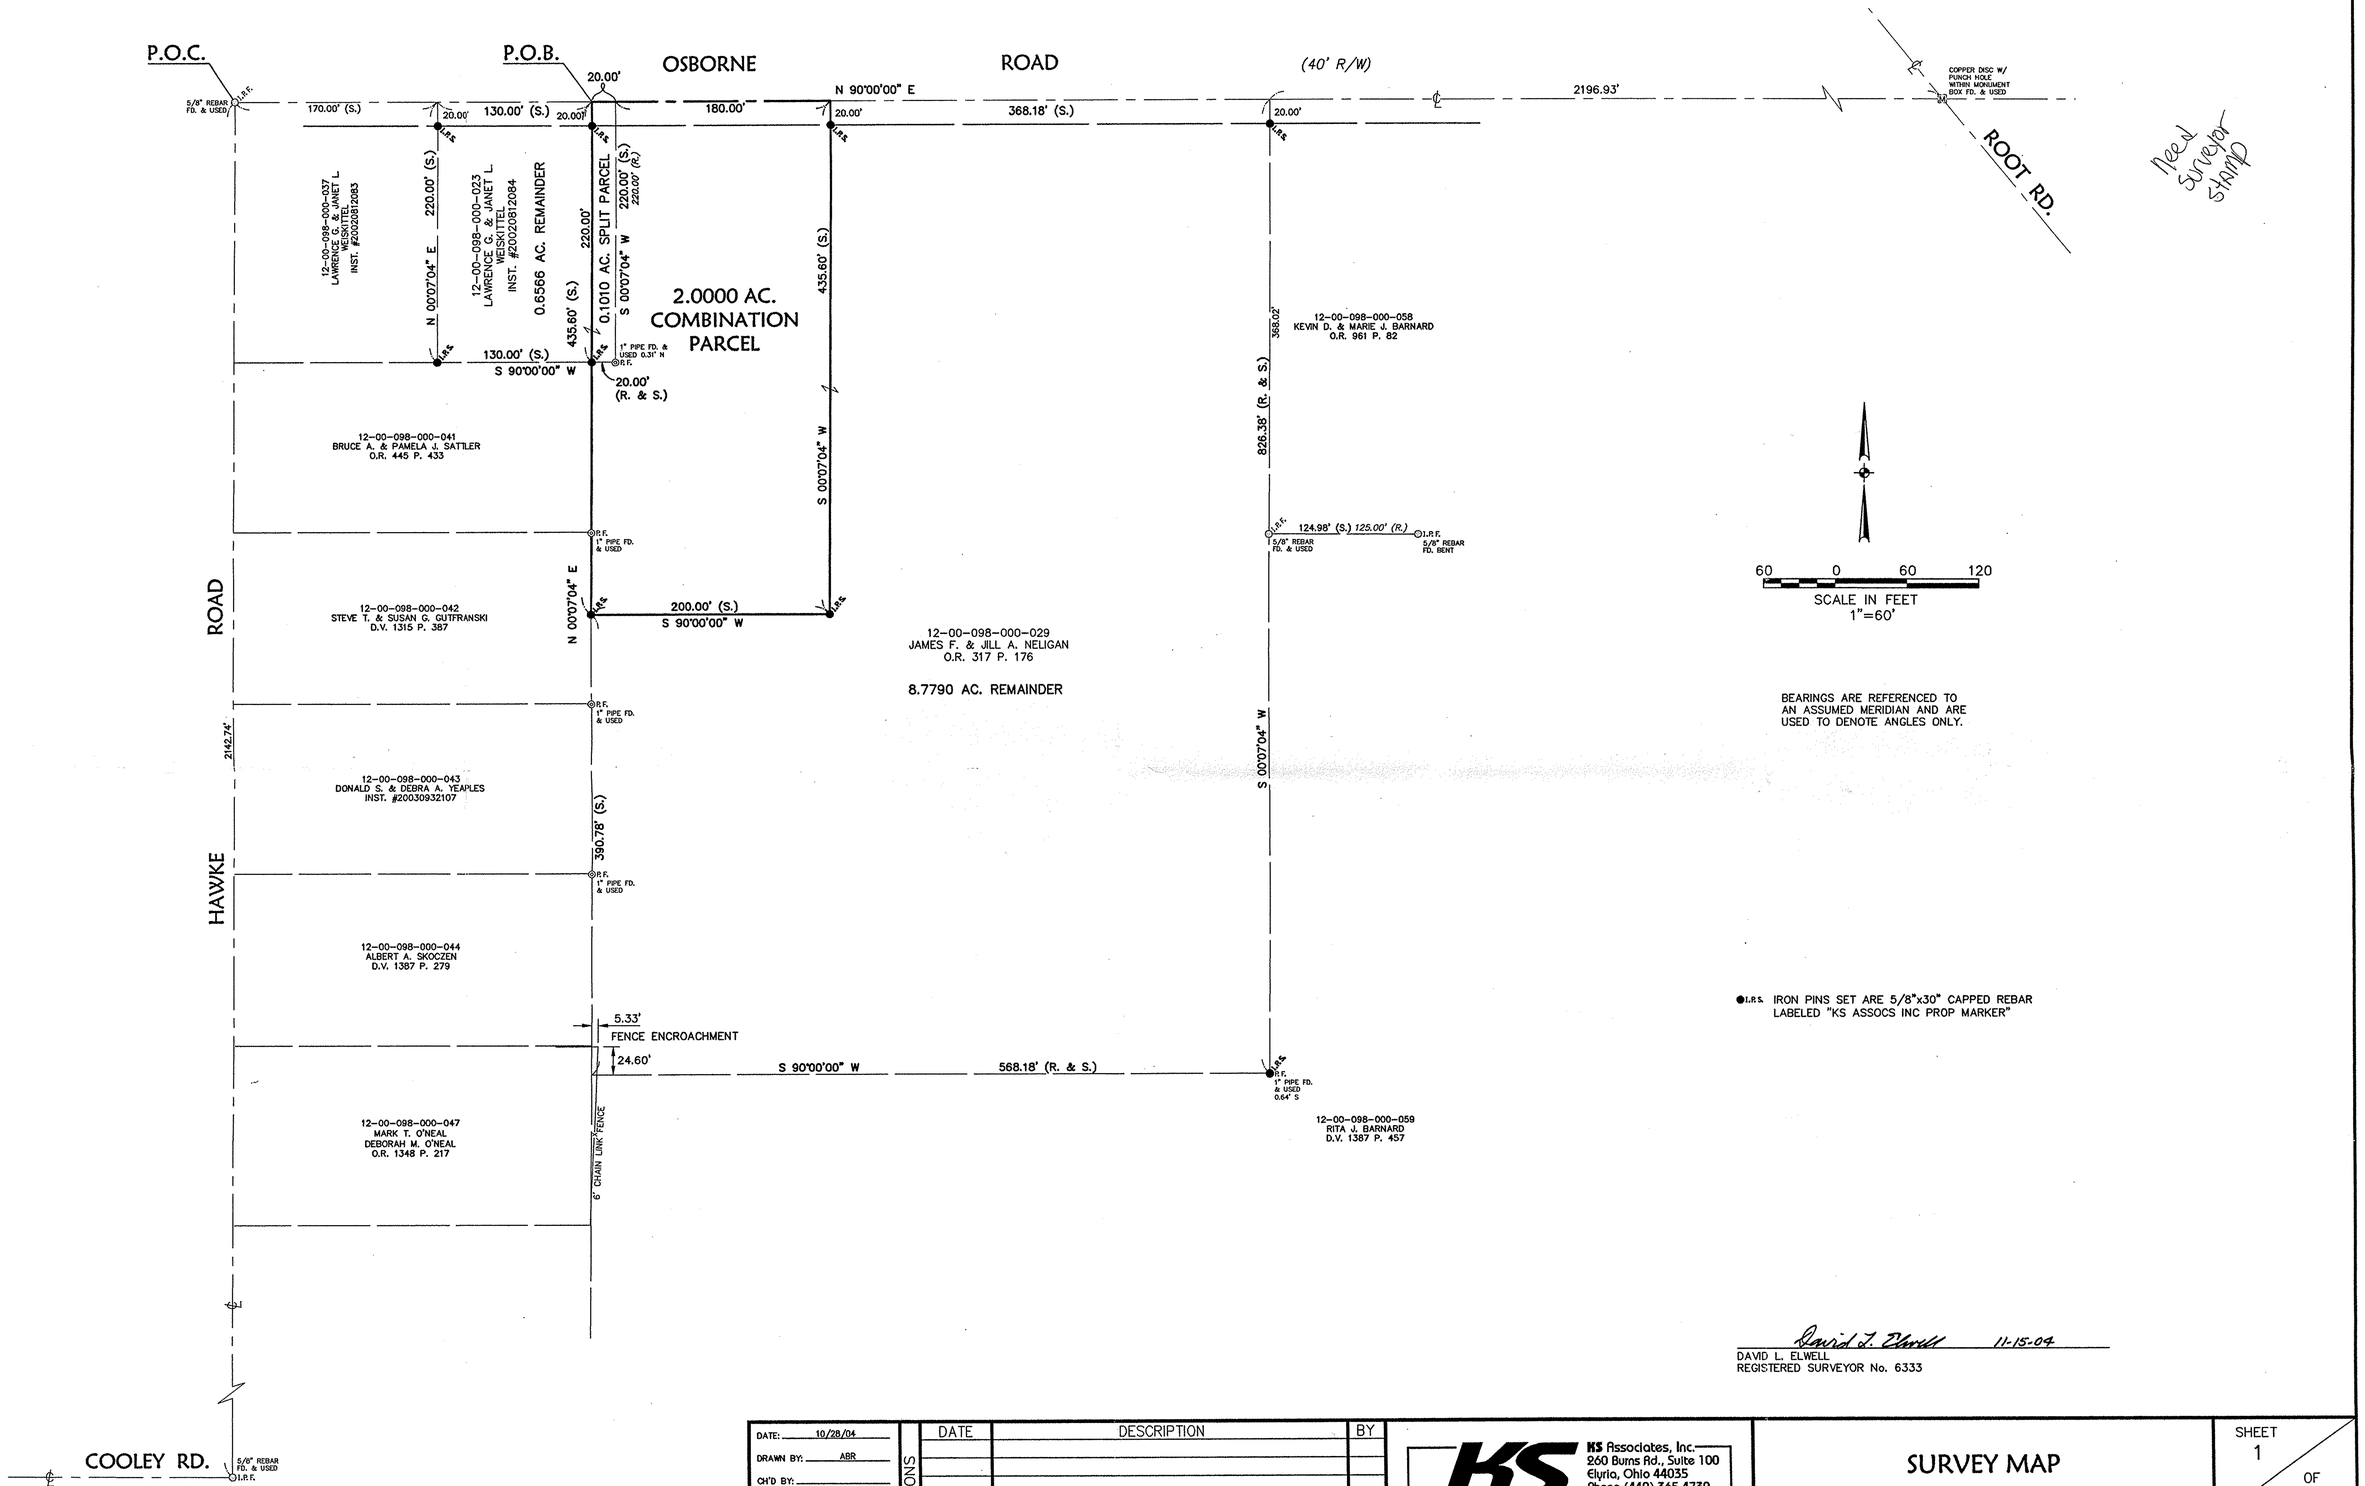

● I.R.S. IRON PINS SET ARE 5/8"x30" CAPPED REBAR LABELED "KS ASSOCS INC PROP MARKER"

David L. Elwell 11-15-04
DAVID L. ELWELL
REGISTERED SURVEYOR No. 6333

DATE:	10/28/04
DRAWN BY:	ABR
CH'D BY:	
DWG. NAME:	0-SURV01
PATH:	04271
F.B.	705

REVISIONS

DATE	DESCRIPTION	BY
11/12/04	ORIGINAL ISSUE	ABR

KS ASSOCIATES
KS Associates, Inc.
260 Burns Rd., Suite 100
Elyria, Ohio 44035
Phone (440) 365-4730
Fax (440) 365-4790
mailroom@ksassoc.com
www.ksassoc.com

SURVEY MAP

OF PART OF
ORIGINAL COLUMBIA TOWNSHIP LOT No. 98
TOWNSHIP OF COLUMBIA, COUNTY OF LORAIN, STATE OF OHIO

SHEET 1 OF 1

JOB NO. 04271