Will Send Good Map.

MAP OF SURVEY, LOT SPLIT AND ASSEMBLY

PREPARED FOR

RICHARD ST.JAMES

SITUATED IN THE CITY OF SHEFFIELD LAKE, COUNTY OF LORAIN, STATE OF OHIO AND BEING KNOWN AS PART OF ORIGINAL LOT NO.37. ALSO BEING KNOW AS ALL OF THOSE LANDS DEEDED TO RICK GAINES, AKA RICHARD StJAMES, IN DEED INSTRUMENT #990612605 OF LORAIN COUNTY DEED RECORDS.

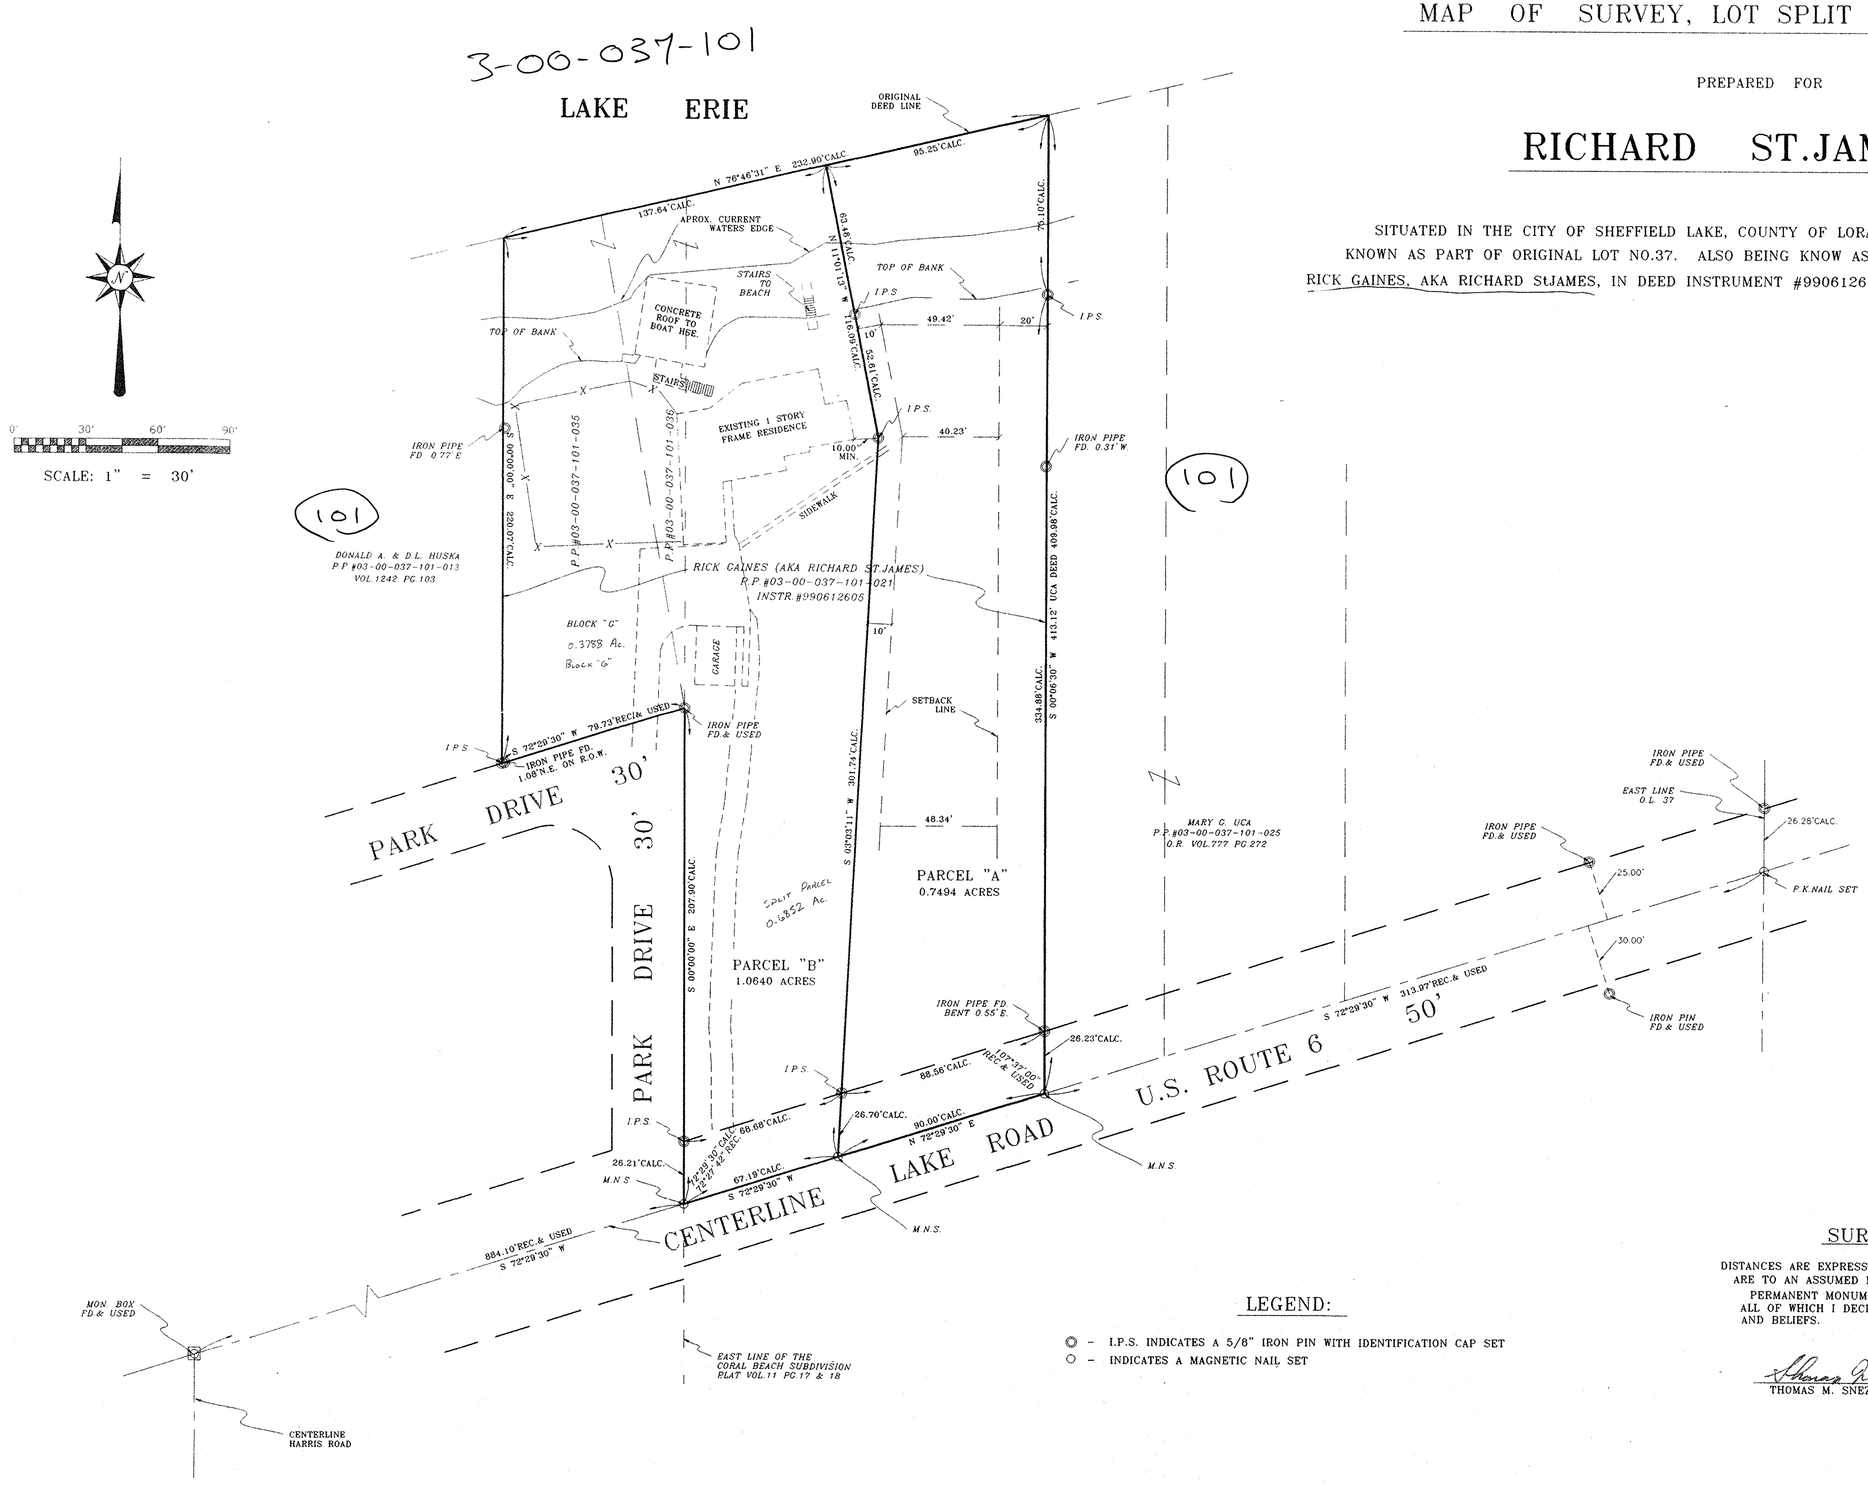

APPROVED
SHEFFIELD LAKE BUILDING DEPT.
X Chief Building Inspector

SURVEYOR'S STATEMENT

DISTANCES ARE EXPRESSED IN FEET AND DECIMAL PARTS THEREOF. BEARINGS ARE TO AN ASSUMED MERIDIAN AND ARE USED TO INDICATE ANGLES ONLY. PERMANENT MONUMENTS WERE FOUND OR SET AS INDICATED HEREON. ALL OF WHICH I DECLARE TO BE CORRECT TO THE BEST OF MY ABILITIES AND BELIEFS.

Thomas M. Snezek 9-13-04
THOMAS M. SNEZEK, R.L.S. 7051 DATE

STATE OF OHIO THOMAS M. SNEZEK S-7051 SURVEYOR

LEGEND:

◎ - I.P.S. INDICATES A 5/8" IRON PIN WITH IDENTIFICATION CAP SET
○ - INDICATES A MAGNETIC NAIL SET

3-00-037-A

FINAL LAYOUT 08-30-04
REV. LAYOUT"B" 08-02-04
PROJ.#0319 08-07-03