.A 144
6-97

06-24-026-114-

PENFIELD AVE. 66'

1"=50'

LOWELL STREET 66'

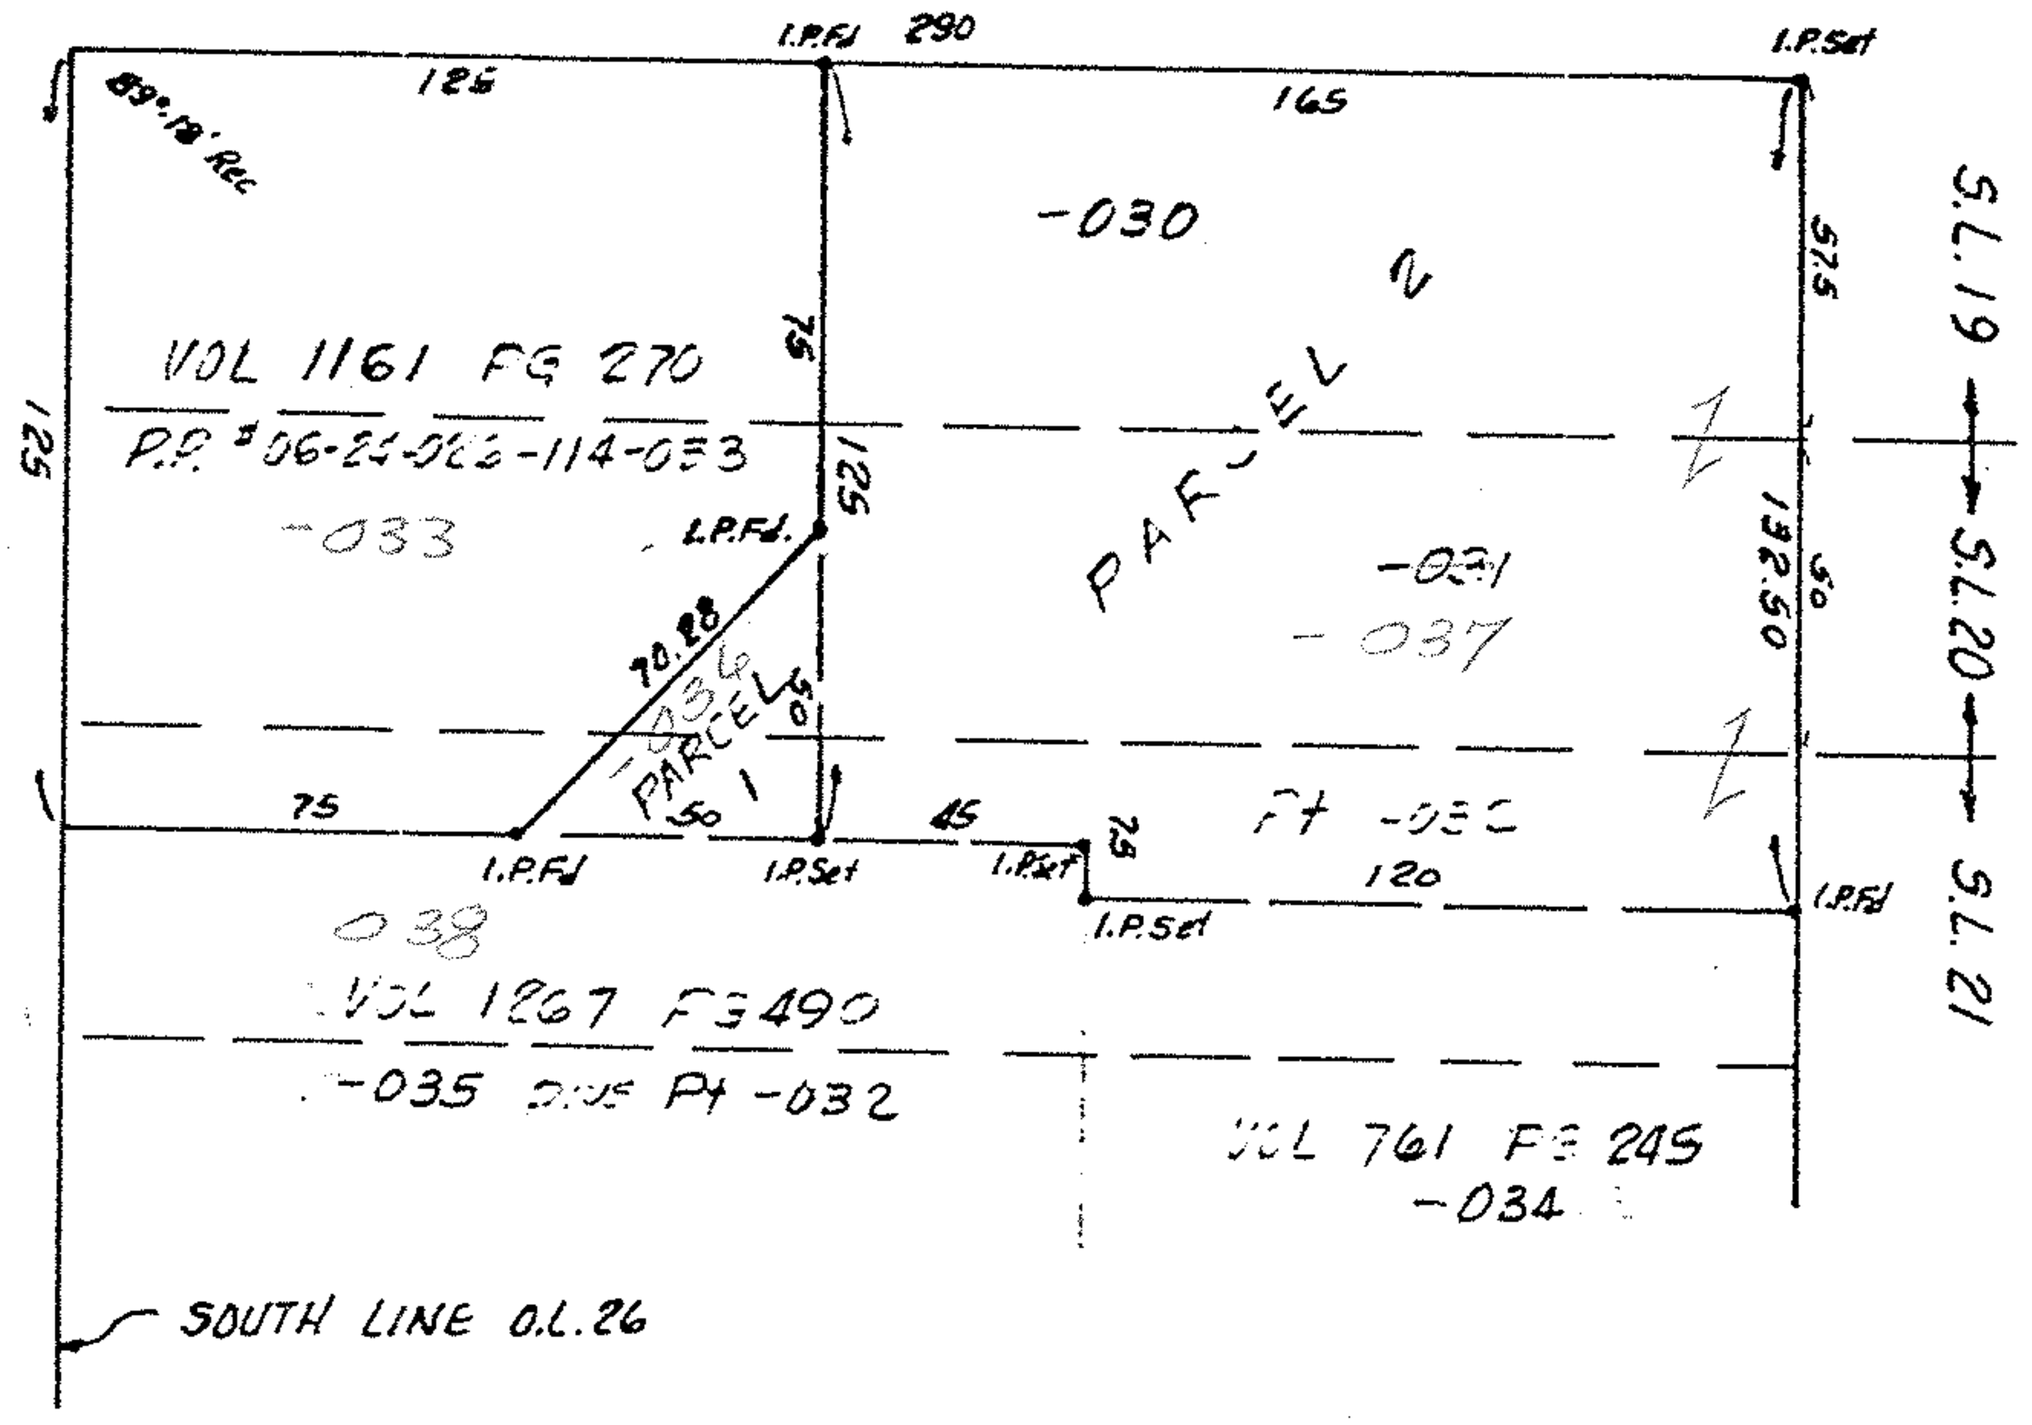

APPROVED
LORAIN CO.
MAP DEPT.
DATE 6-30-82
PAGE 6-97
BY C.L. Francis
VOID

06-24-026-114-037,038,033,036

PREPARED FOR: LEONARD WHITE
917 LOWELL ST.
ELYRIA, OHIO

SUBLOTS #19 & 20 PLUS part of
SUBLOT #21 of BANNON ALLOTMENT NO.1

PLAT VOL. 14 PAGE 19
PART of ORIG. ELYRIA TWP. LOT 26-WEST of RIVER
NOW in CITY of ELYRIA ,OHIO

THIS IS A PLAT OF SURVEY:

McGLINCHY & ASSOCIATES INC.

APRIL 1982 #827170