06-24-021-000-031, 073, 064, 063, 075

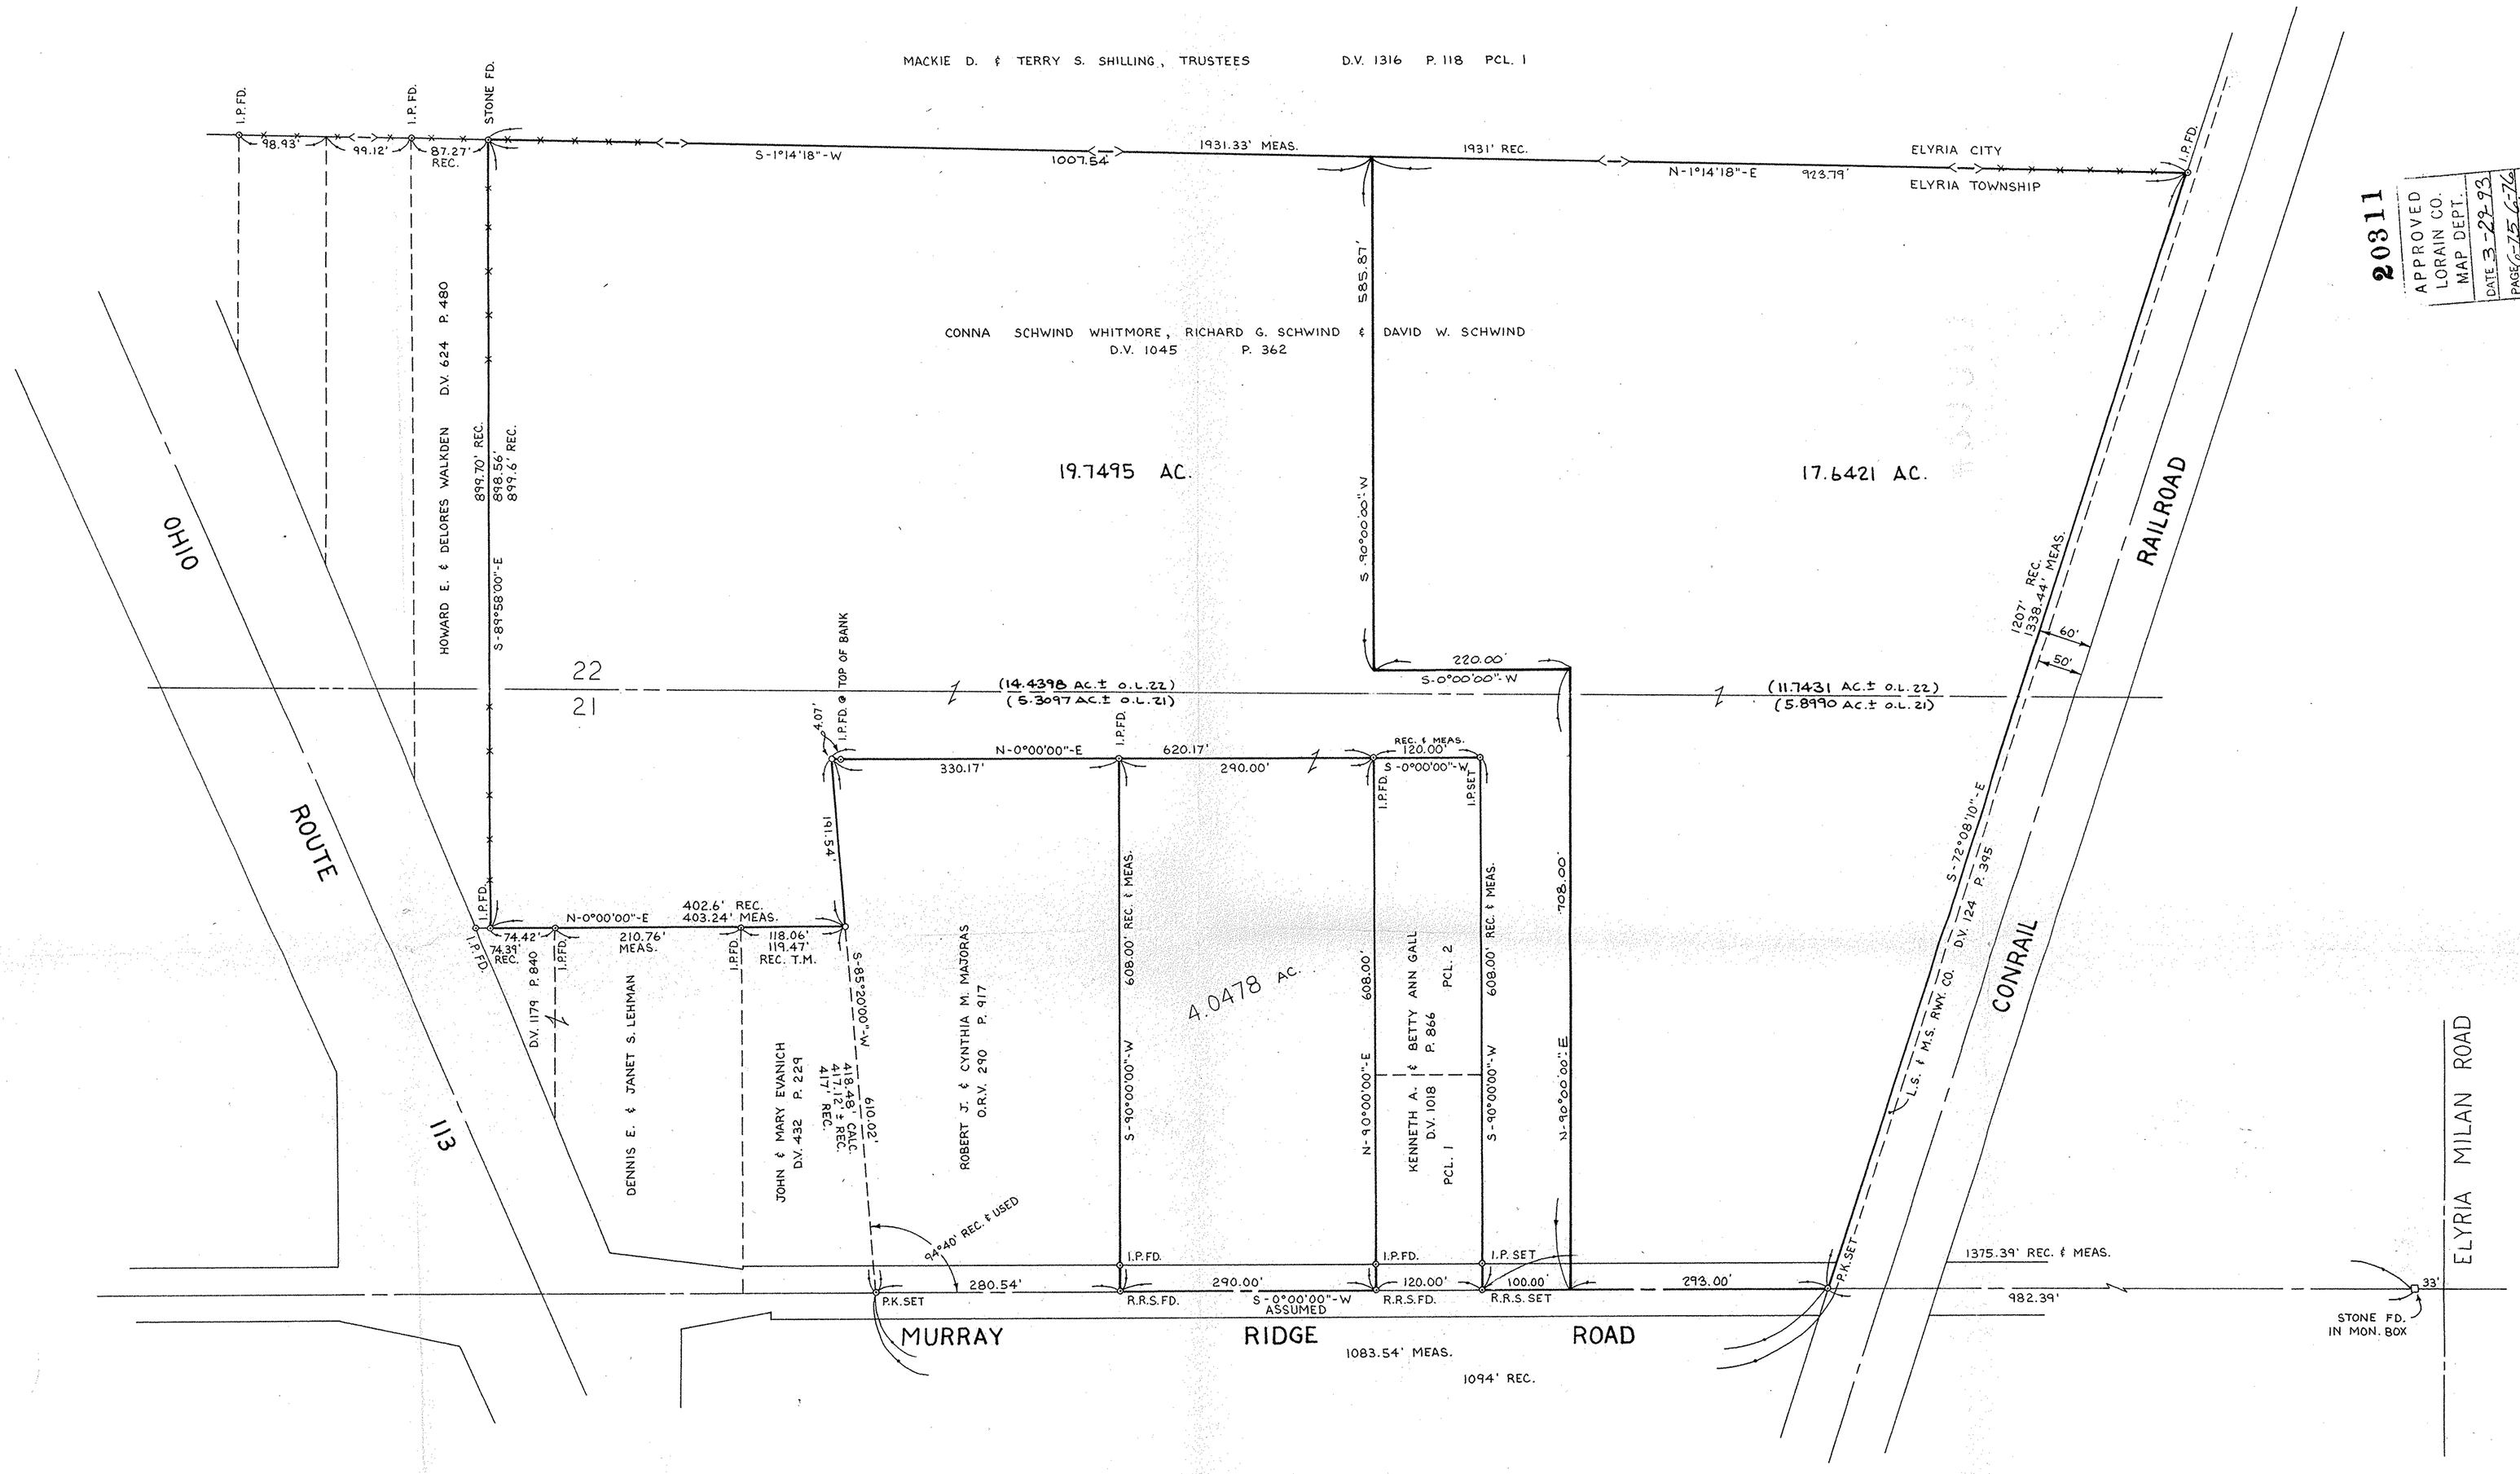

20311
APPROVED
LORAIN CO.
MAP DEPT.
DATE 3-22-93
PAGE 6-15-76
BY CAROLYN FRANCIS
VOID AFTER #20311

06-24-021-000 -
06-24-022-000

BOUNDARY SURVEY

OF PART OF

ELYRIA TOWNSHIP ORIGINAL LOTS NOS. 21 & 22

WEST OF THE BLACK RIVER

TWP. OF ELYRIA · COUNTY OF LORAIN · STATE OF OHIO

NORTH

0 50 100 200 300

SCALE: 1" = 100'

PREPARED BY:
KS ASSOCIATES INC.
ENGINEERS · SURVEYORS

David L. Elwell
DAVID L. ELWELL REG. SURVEYOR NO. 6333
DEC. 14, 1990
REV. FEB. 12, 1993

STATE OF OHIO
DAVID L. ELWELL
6333
REGISTERED SURVEYOR

87-81 A