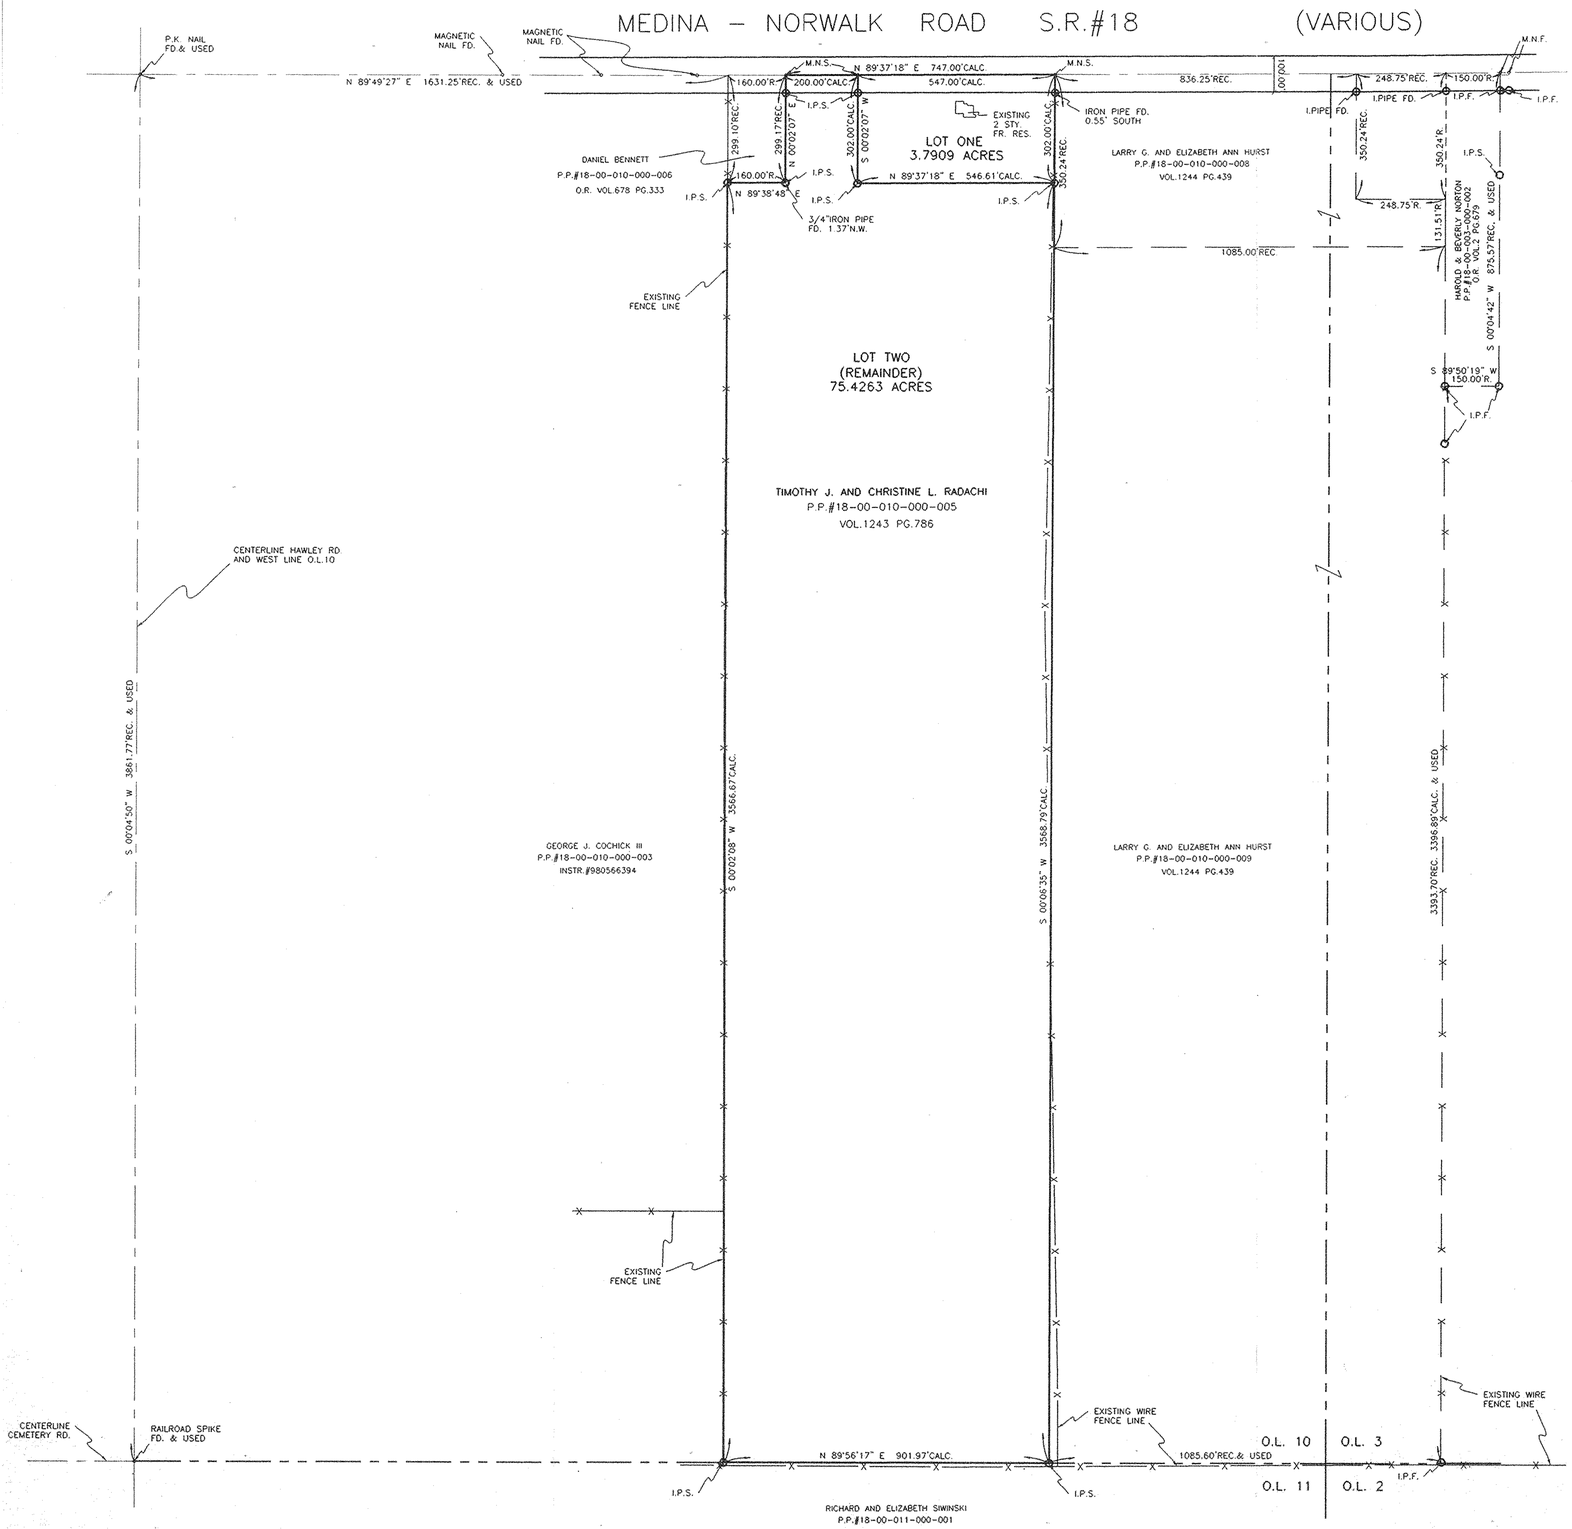

MAP OF SURVEY AND LOT SPLIT

PREPARED FOR

TIMOTHY J. AND CHRISTINE L. RADACHI

SITUATED IN THE TOWNSHIP OF WELLINGTON, COUNTY OF LORAIN, STATE OF OHIO AND BEING KNOWN AS PART OF ORIGINAL WELLINTON TOWNSHIP LOT 10 AND BEING ALL OFF THOSE LANDS DEEDED TO TIMOTHY J. AND CHRISTINE L. RADACHI IN DEED VOLUME 1243, PAGE 786 OF LORAIN COUNTY DEED RECORDS.

SCALE: 1" = 200'

No 01851

2/10/05
18-00-010-B
JHAtfield
#05-01851

SURVEYOR'S STATEMENT

DISTANCES ARE EXPRESSED IN FEET AND DECIMAL PARTS THEREOF. BEARINGS ARE TO AN ASSUMED MERIDIAN AND ARE USED TO INDICATE ANGLES ONLY. PERMANENT MONUMENTS WERE FOUND OR SET AS INDICATED HEREON. —O— I.P.S. INDICATES 5/8" IRON PIN WITH CAP SET. —•— M.N.S. INDICATES A MAGNETIC NAIL SET. ALL OF WHICH I DECLARE TO BE CORRECT TO THE BEST OF MY ABILITY AND BELIEF.

Thomas M. Snezek
THOMAS M. SNEZEK, R.L.S. NO.7051

1-24-05
DATE

STATE OF OHIO
THOMAS M. SNEZEK
S-7051
SURVEYOR

REVISED 01/24/05
#0423 12/06/04