SURVEY

OF

12.017 ACRES

OF PART OF

ORIGINAL AVON TOWNSHIP SECTION NO. 19
NOW IN THE CITY OF AVON LAKE
LORAIN COUNTY, OHIO

FOR

MARGAM INVESTMENT LTD.

BY

THE HENRY G. REITZ ENGINEERING COMPANY
4214 ROCKY RIVER DRIVE, CLEVELAND, OH. 44135
PHONE: (216) 251-3033 FAX: (216) 251-5149
BY _____ VICE PRES.
JAMES T. SAYLER, REG. SURVEYOR NO. S-7425

SCALE: 1" = 60' OCTOBER, 2004

ADDED SPLIT DIMENSIONS & AREAS: 11/19/2004

STATE OF OHIO
JAMES T. SAYLER
S-7425
REGISTERED
PROFESSIONAL SURVEYOR

N

BASED ON JAYCOX ROAD BEARING N01°46'00"W

GRAPHIC SCALE

0 30 60 80 120

SCALE: 1" = 60'

LEGEND

O DENOTES 5/8" CAPPED (REITZ ENG.) IRON PIN SET

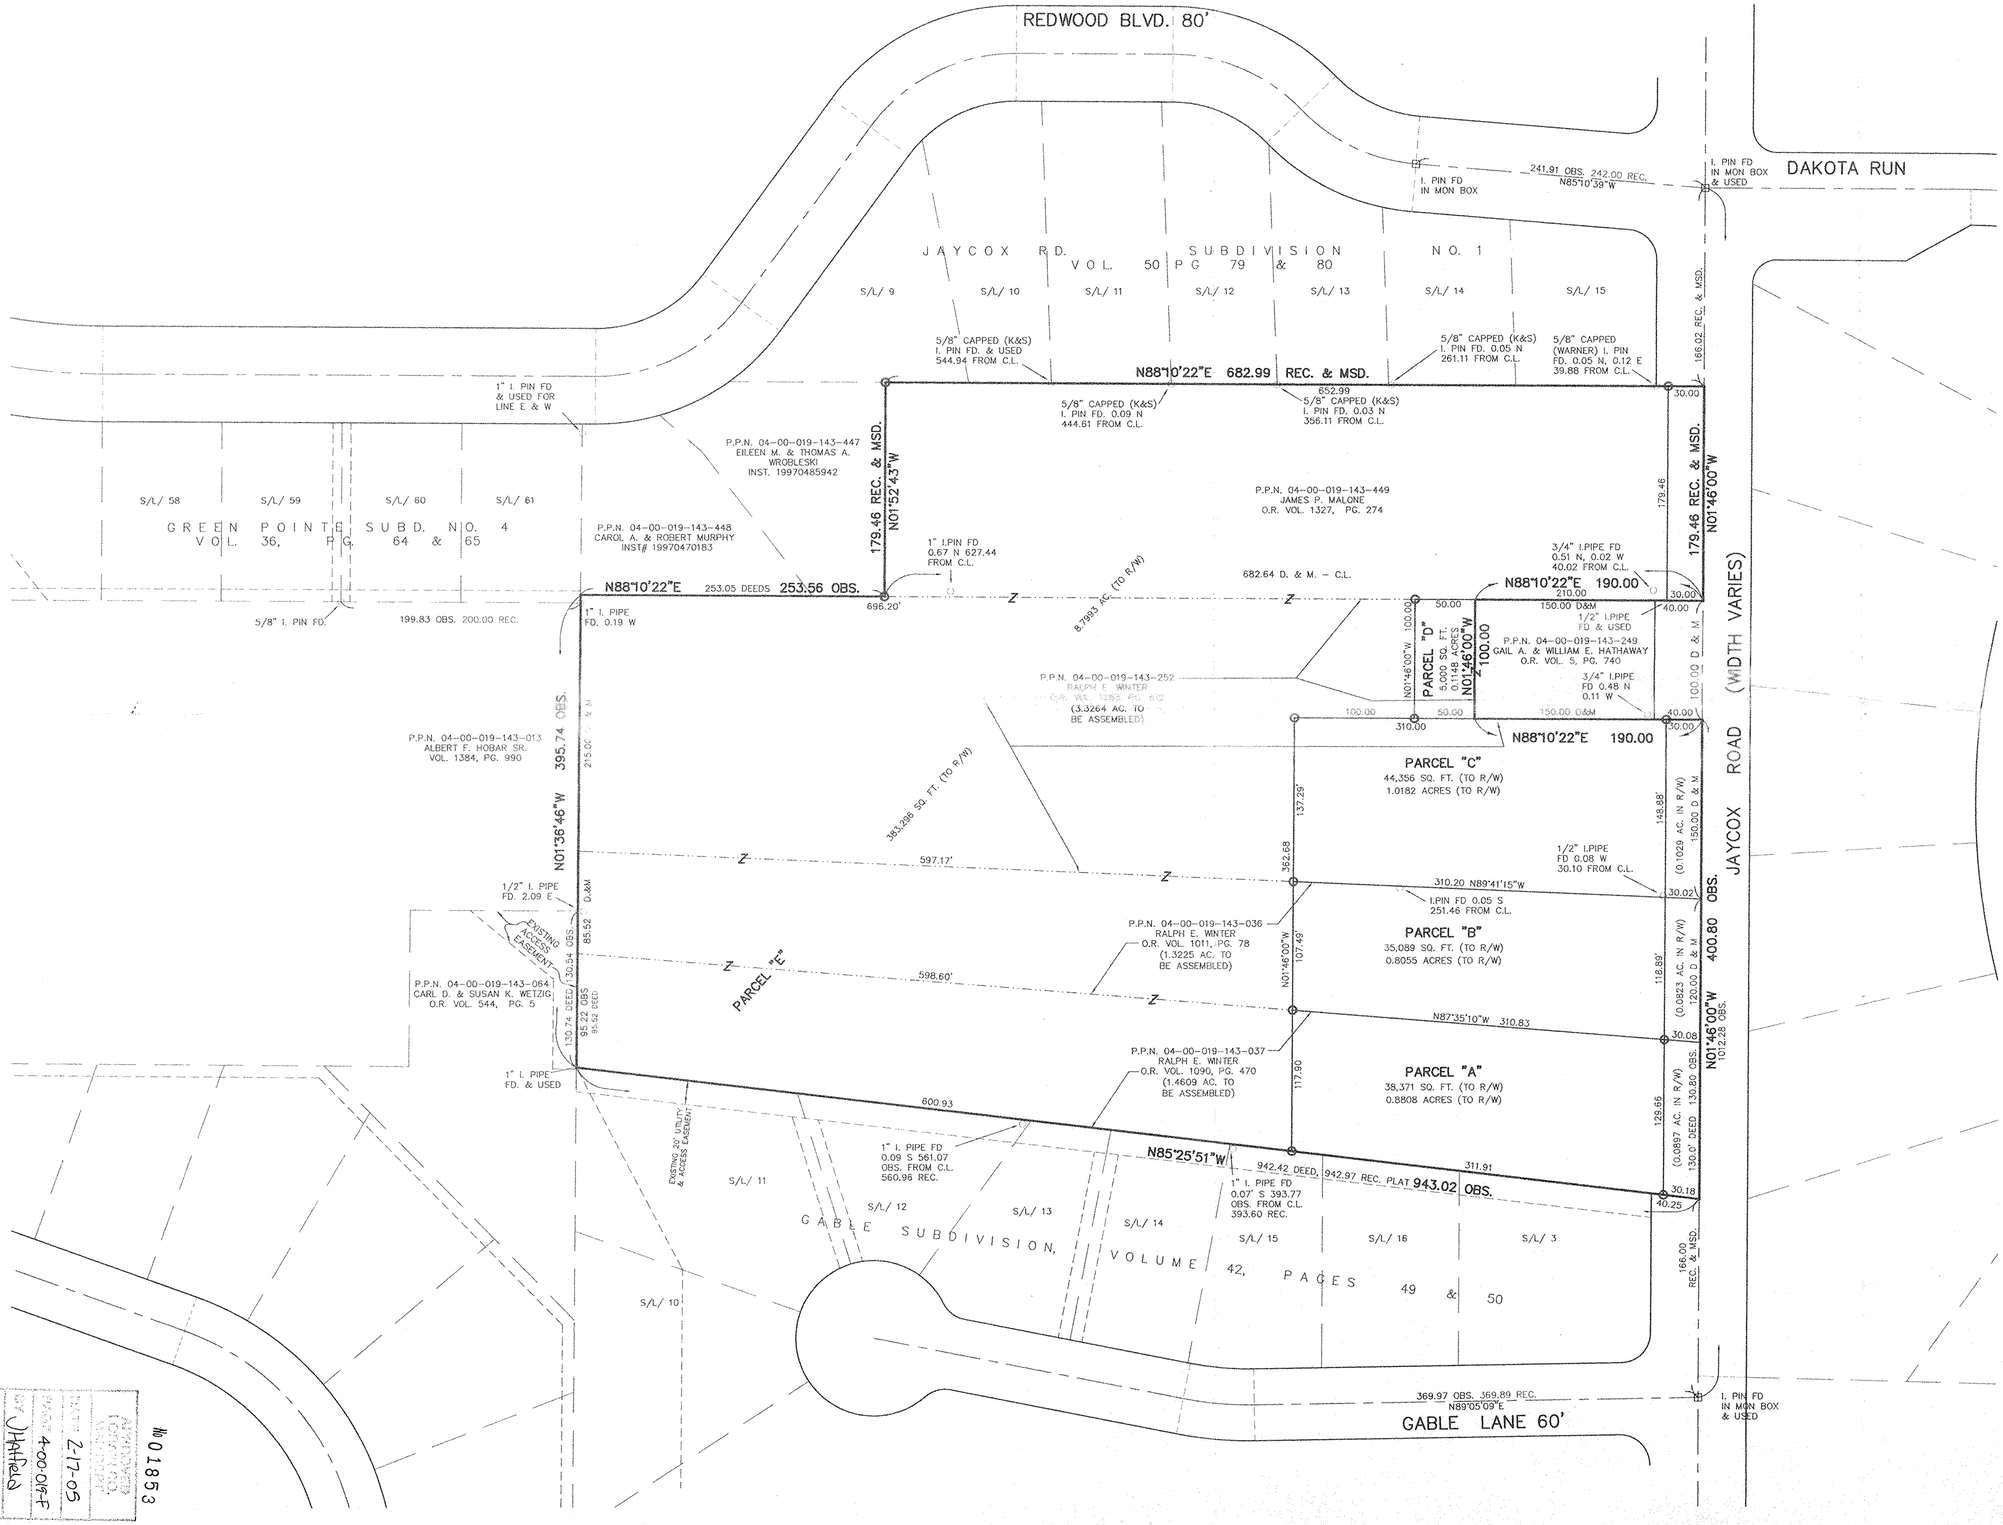

APPROVED
CITY OF AVON LAKE
DATE: 2-17-05
PARCEL: 4-00-019-F
BY: J Hatfield
#05-01853

#01853