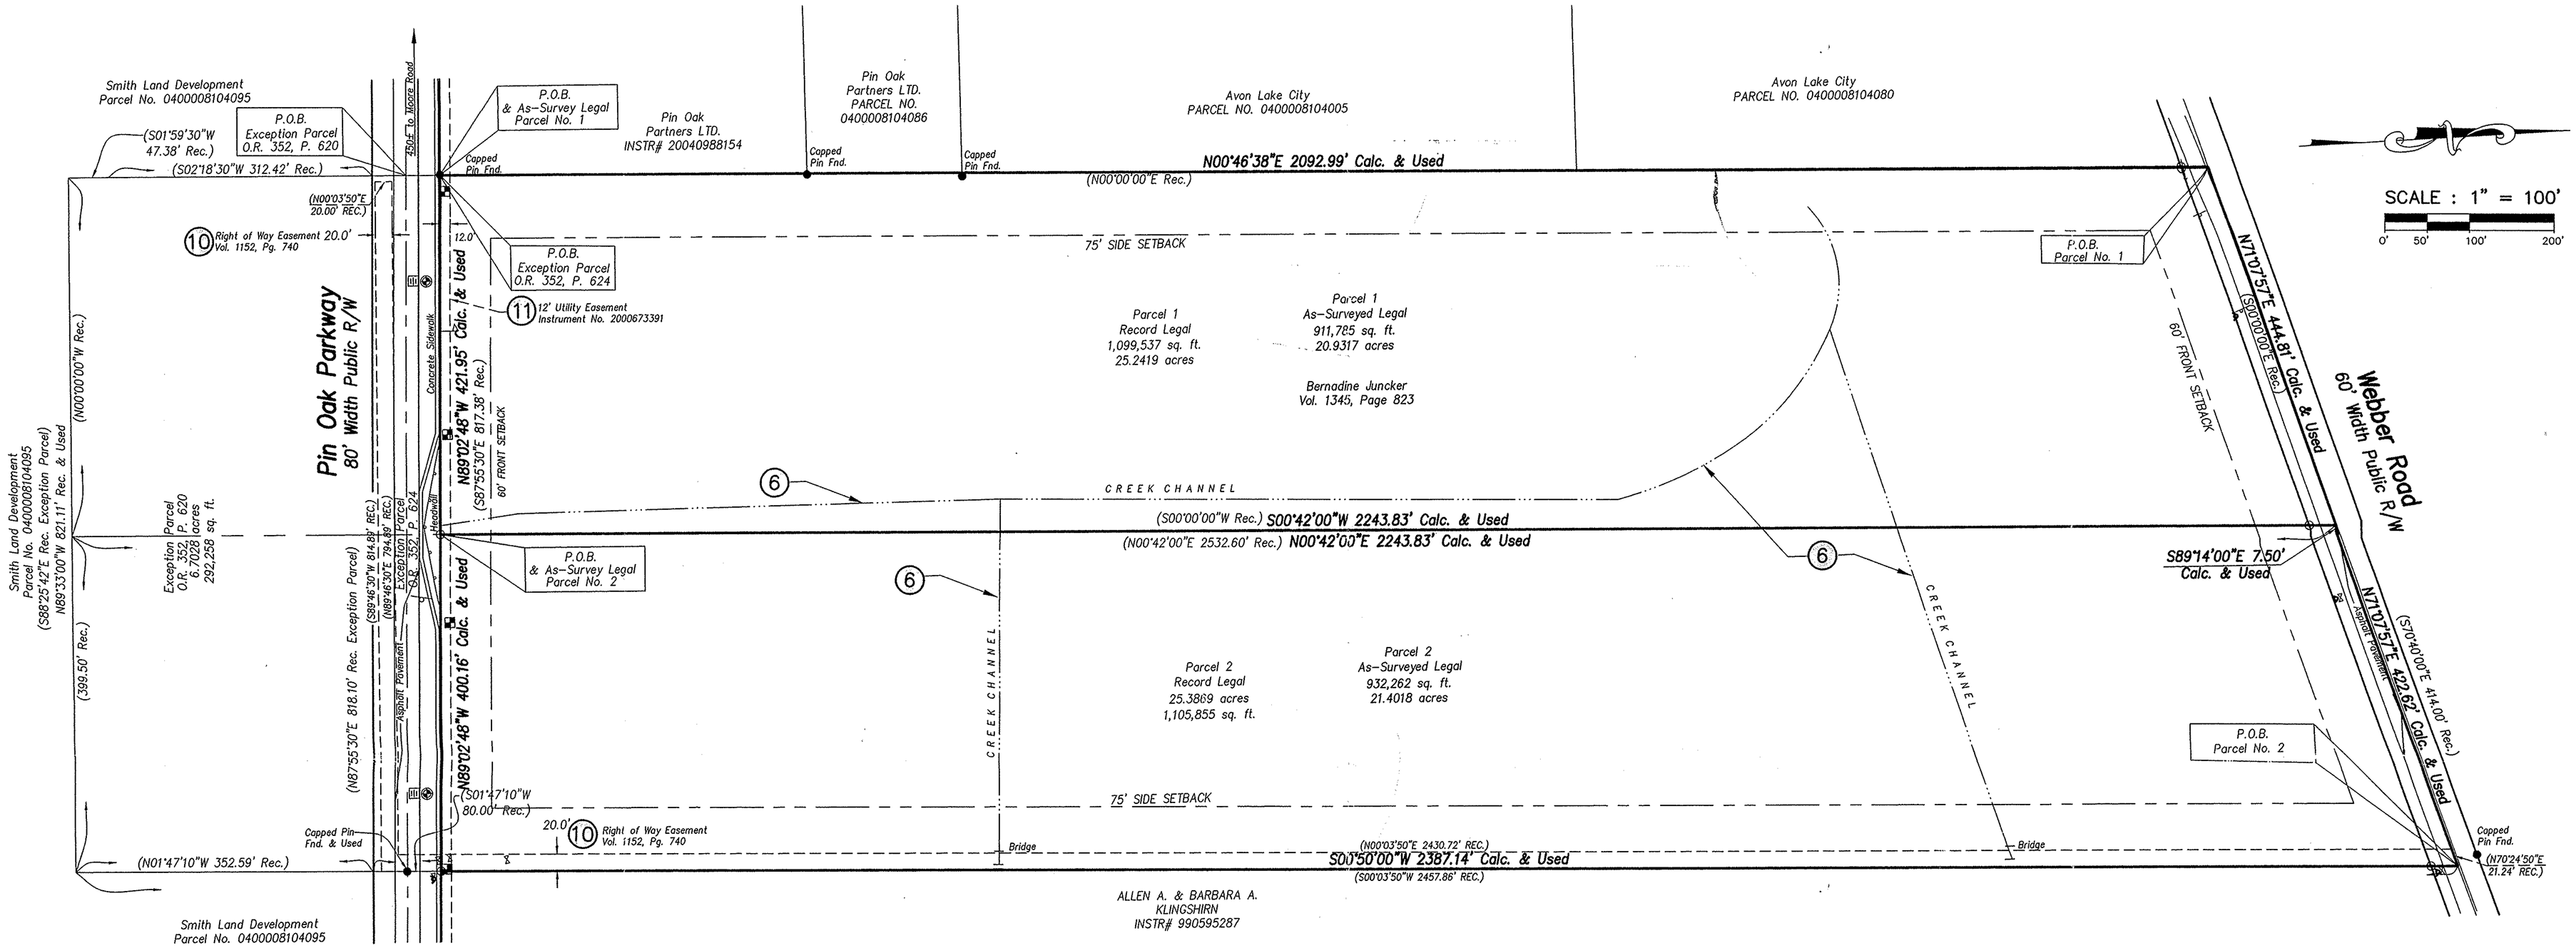

Legend of Symbols & Abbreviations

- Power Pole
- Power Pole w/Light
- Light Pole
- Traffic Pole
- Guy Wire
- Sight Light
- Ground Light
- Electric Manhole
- Telephone Manhole
- Telephone Pedistal
- Electric Meter
- Cable Box
- Air Conditioner Unit
- Baluster
- Flag Pole
- Sign (As Noted)
- Well Head
- Satelite Dish
- Tower
- Water Valve
- Fire Hydrant
- Siamese Fire Hydrant
- Water Manhole
- Water Meter Pit
- Water Meter
- Sprinkler Head
- Indicates Handicapped Parking
- Storm Manhole
- Storm Inlet (Square)
- Storm Inlet (Round)
- Curb Storm Inlet
- Storm Pipe
- Sanitary Sewer
- Sanitary Clean Out
- Gas Valve
- Gas Manhole
- Gas Meter
- Gas Marker
- Indicates Mutual Ownership
- Tree (As Noted)

N.	North	Ft.	Feet
S.	South	Vol.	Volume
E.	East	Pg.	Page
W.	West	O.R.	Official Record
°	Degrees	Calc.	Calculated
'	Feet or Minutes	Rec.	Record
"	Inches or Seconds	R/W	Right of Way
Sq.	Square	C/L	Centerline

Bock & Clark's National Surveyors Network
National Coordinators of ALTA/ACSM Land Title Surveys
537 North Cleveland-Massillon Road Akron, Ohio 44333
Phone: (800) Surveys, Fax: (330) 666-3608 www.1800surveys.com

ALTA/ACSM LAND TITLE SURVEY

PREPARED FOR:

Juncker Project

DATE: 10/21/2004
Project No. 20040941-1

Sheet 2 of 2