



000-220-00-21

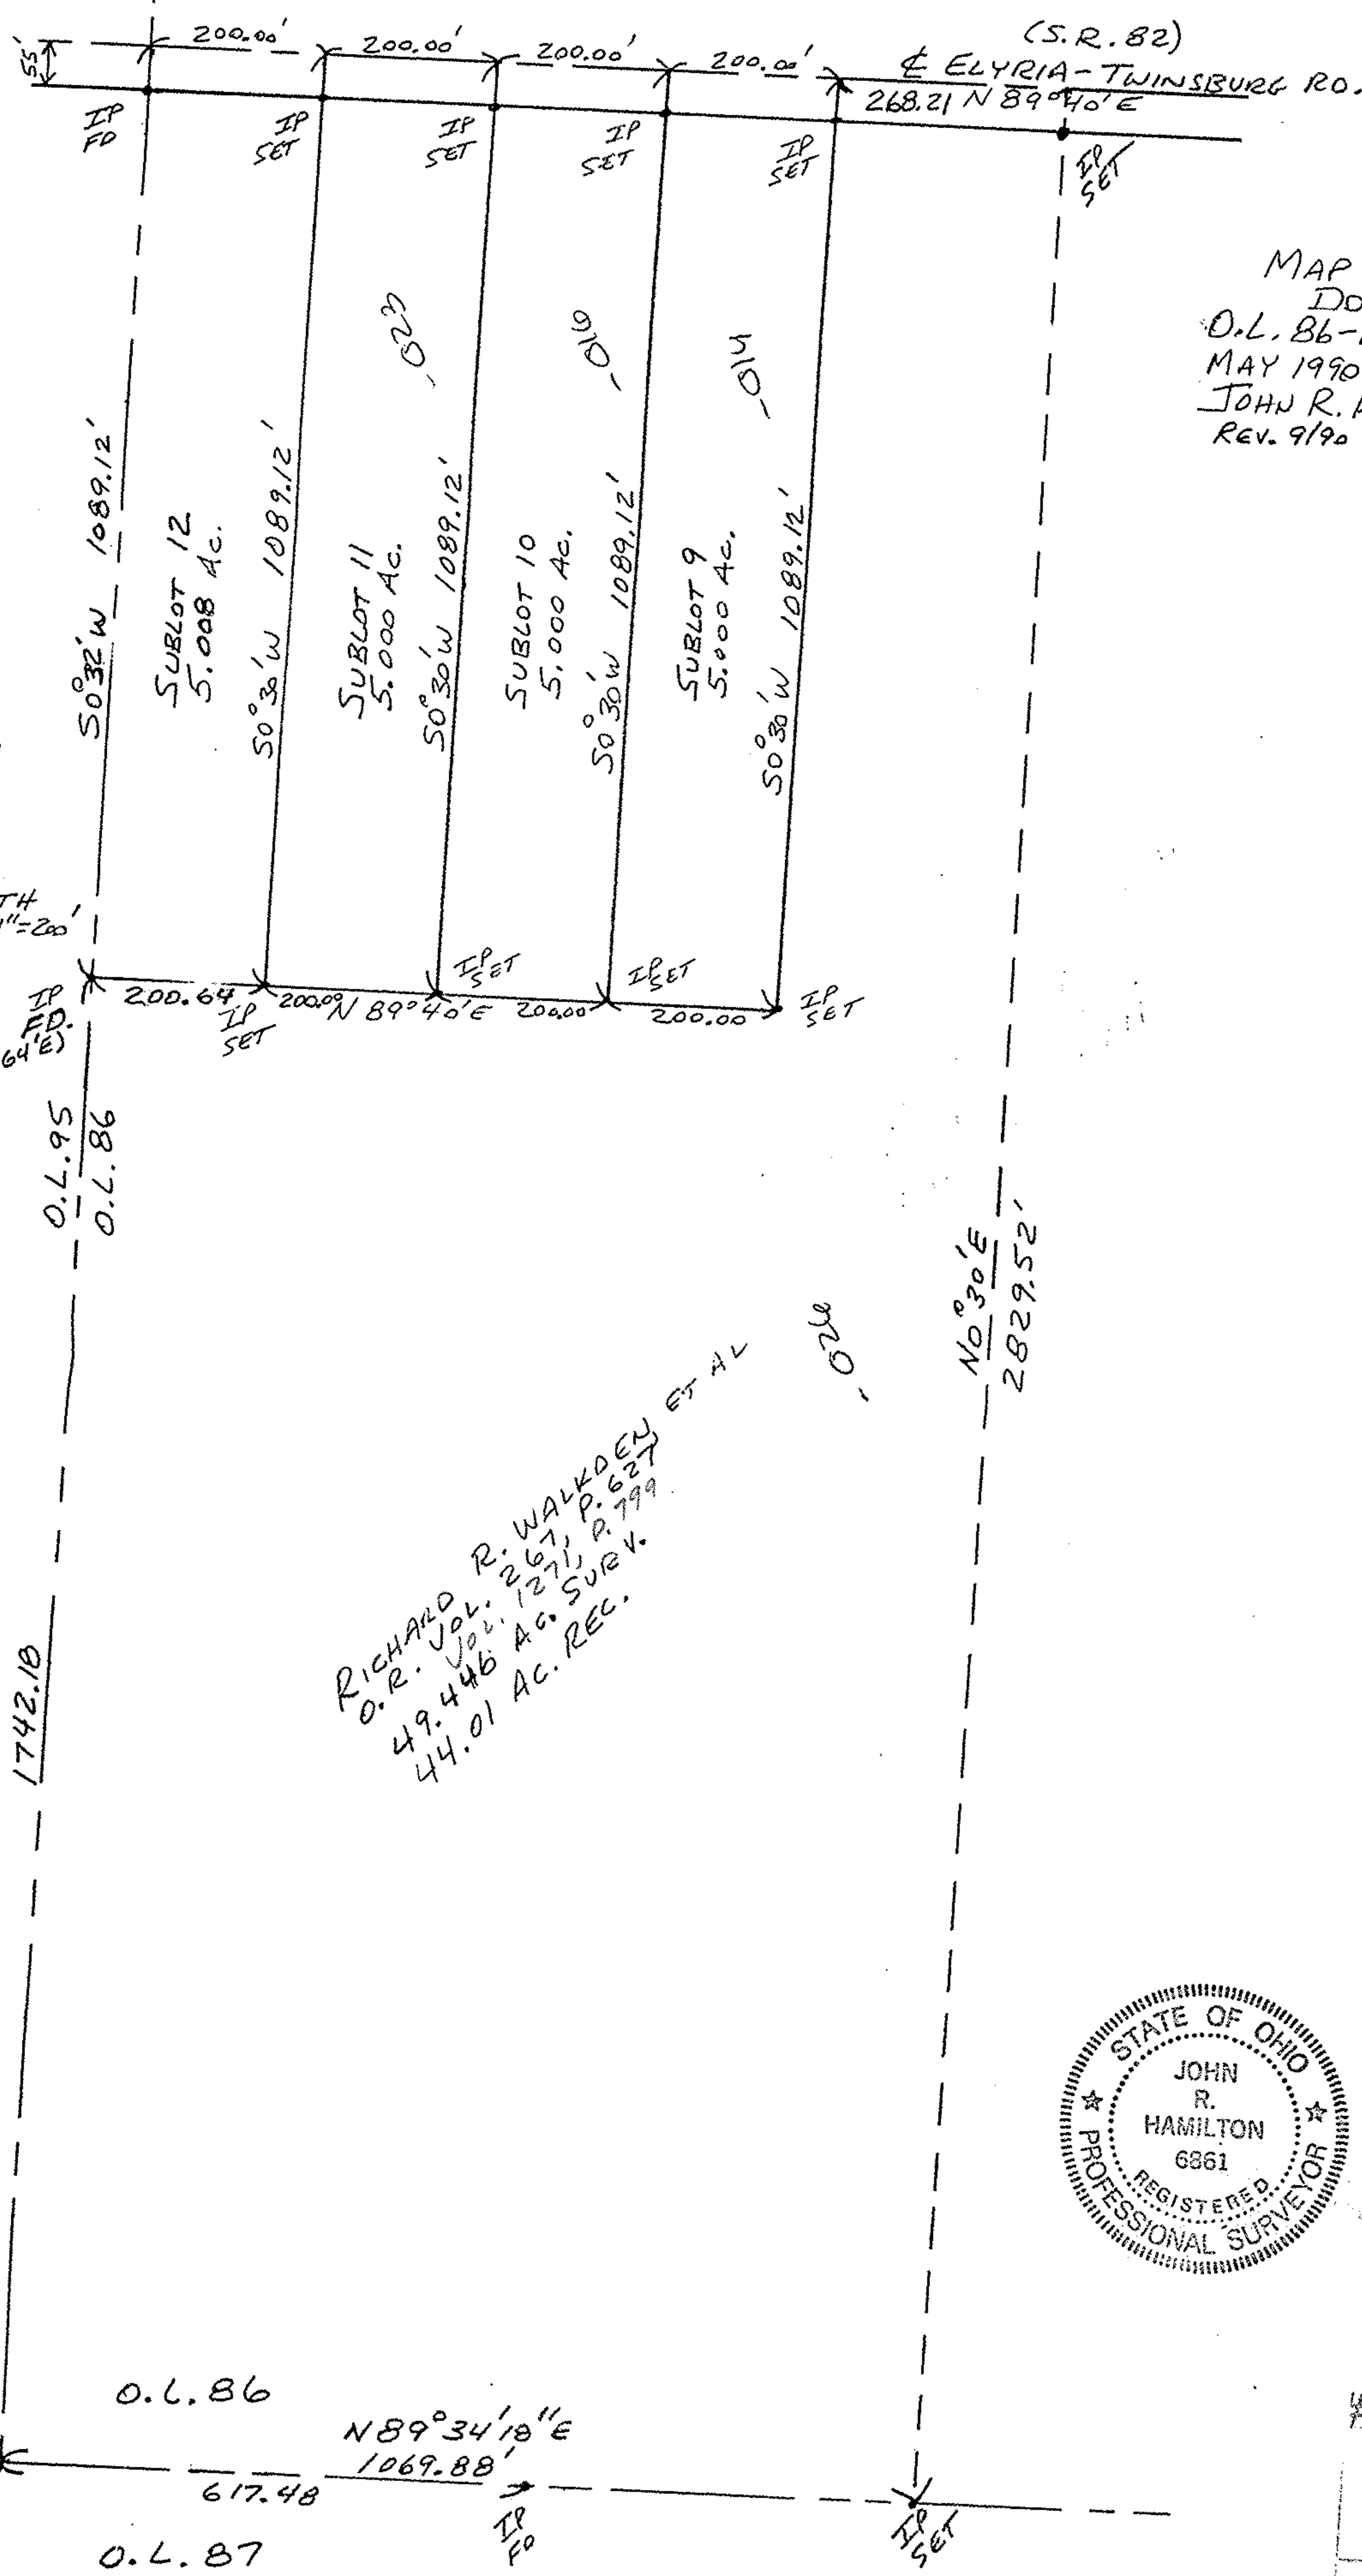

MAP OF SURVEY FOR  
 DOUG KEYSE  
 O.L. 86-COLUMBIA TWP-LORAIN Co.  
 MAY 1990 SCALE 1"=200'  
 JOHN R. HAMILTON-REG. SURV. #6861  
 REV. 9/90 REMAINDER

RICHARD R. WALKDEN ET AL  
 O.R. Vol. 2267, P. 627  
 49.446 AC. SURV. 1271, P. 799  
 44.01 AC. REC.

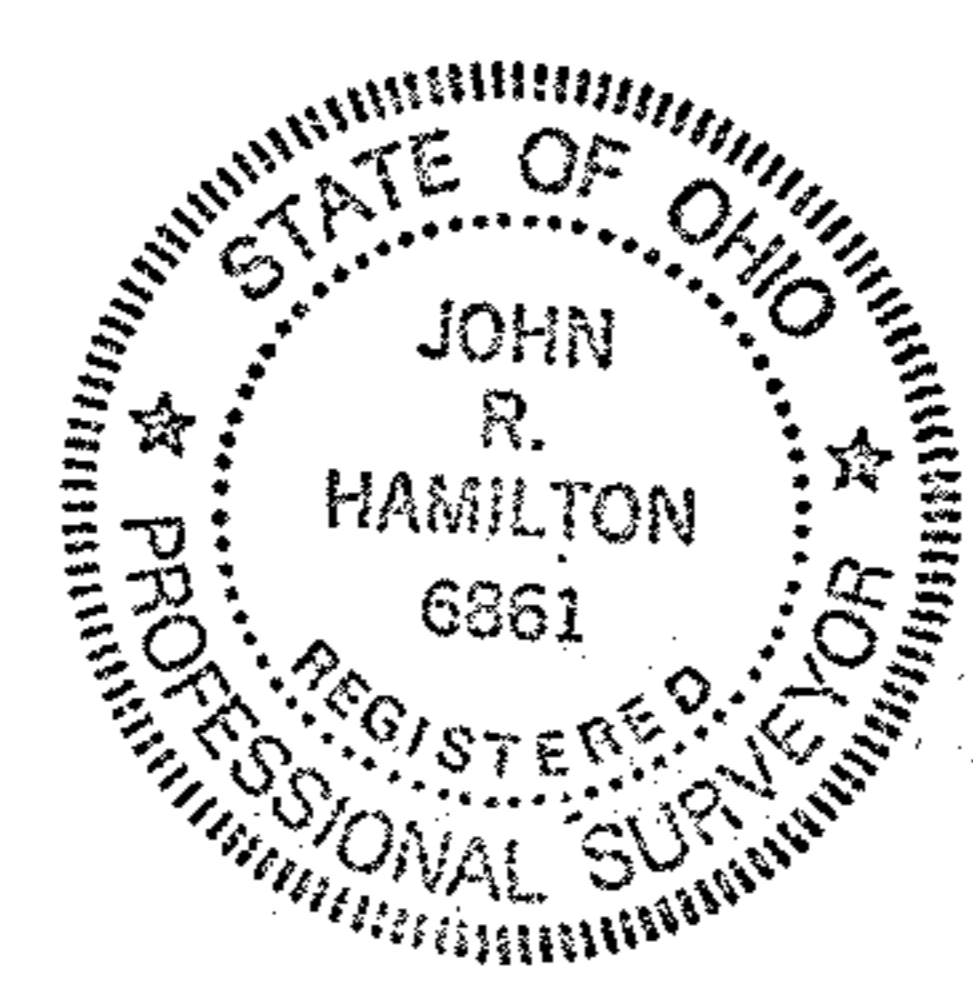

#19266

APPROVED
LORAIN CO.
MAP DEPT.
DATE 1-30-91
PAGE 12-E
BY CAROLYN FRANCIS
VOID AFTER #19266

NORTH  
 SCALE 1"=200'

0.L. 95  
 0.L. 86

1742.10

0.L. 86  
 617.48  
 0.L. 87

N 89°34'10"E  
 1069.88'

0°30'E  
 2829.52'