SURVEY

OF PART OF

ORIGINAL RIDGVILLE TWP. LOT 24

CITY OF N. RIDGEVILLE COUNTY OF LORAIN

STATE OF OHIO

PREPARED BY:

HAPONEK AND ASSOC.
SURVEYORS
N. RIDGEVILLE, OH

STATE OF OHIO
DANE A. HAPONEK
S-6314
REGISTERED SURVEYOR

PREPARED FOR:

BERNARD W. AND NANCY L. FATE
35541 BUTTERNUT RIDGE ROAD
N. RIDGEVILLE, OH.

NOTE: SURVEY BASED ON McGLINCHY SURVEY OR 707 P. 418

DATE: DEC. 1998
SCALE: 1" = 100'

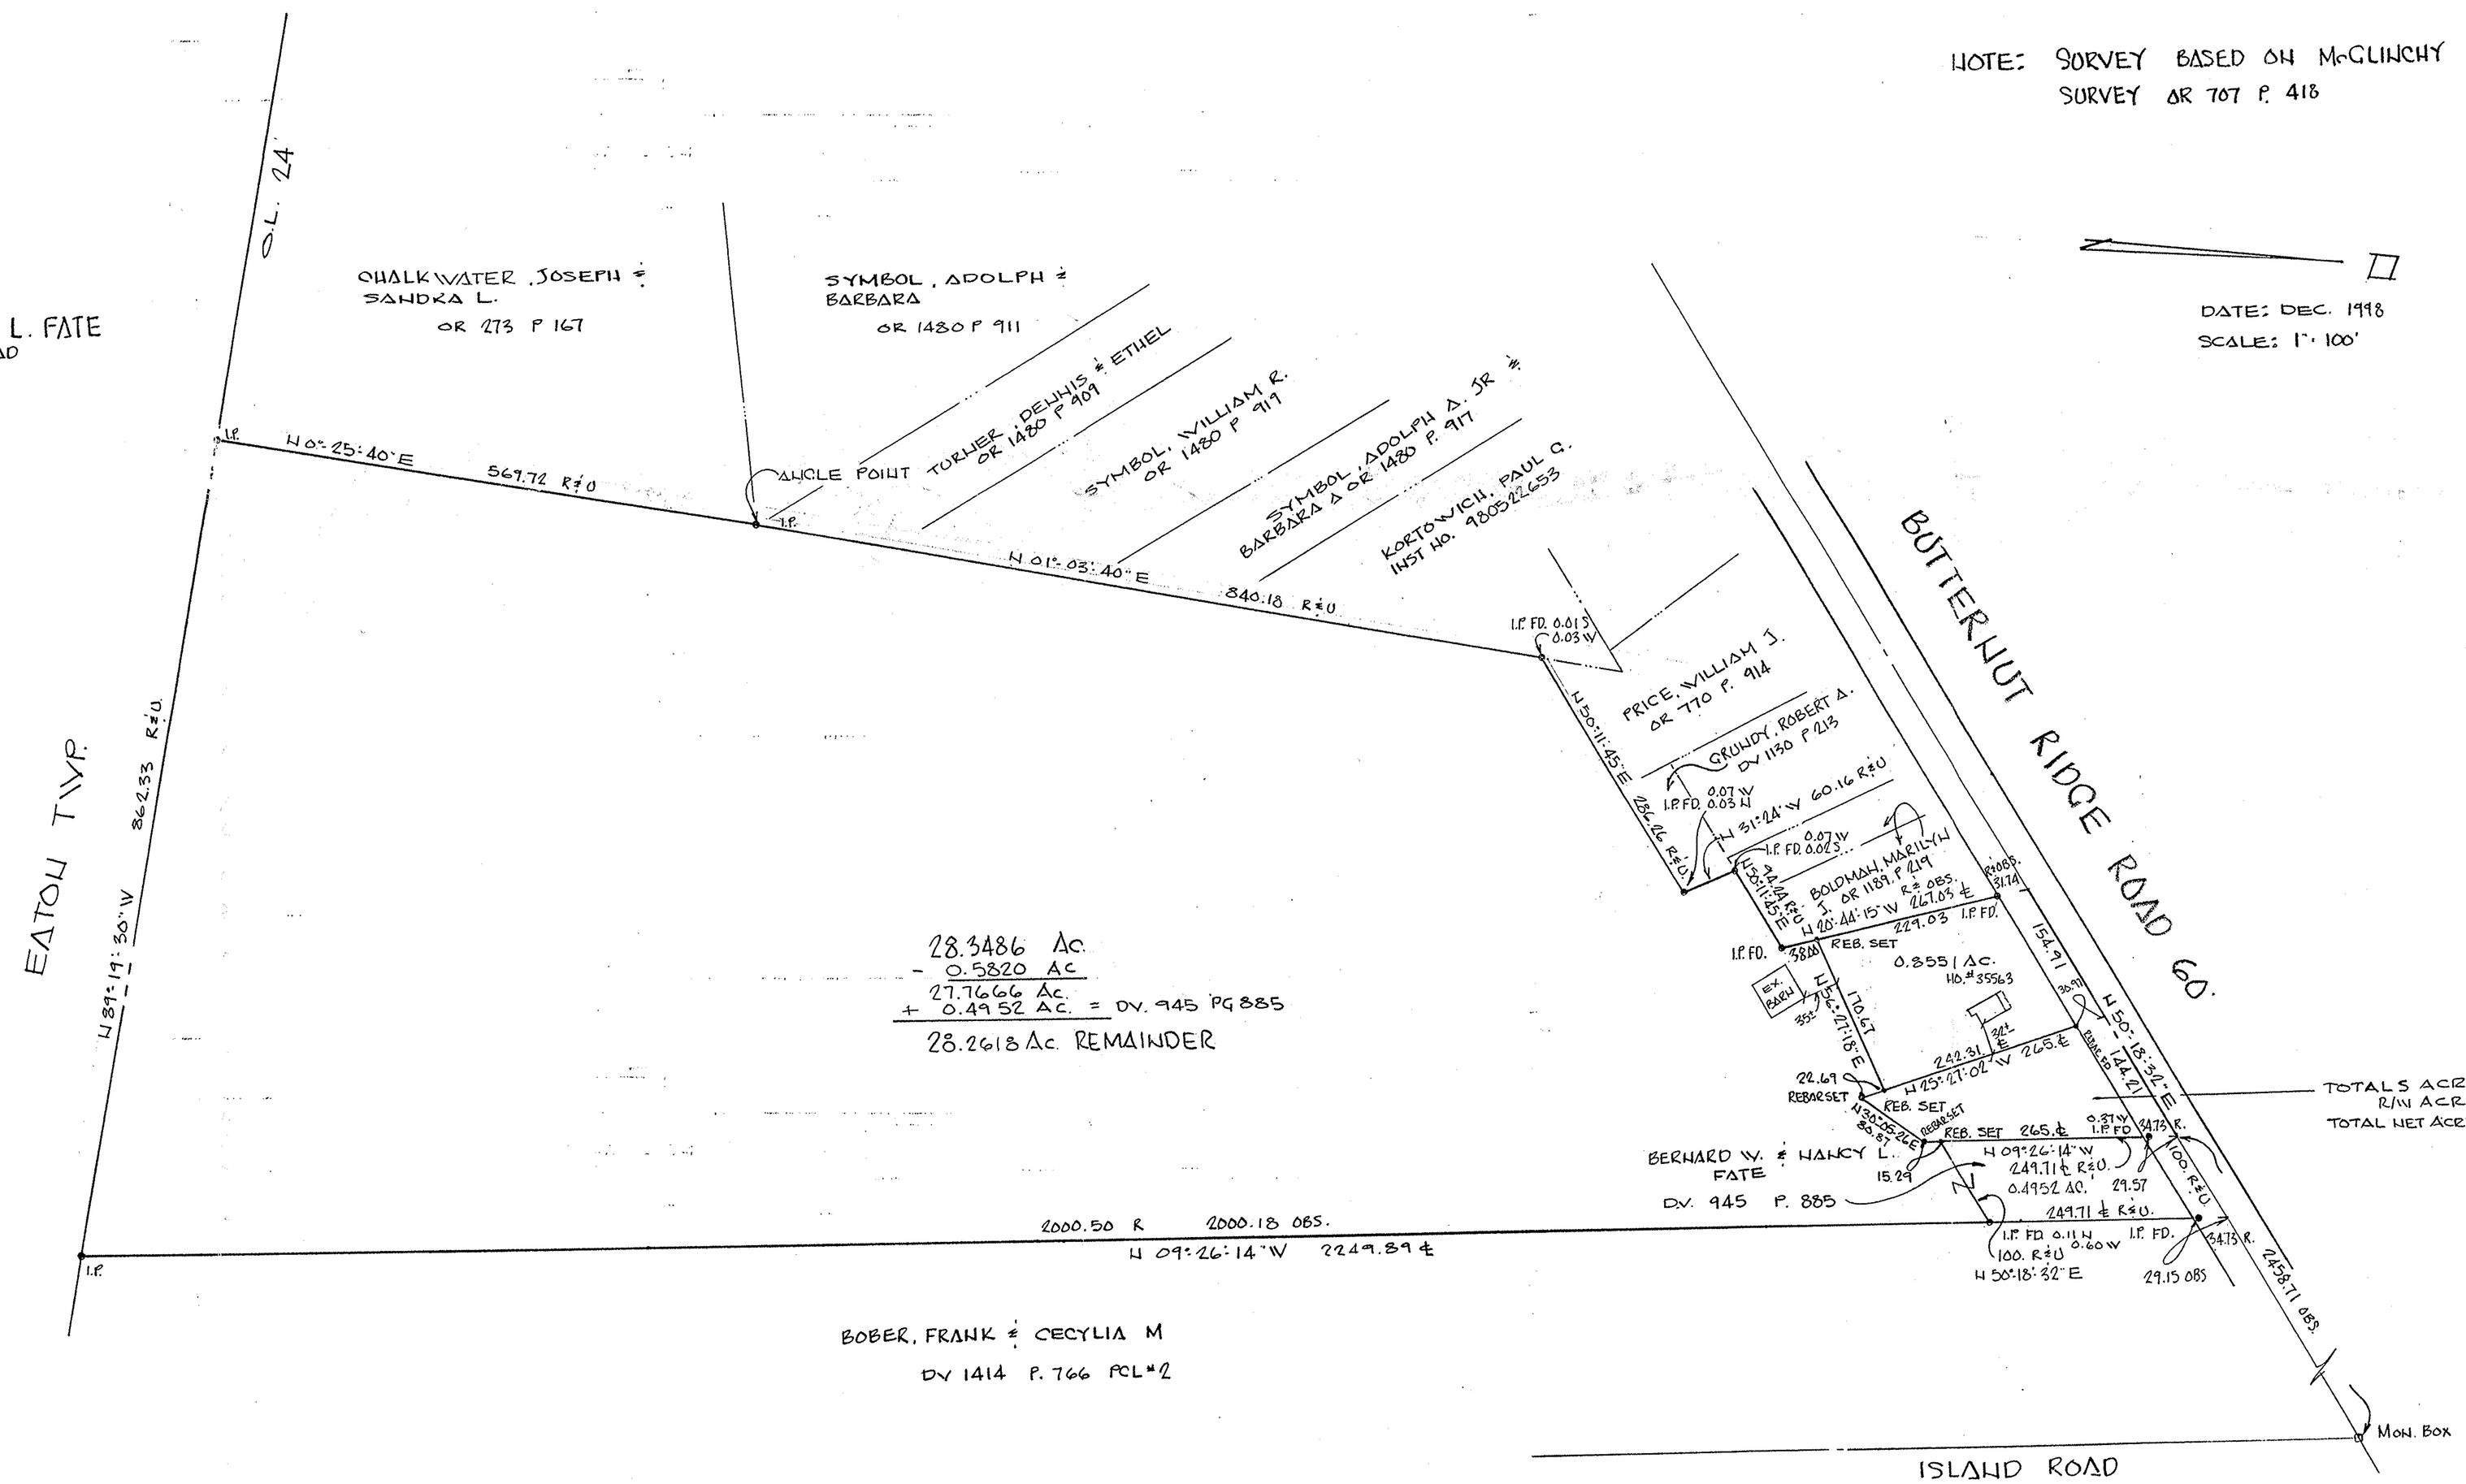

APPROVED
LORAIN CO.
PLANNING COMM.
DATE 3-14-05
PPN 7-00-024-0
BY JHATFIELD
05-01877

No 01877

REVISED FEB 2005

92-05