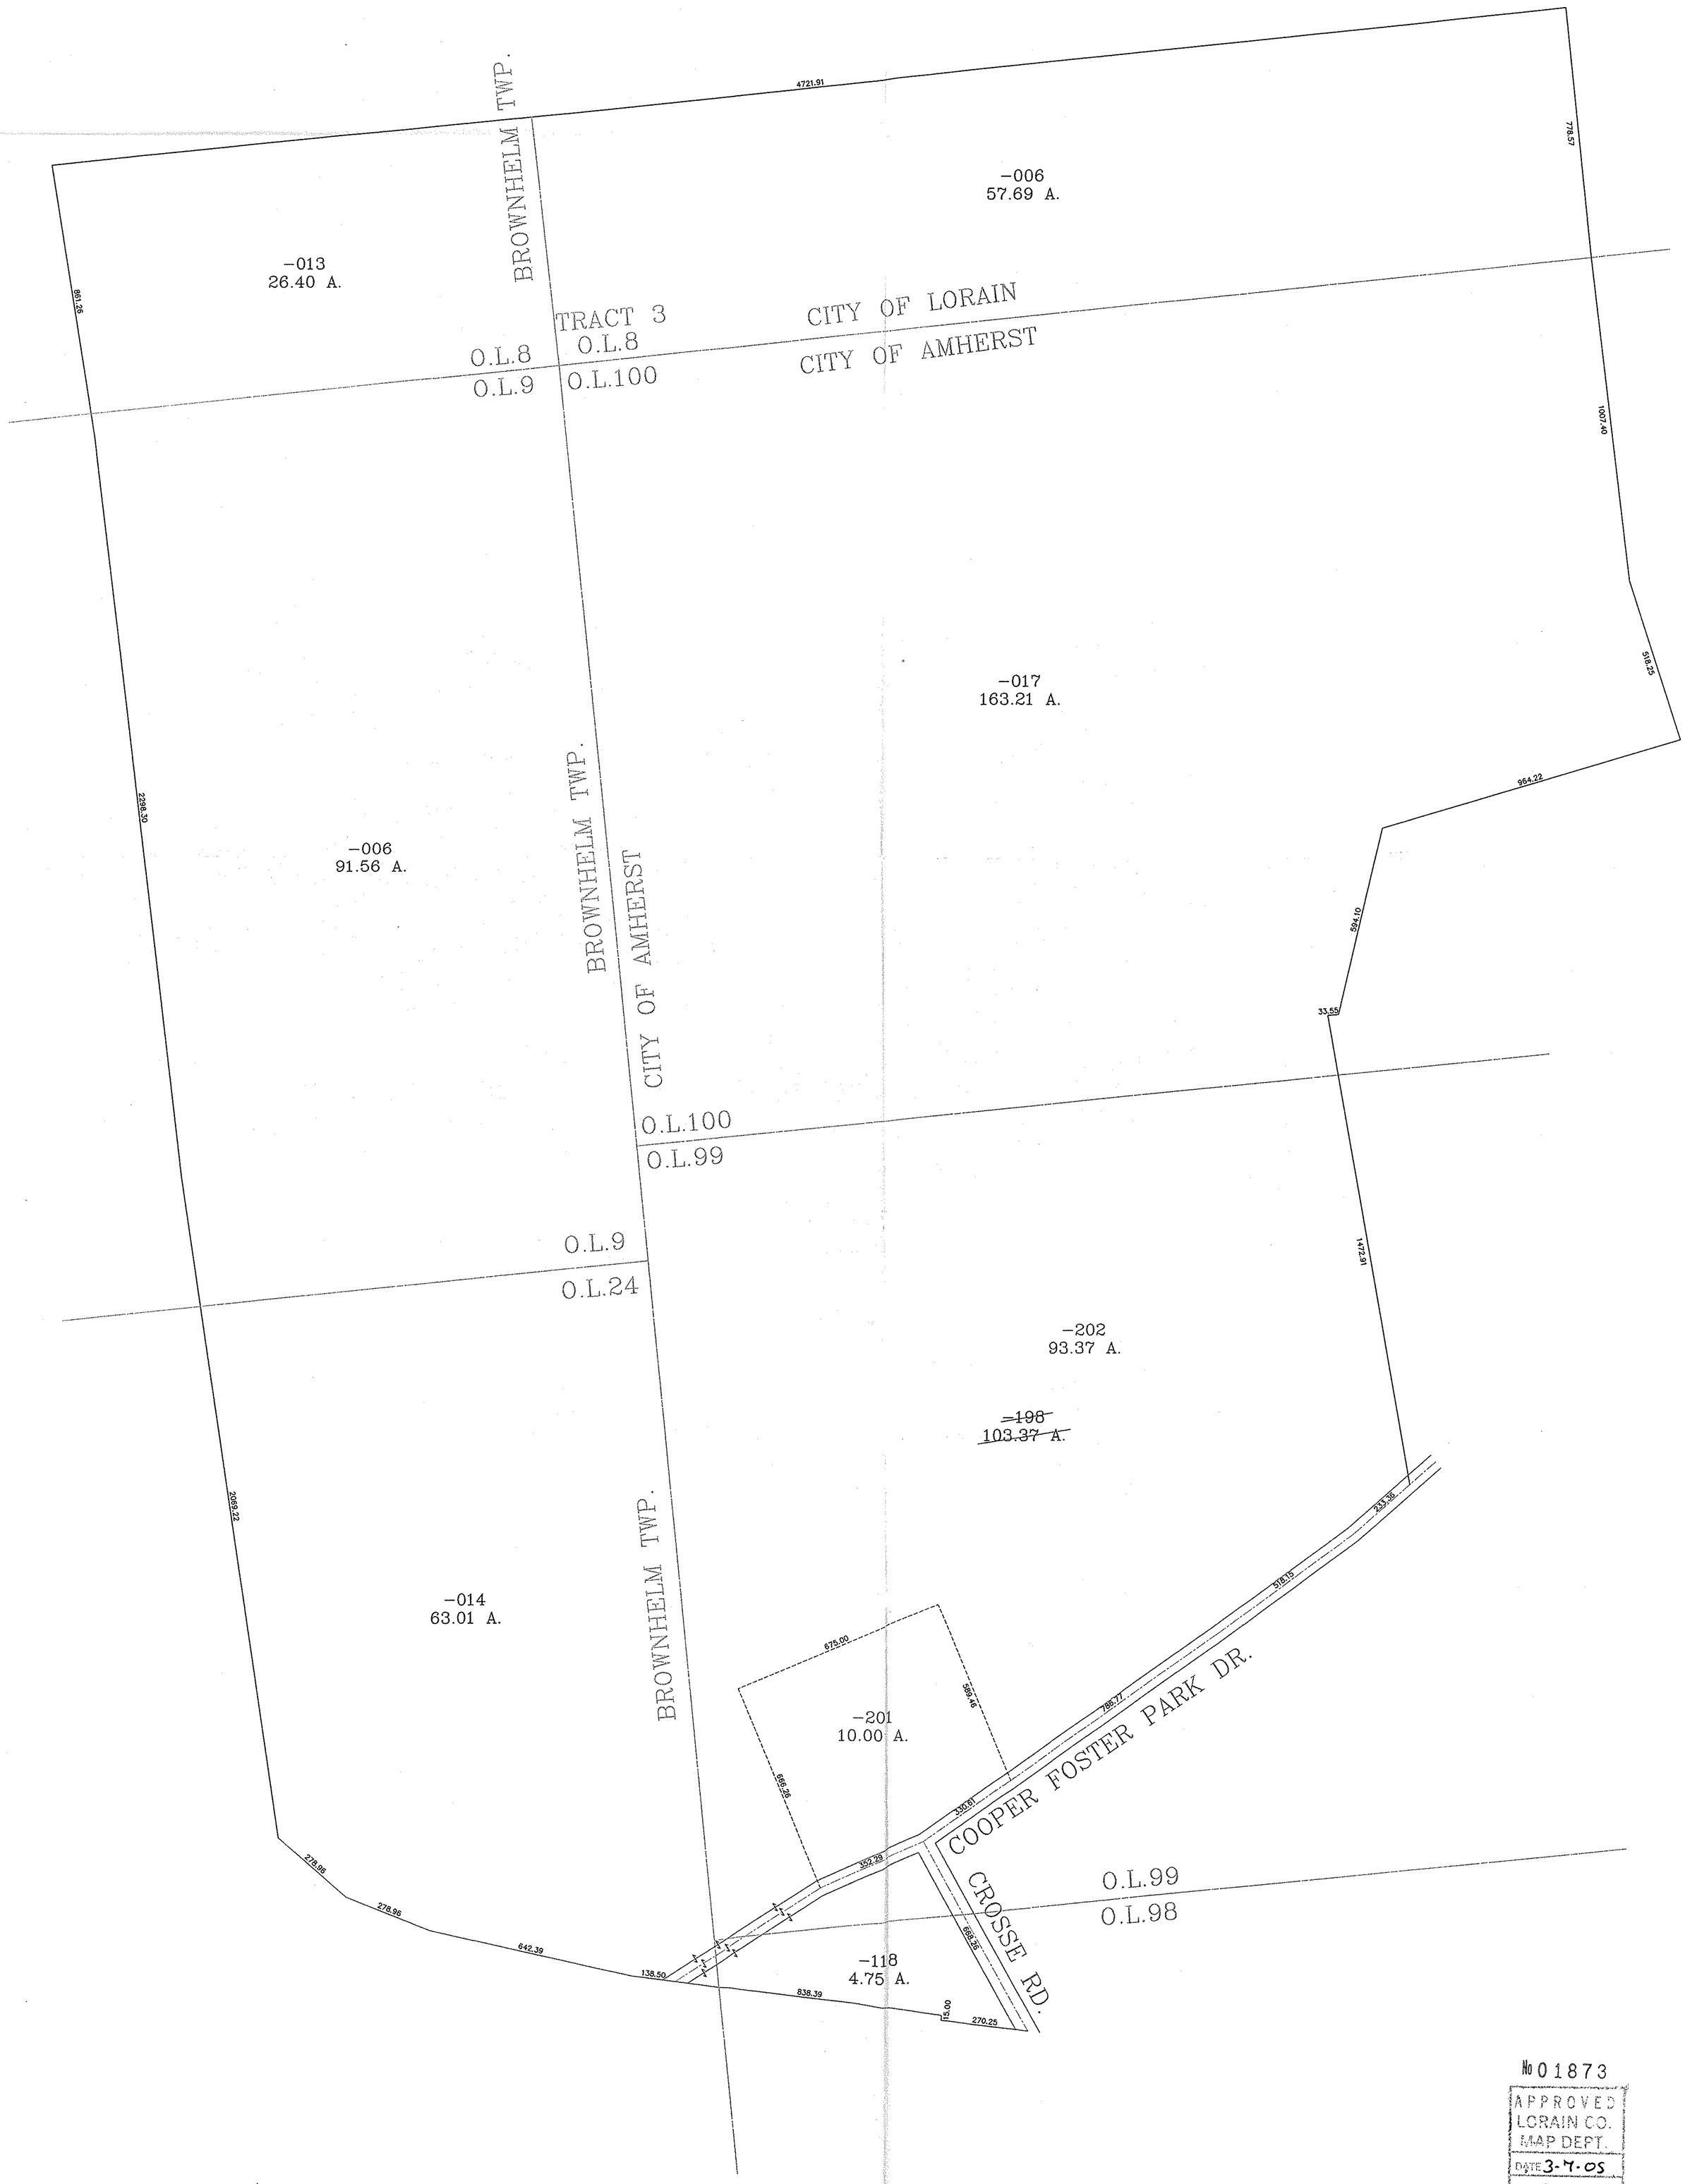

SCALE
1" = 250"

No 01873
APPROVED
LORAIN CO.
MAP DEPT.
DATE 3-7-05
PARCEL S-00099-A
BY R. MAINES
05-01873