BOUNDARY AGREEMENT LINE SURVEY

CITY OF AVON LORAIN COUNTY
STATE OF OHIO
PART OF ORIGINAL AVON TOWNSHIP SECTION NO. 27

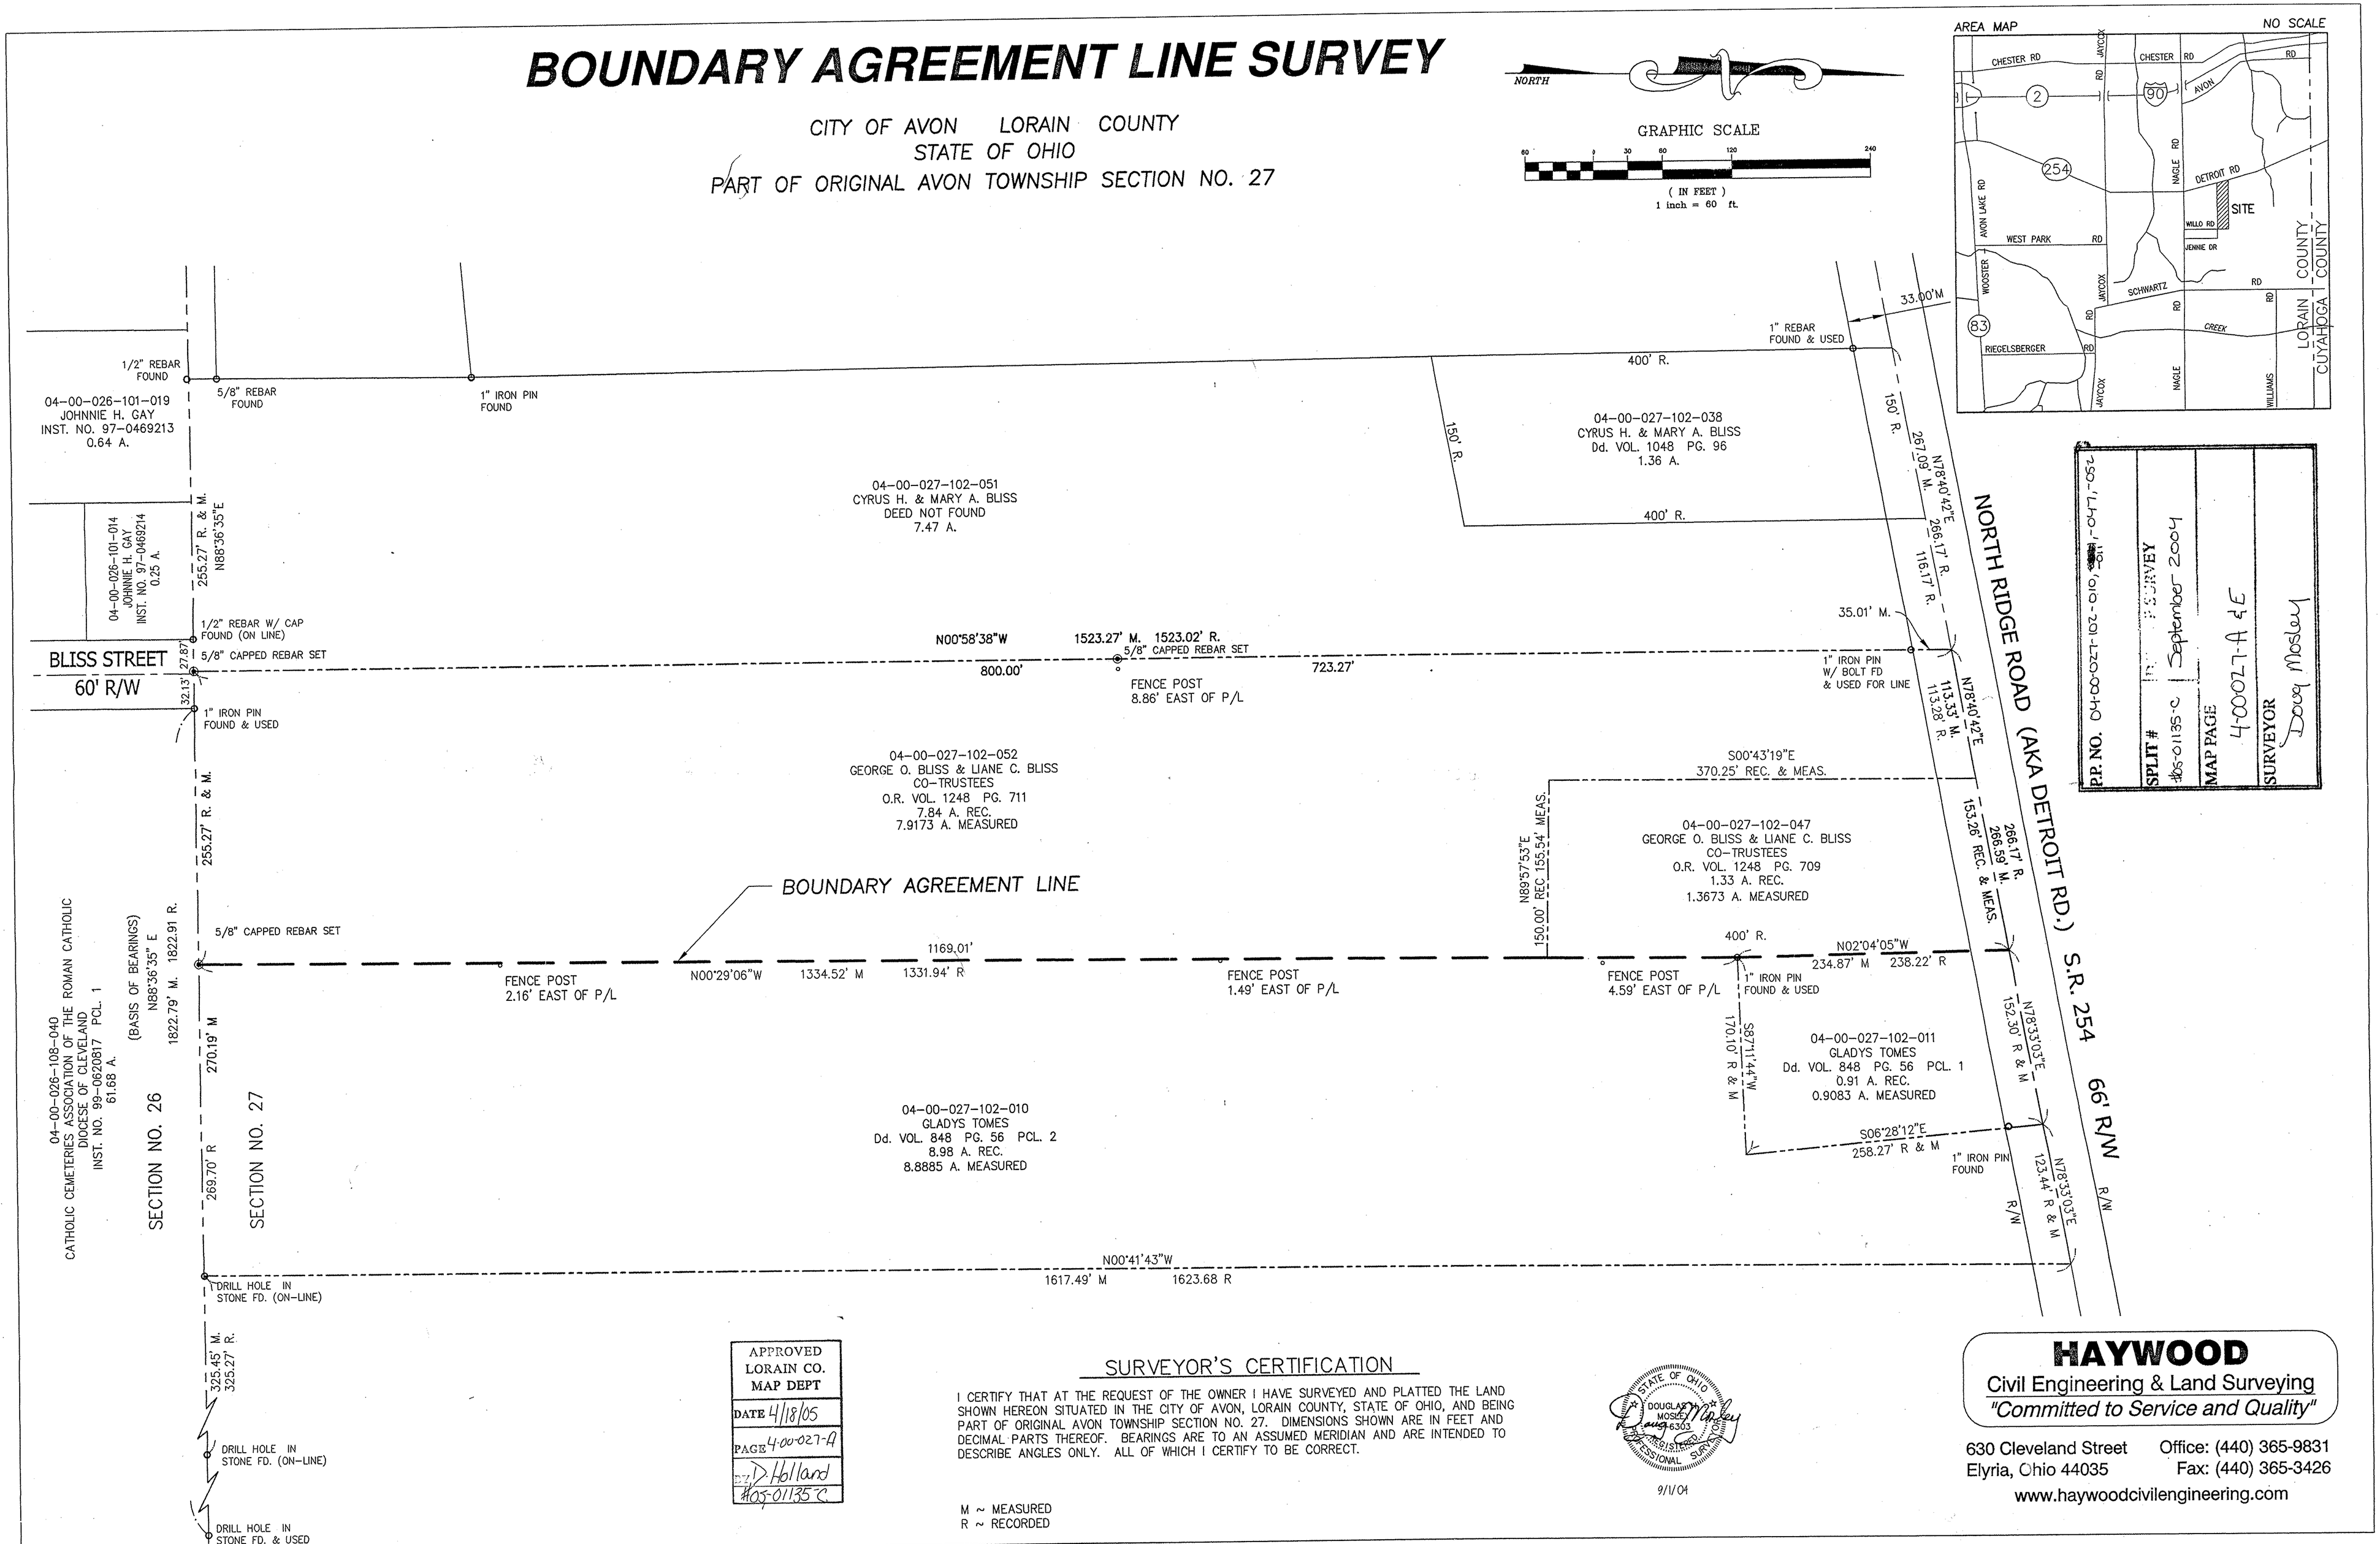

APPROVED
LORAIN CO.
MAP DEPT
DATE 4/18/05
PAGE 4-00-027-A
D Holland
#05-01135-C

SURVEYOR'S CERTIFICATION

I CERTIFY THAT AT THE REQUEST OF THE OWNER I HAVE SURVEYED AND PLATTED THE LAND SHOWN HEREON SITUATED IN THE CITY OF AVON, LORAIN COUNTY, STATE OF OHIO, AND BEING PART OF ORIGINAL AVON TOWNSHIP SECTION NO. 27. DIMENSIONS SHOWN ARE IN FEET AND DECIMAL PARTS THEREOF. BEARINGS ARE TO AN ASSUMED MERIDIAN AND ARE INTENDED TO DESCRIBE ANGLES ONLY. ALL OF WHICH I CERTIFY TO BE CORRECT.

M ~ MEASURED
R ~ RECORDED

STATE OF OHIO
DOUGLAS A. MOSLEY
Aug 6303
REGISTERED PROFESSIONAL SURVEYOR

9/1/04

HAYWOOD
Civil Engineering & Land Surveying
"Committed to Service and Quality"

630 Cleveland Street
Elyria, Ohio 44035
Office: (440) 365-9831
Fax: (440) 365-3426
www.haywoodcivilengineering.com