


PLAT OF BOUNDARY SURVEY
JEFFREY D. & DAWN A. SENG
 PART OF O.L. 17 & 24, AMHERST TOWNSHIP
 CITY OF AMHERST, LORAIN COUNTY, OHIO

No 01908

APPROVED
 LORAIN CO.
 BALDERT

DATE 5-9-05
 PAGE 5-00-024-A
 5-00-017-B

BY JHAField
 # 05-01908

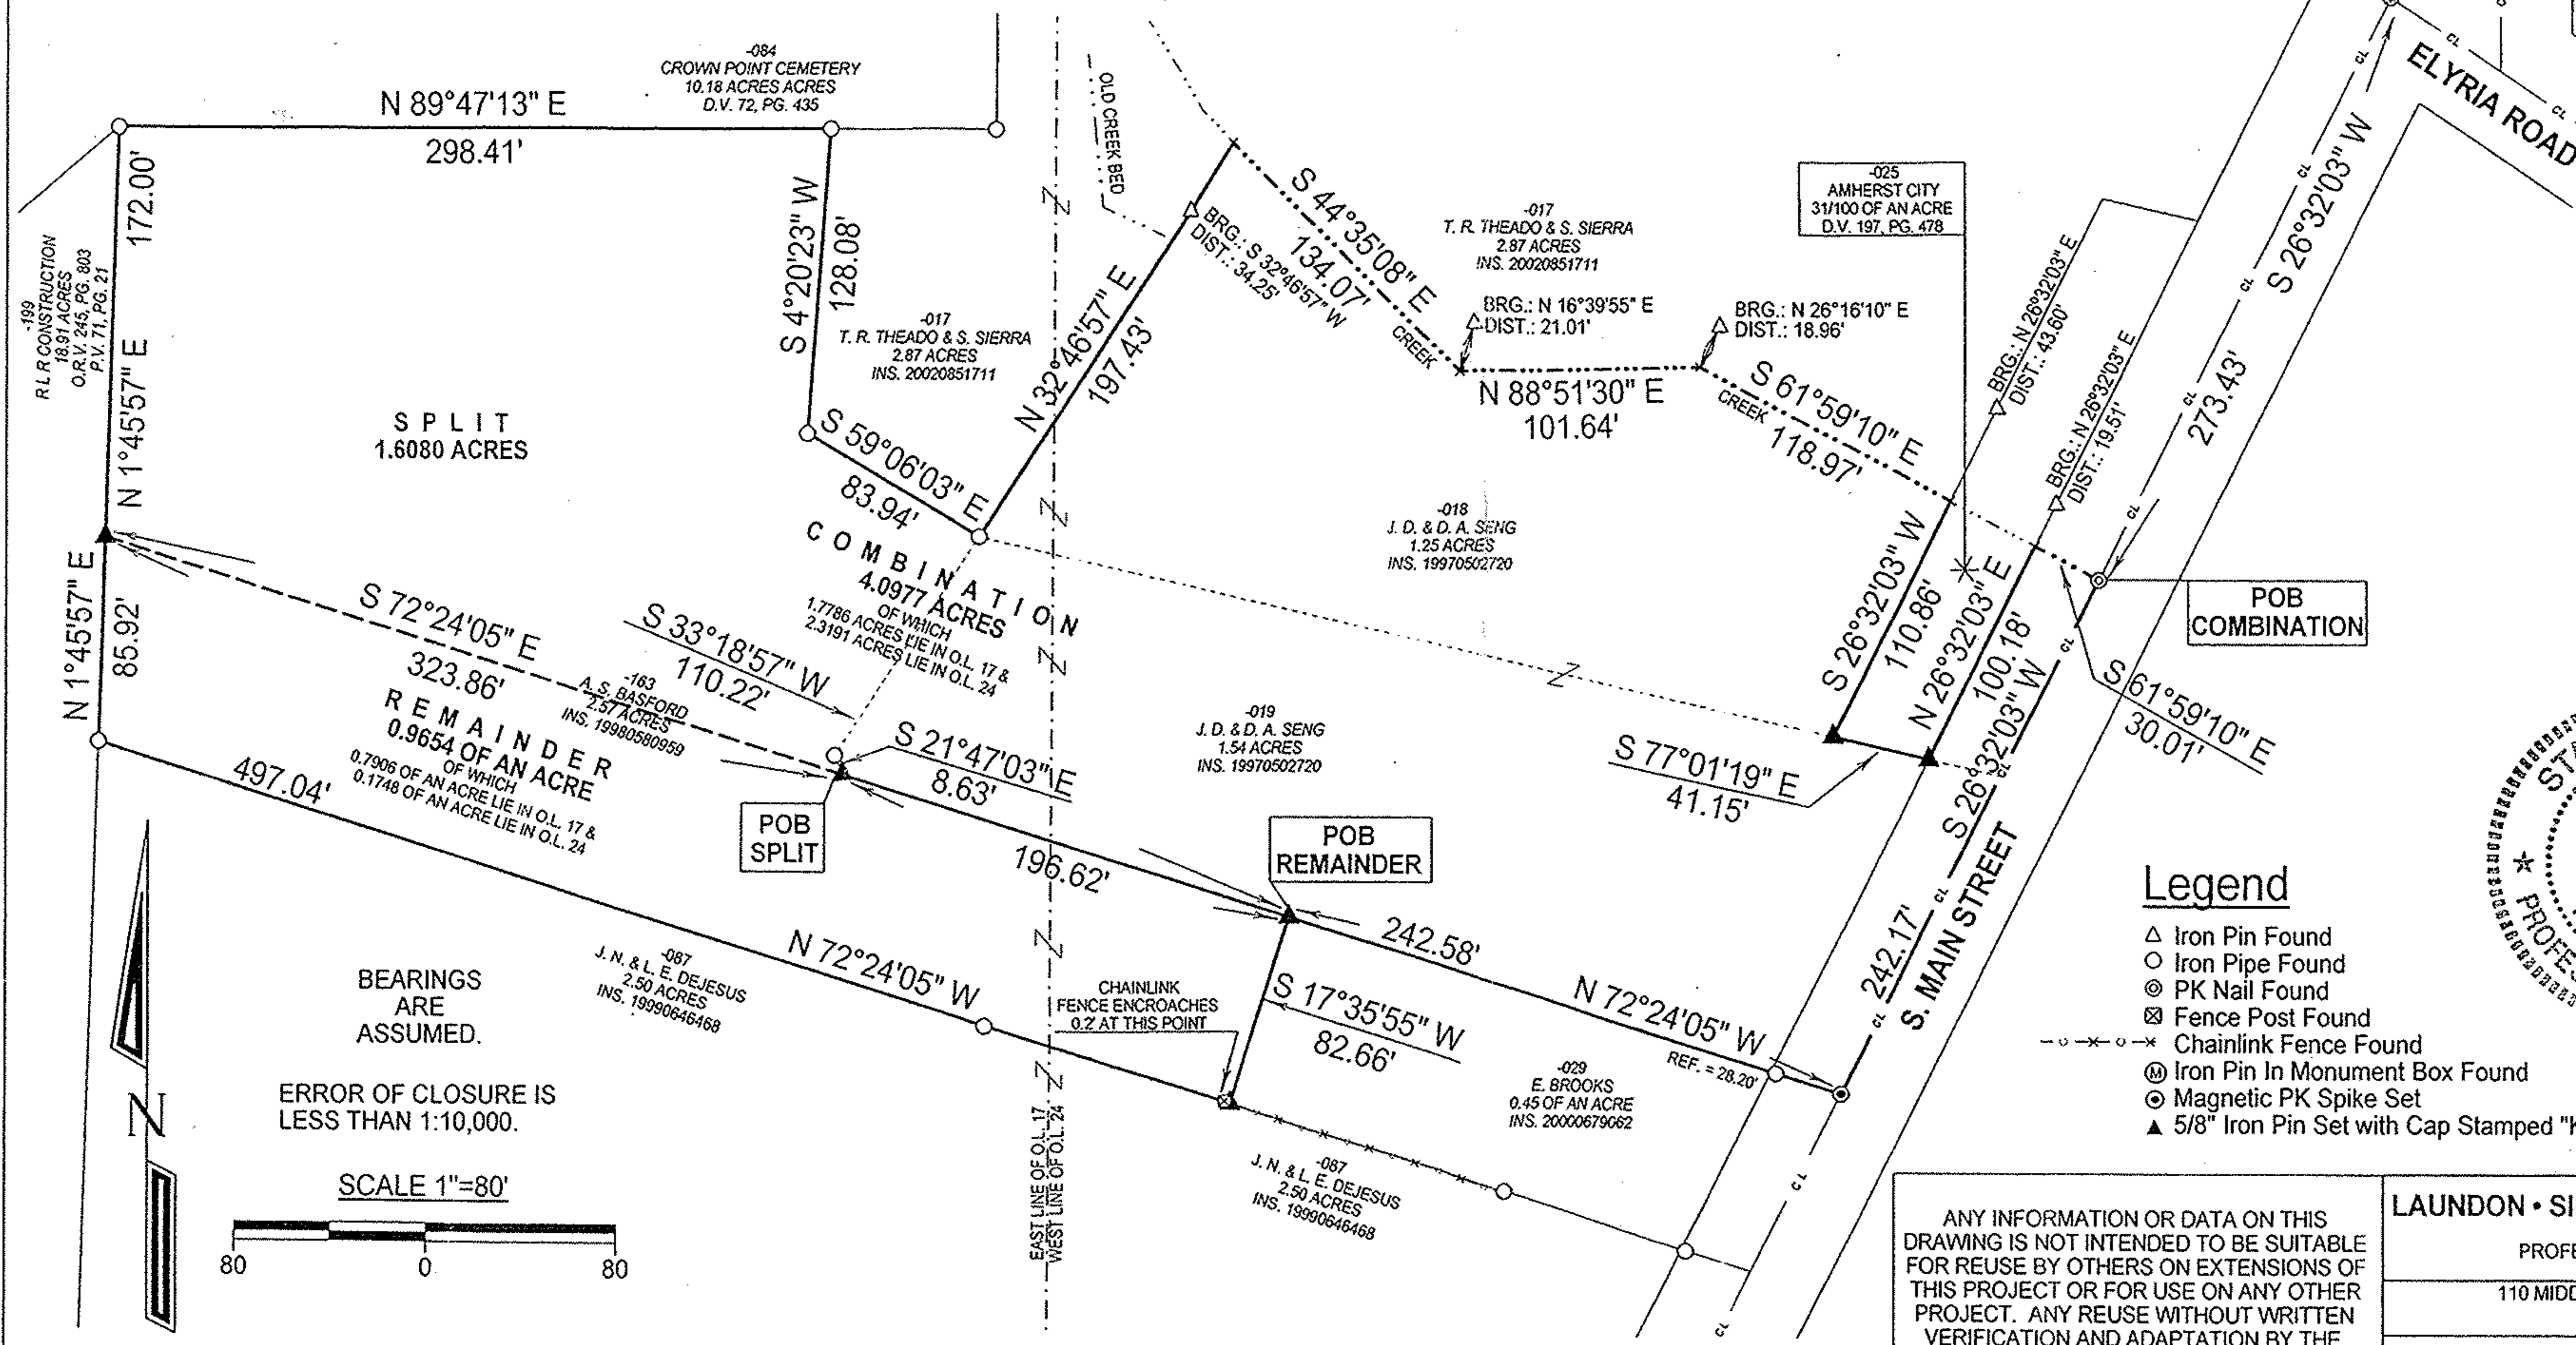

Legend

- △ Iron Pin Found
- Iron Pipe Found
- ⊙ PK Nail Found
- ⊠ Fence Post Found
- - - - - Chainlink Fence Found
- Ⓜ Iron Pin In Monument Box Found
- ⊙ Magnetic PK Spike Set
- ▲ 5/8" Iron Pin Set with Cap Stamped "Kelsner 7871"

DATE:	1/31/05
JOB NO.:	05-3767

ANY INFORMATION OR DATA ON THIS DRAWING IS NOT INTENDED TO BE SUITABLE FOR REUSE BY OTHERS ON EXTENSIONS OF THIS PROJECT OR FOR USE ON ANY OTHER PROJECT. ANY REUSE WITHOUT WRITTEN VERIFICATION AND ADAPTATION BY THE SURVEYOR FOR THE SPECIFIC PURPOSE INTENDED WILL BE AT THE USER'S SOLE RISK AND WITHOUT LIABILITY OR LEGAL EXPOSURE TO THE SURVEYOR.

LAUNDON • SIMON • KELSER & ASSOC., INC.
 PROFESSIONAL LAND SURVEYORS
 110 MIDDLE AVE. • ELYRIA, OHIO • 44035
 PHONE (440) 322-7625

Alex Kelsner
 Alex Kelsner RLS #7871