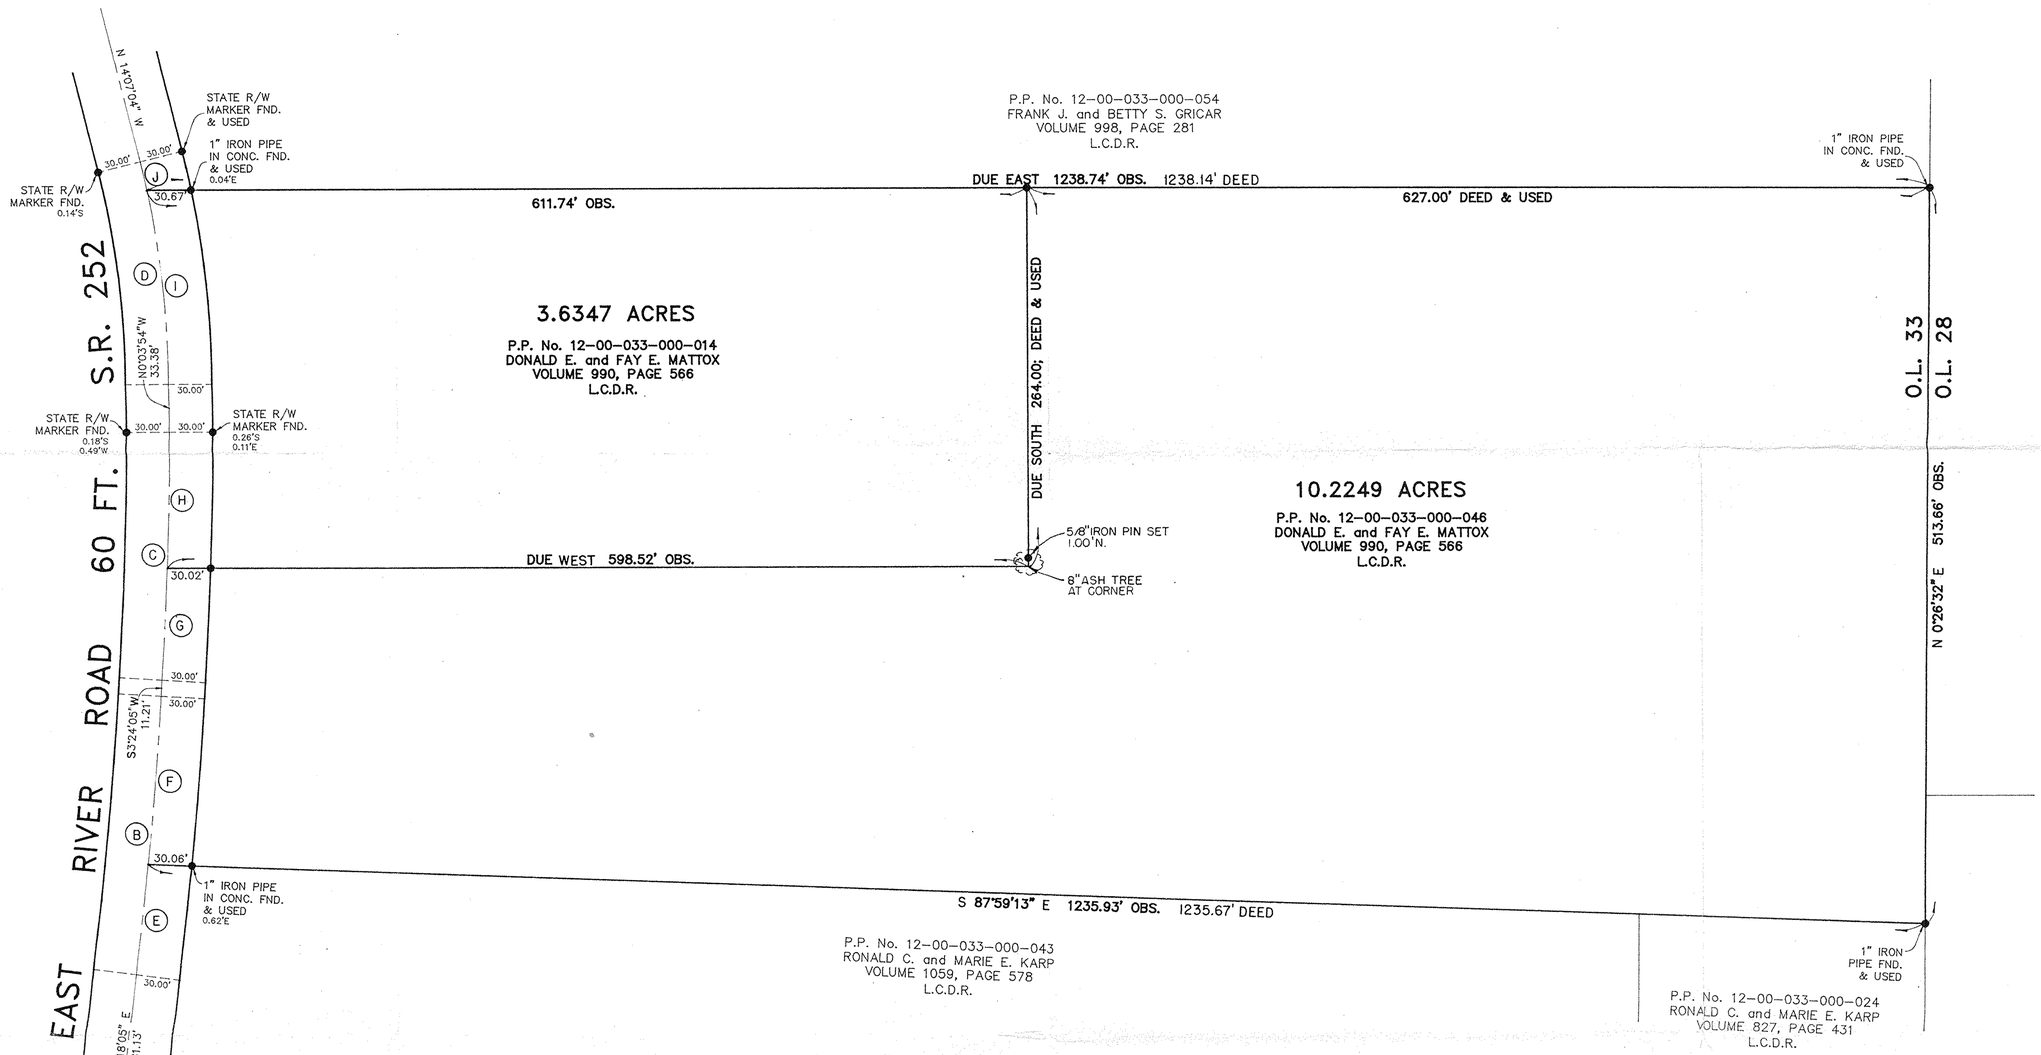

(A) R=637.28' R. & U.
A=102.96' R. & U.
C=102.85'
N11°55'48"E
Δ=9°15'25" CALC.
Δ=9°16' REC.

(B) R=2864.93' R. & U.
A=195.00' R. & U.
C=197.97'
N5°21'05"E
Δ=9°54'00" R. & U.

(C) R=2864.93' R. & U.
A=173.33' R. & U.
C=173.30'
N1°40'06"E
Δ=3°27'59" CALC.
Δ=3°28' REC.

(D) R=637.28' R. & U.
A=156.30' R. & U.
C=155.91'
N7°05'29"W
Δ=14°03'10" CALC.
Δ=14°04' REC.

(E) R=2864.93' R. & U.
A=77.40'
C=77.40'
N6°31'38"E
Δ=1°32'53"

(F) R=2864.93' R. & U.
A=117.60'
C=117.59'
S4°34'39"E
Δ=2°21'07"

(G) R=2864.93' R. & U.
A=77.91'
C=77.90'
S2°37'21"W
Δ=1°33'29"

(H) R=2864.93' R. & U.
A=95.42'
C=95.42'
N0°53'21"E
Δ=1°54'30"

(I) R=637.28' R. & U.
A=136.27'
C=136.01'
N6°11'26"W
Δ=12°15'04"

(J) R=637.28' R. & U.
A=20.04'
C=20.04'
N13°13'01"W
Δ=1°48'06"

MAP OF SURVEY FOR DONALD E. and FAY E. MATTOX

SITUATED IN THE TOWNSHIP OF COLUMBIA, COUNTY OF LORAIN AND STATE OF OHIO, AND KNOWN AS BEING PART OF ORIGINAL COLUMBIA TOWNSHIP LOT No. 33.

The Western Reserve Surveying Co.

CLEVELAND, OHIO

GRAPHIC SCALE

50 0 25 50 100 200

(IN FEET)
1 inch = 50 ft.

OCTOBER, 2003

STATE OF OHIO
RICHARD F. HANTEL
S-5129
REGISTERED
SURVEYOR

N

● INDICATES 5/8" ø IRON PIN WITH CAP SET UNLESS NOTED.

BEARINGS ARE TO AN ASSUMED MERIDIAN AND ARE USED TO DENOTE ANGLES ONLY.

APPROVED
LORAIN CO.
MAP DEPT
DATE 10/31/03
PAGE 12-00-033-E
BY D. Holland
#009424

A-4058