THOMAS SIMON & ASSOCIATES, INC.
PROFESSIONAL LAND SURVEYORS

COBBLESTONE CORNER PROFESSIONAL CENTER
39049 CENTER RIDGE ROAD
NORTH RIDGEVILLE, OHIO 44039
(440) 327-2925
FAX 327-2964

SURVEY FOR: TIMOTHY & KIMBERLY BROWN
330 N. RIDGE ROAD
LORAIN, OH. 44055

ORIG LOT 113	CITY OF	DATE: 6-2003 SCALE: 1"=100'
ORIG. SEC.	VILLAGE OF	DWN. BY TAS
TRACT	COUNTY OF LORAIN	JOB NO. 2003-028
TOWNSHIP OF SHEFFIELD	STATE OF OHIO	PARCEL NO. 03-00-113-104-028

DIMENSIONS SHOWN ON THIS PLAT ARE EXPRESSED IN FEET AND DECIMAL PARTS THEREOF. ALL BEARINGS ARE TO AN ASSUMED MERIDIAN AND ARE USED TO DESCRIBE ANGLES ONLY. PERMANENT MONUMENTS WERE FOUND OR SET AS INDICATED, ALL OF WHICH I CERTIFY TO BE CORRECT.

THOMAS A. SIMON
REGISTERED PROFESSIONAL
SURVEYOR NO. S-7775
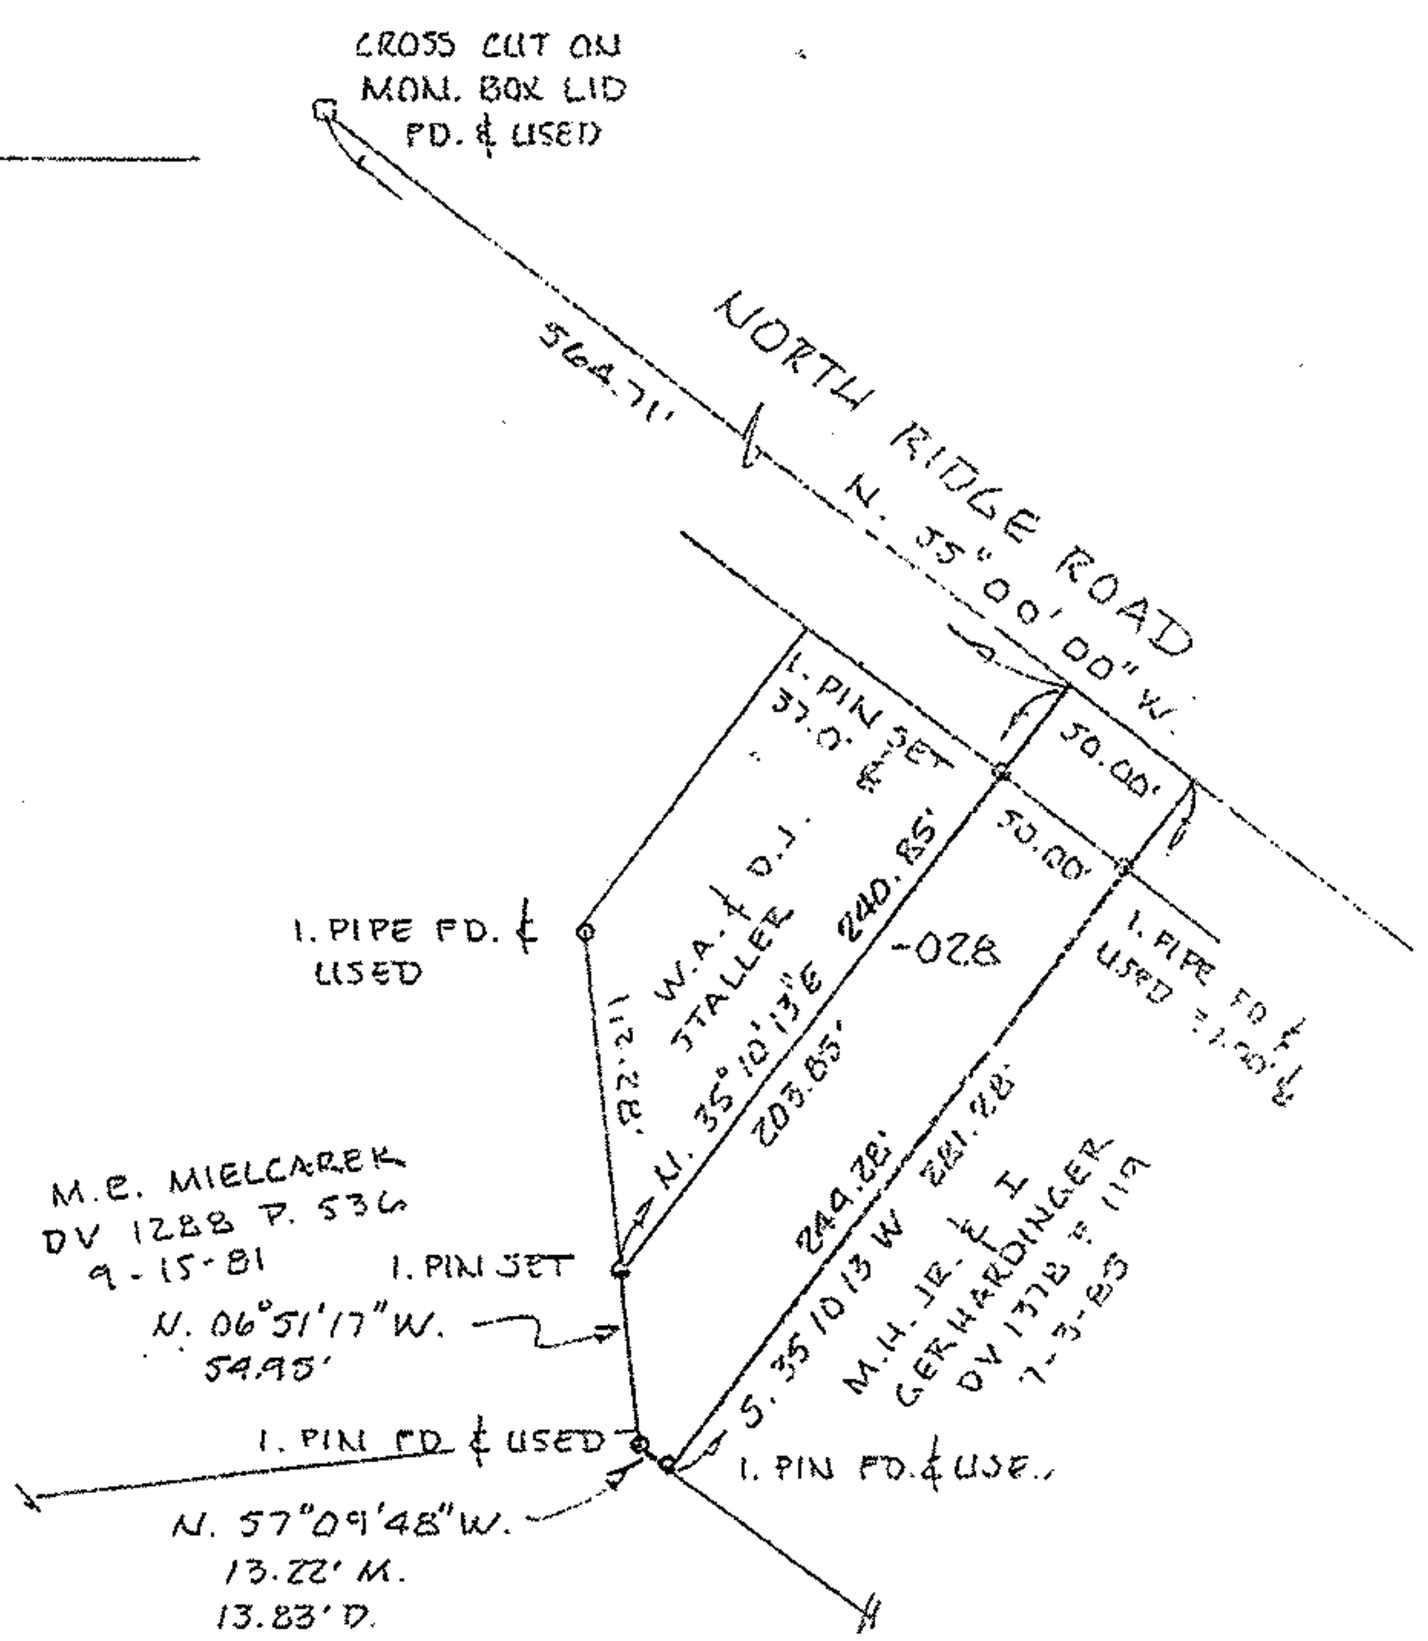
THOMAS A. SIMON S-7775 REGISTERED PROFESSIONAL SURVEYOR STATE OF OHIO