CONSOLIDATION AND LOT SPLIT
FOR
RICHARD L. AND JEAN A. REYNOLDS

SITUATED IN THE TOWNSHIP OF HUNTINGTON, COUNTY OF LORAIN, STATE OF OHIO AND BEING KNOWN AS PART OF ORIGINAL HUNTINGTON TOWNSHIP TRACT 4.

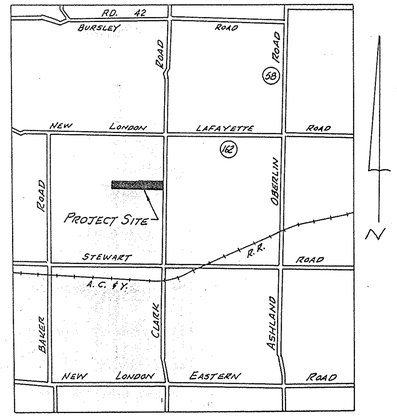

LOCATION MAP
NTS

NORTH
SCALE 1" = 100'
0 100' 200'

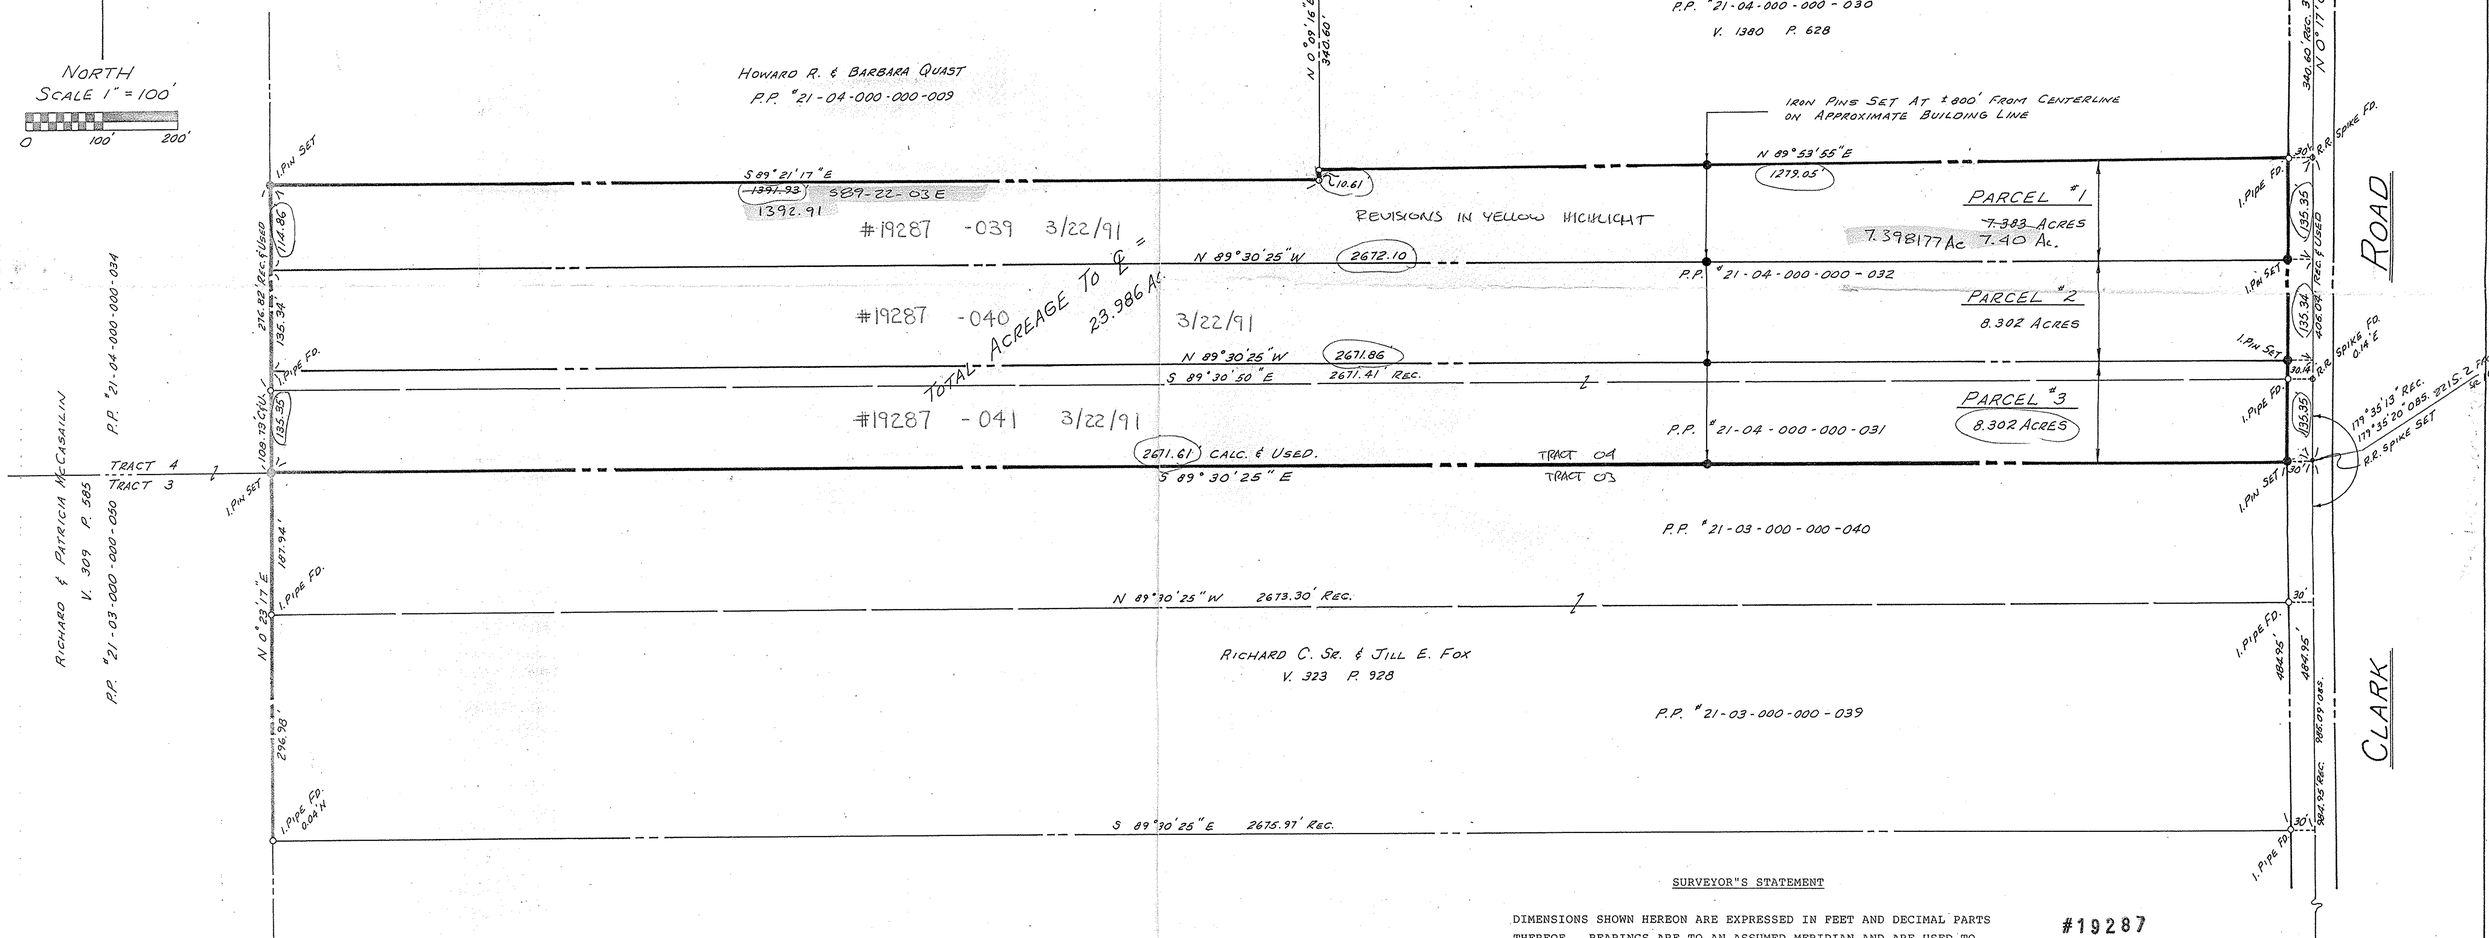

SURVEYOR'S STATEMENT

DIMENSIONS SHOWN HEREON ARE EXPRESSED IN FEET AND DECIMAL PARTS THEREOF. BEARINGS ARE TO AN ASSUMED MERIDIAN AND ARE USED TO INDICATE ANGLES ONLY. PERMANENT MONUMENTS WERE FOUND OR SET AS INDICATED HEREON. ALL OF WHICH I DECLARE TO BE CORRECT.

STATE OF OHIO — THOMAS M. SNEZEK S-7051 — SURVEYOR

Thomas M. Snezek 2-12-91 Rev. 3-7-91
THOMAS M. SNEZEK - REG. NO. 7051

#19287

APPROVED
LORAIN CO.
MAP DEPT.
DATE 3-22-91
PAGE 21-E
BY T. McCain
VOID AFTER 19287