Boundary Survey

Carlisle Township ~ Lorain County ~ State of Ohio
Part of Original Carlisle Township Section 5

10-00-005-107-064
Doc. No. 2005-0048719
2.00 Acres

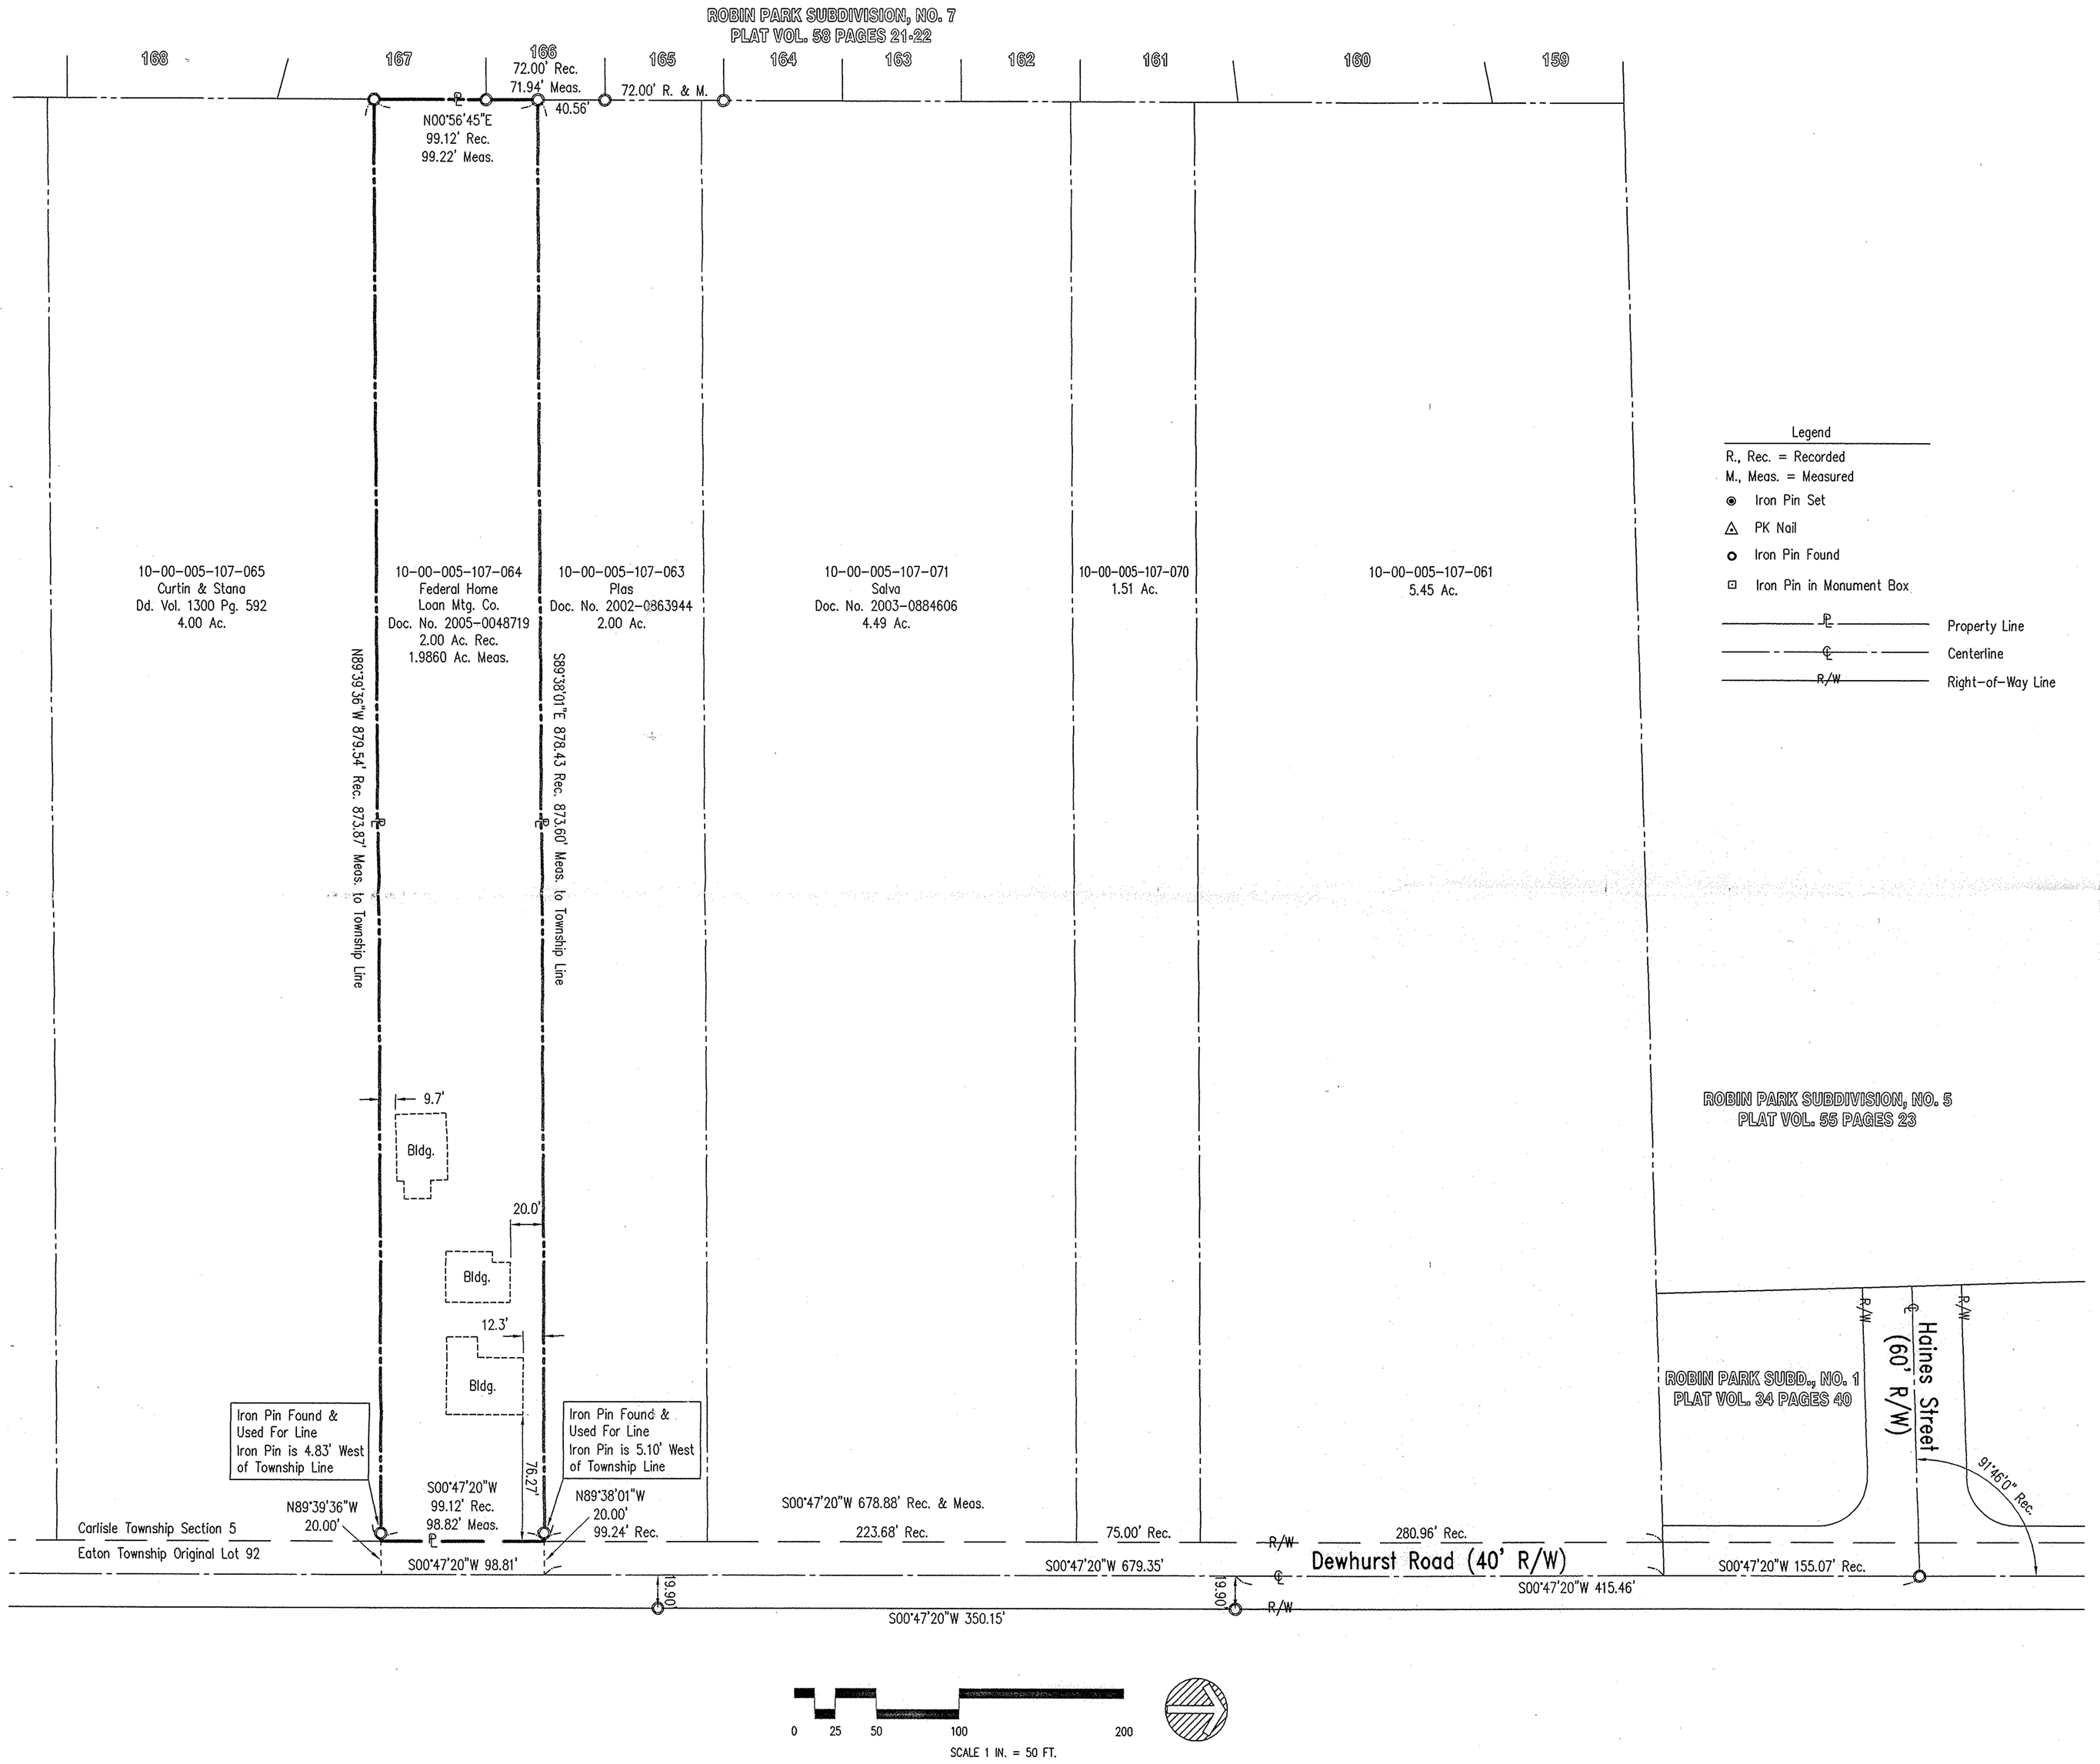

Legend

R., Rec. = Recorded
M., Meas. = Measured
Iron Pin Set
PK Nail
Iron Pin Found
Iron Pin in Monument Box
Property Line
Centerline
Right-of-Way Line

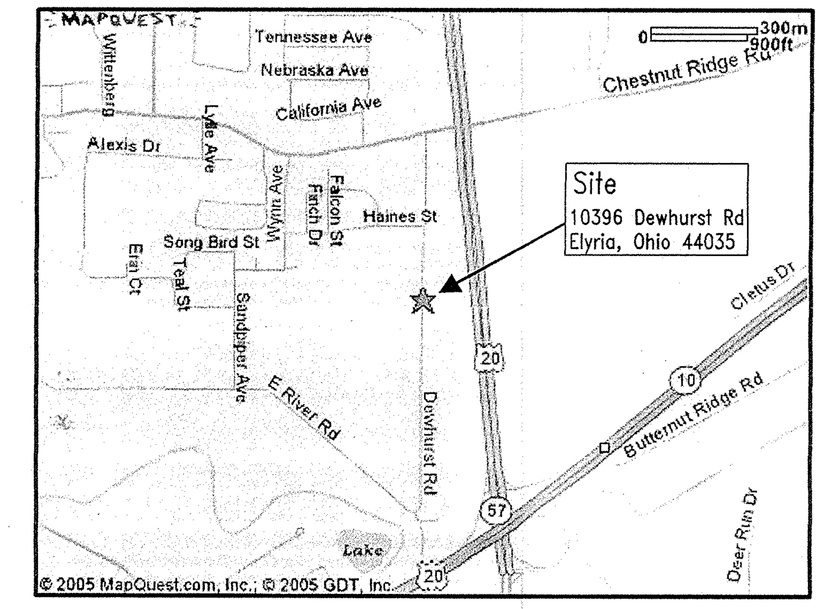

Vicinity Map

0 250 500 1000 2000 4000
SCALE 1 IN. = 1000 FT.

0 25 50 100 200
SCALE 1 IN. = 50 FT.

Prepared For
Gerner REO
215 W. 9th Street
Cincinnati, Ohio 45202
(513) 241-7722

Prepared By

HAYWOOD
Civil Engineering & Land Surveying, Inc.

630 Cleveland Street
Elyria, Ohio 44035
www.haywoodcivilengineering.com
(440) 365-9831 Office
(440) 365-3426 Fax

Dimensions shown on this plat are in feet and decimal parts thereof, all bearings are to an assumed meridian and intended to describe angles only. Permanent monuments were found or set at all points indicated hereon, all of which I certify to be correct.

The basis of bearings is N 00°47'20" E for the east line of Carlisle Township and the west line of Dewhurst Road.

STATE OF OHIO
DALE R. HAYWOOD
S-8284
REGISTERED
PROFESSIONAL SURVEYOR

Dale Haywood 2/8/05

Dale R. Haywood, P.S.
Registered State of Ohio Surveyor No. 8284

Date