P.P. NO.	15-00-005-00-094 15-00-056-101-052
SPLIT #	DATE OF SURVEY
#05-0158-C	December 1993
MAP PAGE	15-00-005-A 15-00-056-A
SURVEYOR	Rodger Simon

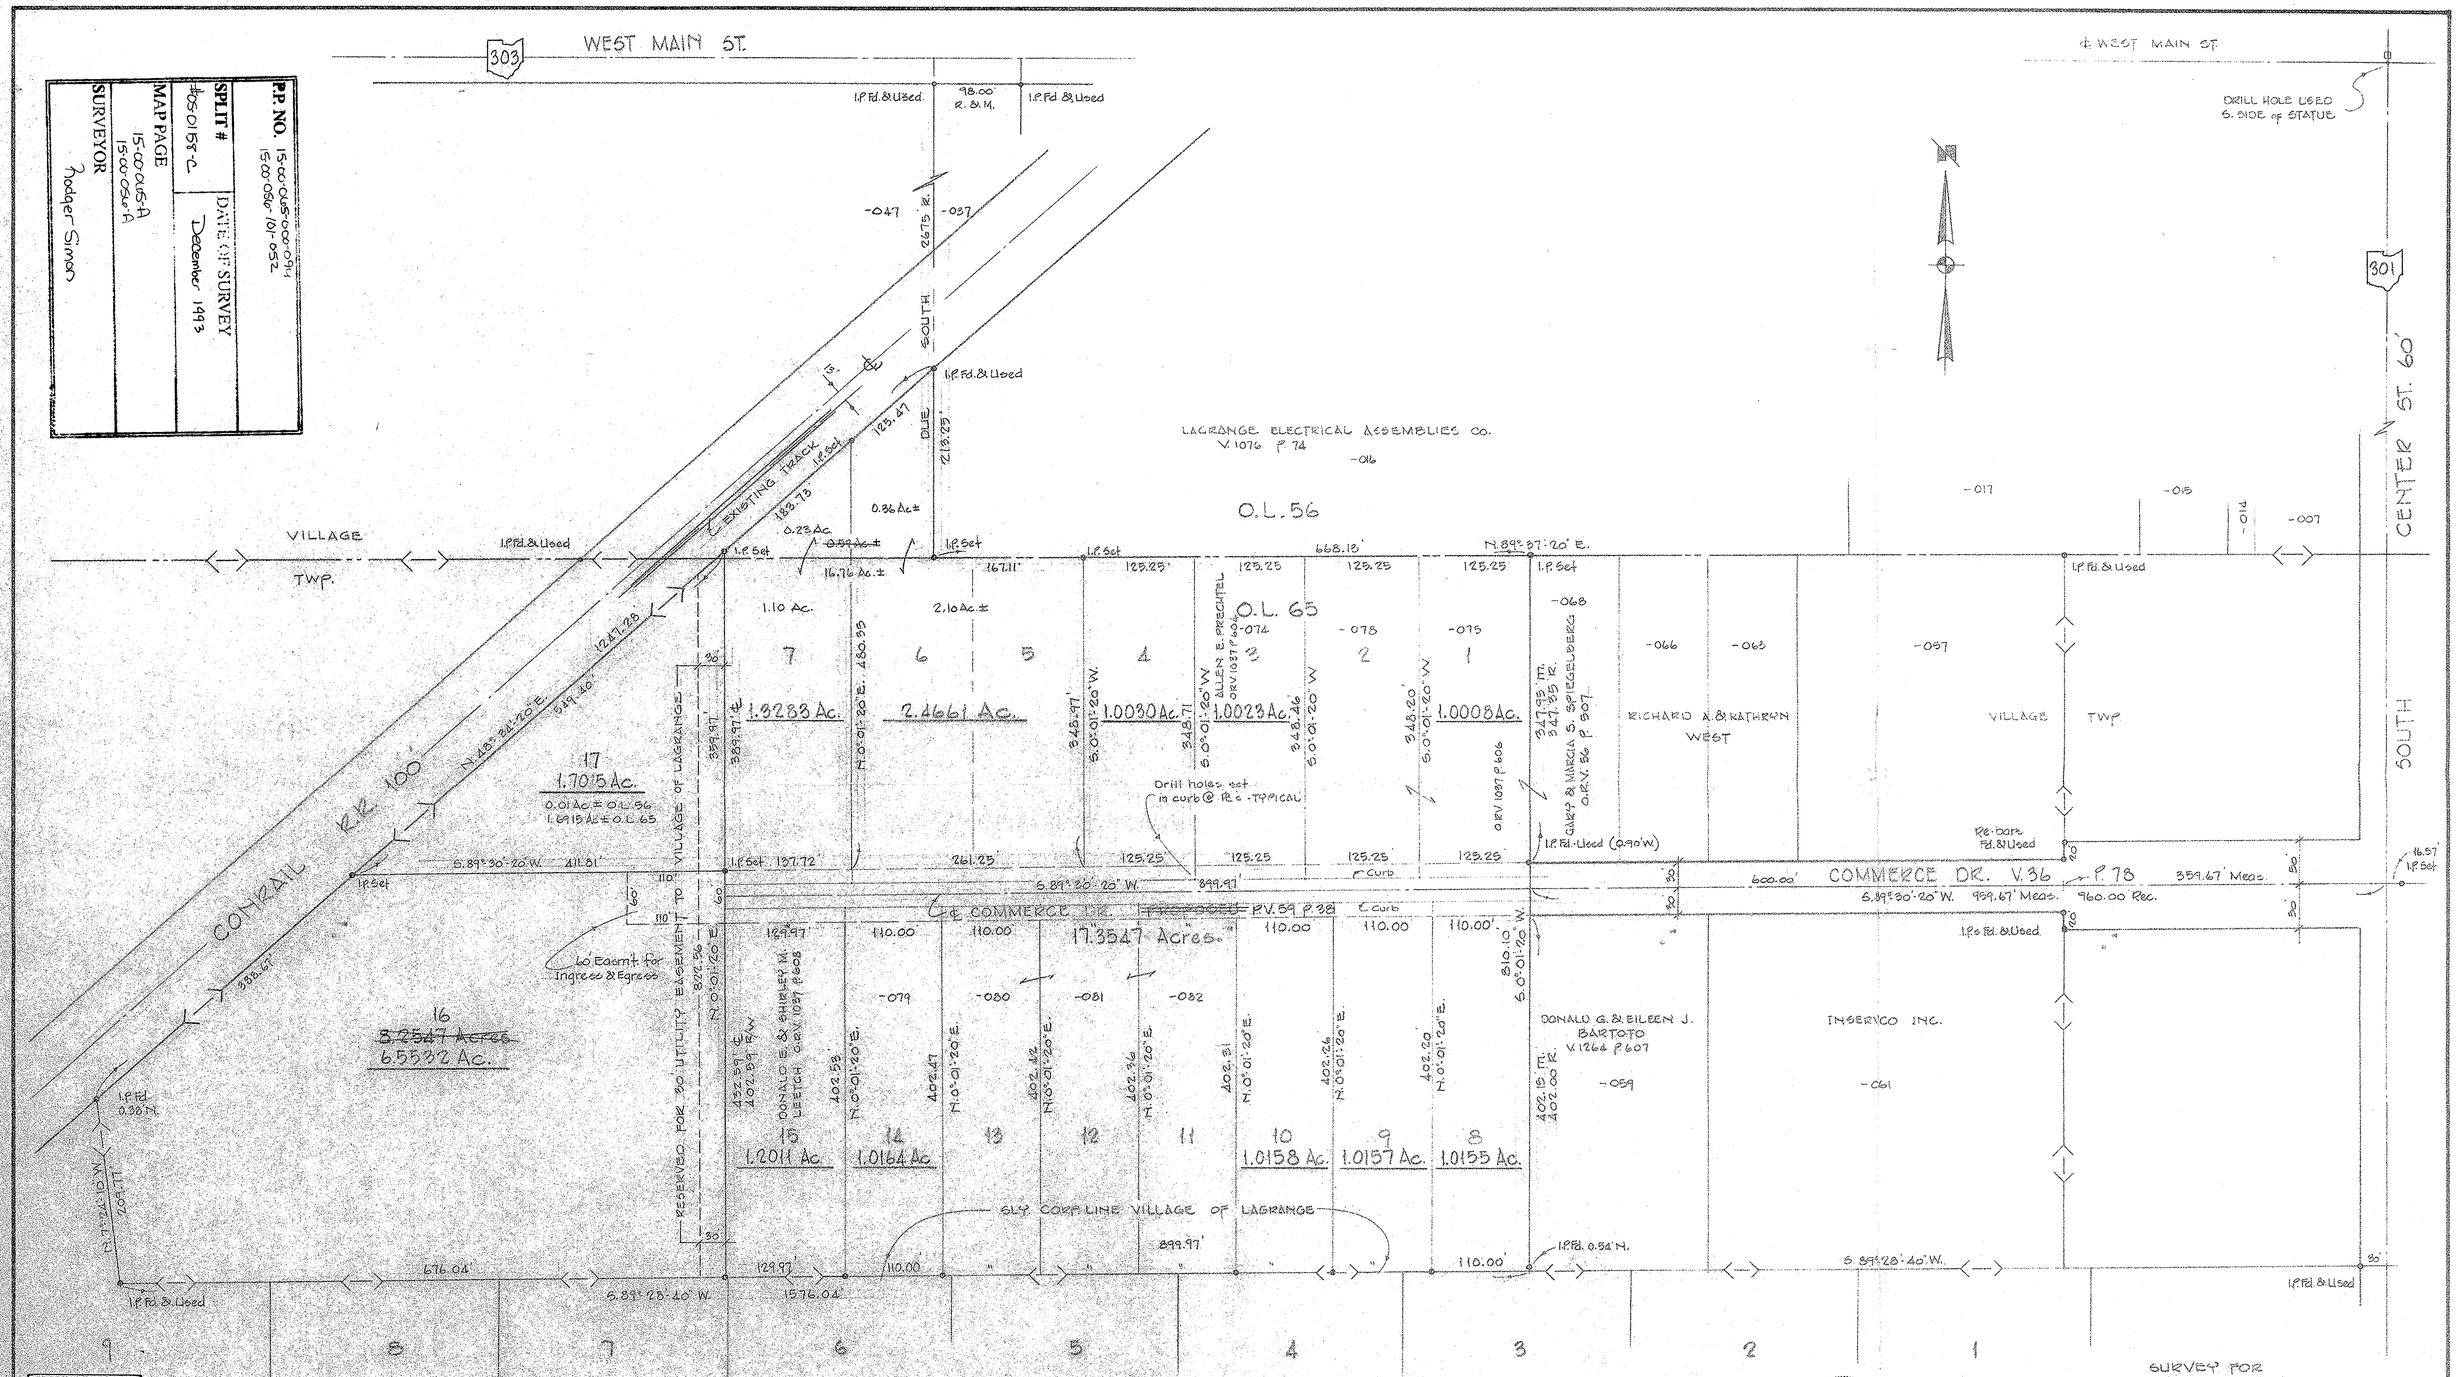

APPROVED
LORAIN CO.
MAP DEPT
DATE 6/21/05
15-00-005-A
PAGE 15-00-056-A
BY D. Holland
dos-0158-C

REV. 4/19/96 Add Pcls. 9 & 10
REV. 4/15/96 Add Pcls. 8 & 17
REV. 10/26/94 Add Pcls. 1, 3, 14 & 15
REV. 10/26/94 Change 2.6260 Ac. to R/W
REV. 8/29/94 Add 2.6460 Ac. Pcl.

STATE OF OHIO
RODGER G. SIMON
5101
REGISTERED SURVEYOR

F.B. 232 P 30-31
JOB No. 93-2504

SURVEY FOR
RICHARD A. & KATHRYN WEST

PART OF O.L.s 56 & 65 TOWNSHIP OF LAGRANGE
VILLAGE OF LAGRANGE COUNTY OF LORAIN STATE OF OHIO
SCALE 1" = 80' DECEMBER, 1993

BY
LAUNDON • SIMON • CAHL & ASSOC.
ENGINEERS SURVEYORS
110 MIDDLE AVE. ELYRIA, O. 44035

300