DATE	REVISIONS	BY

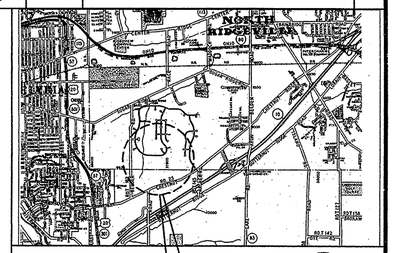

VICINITY MAP

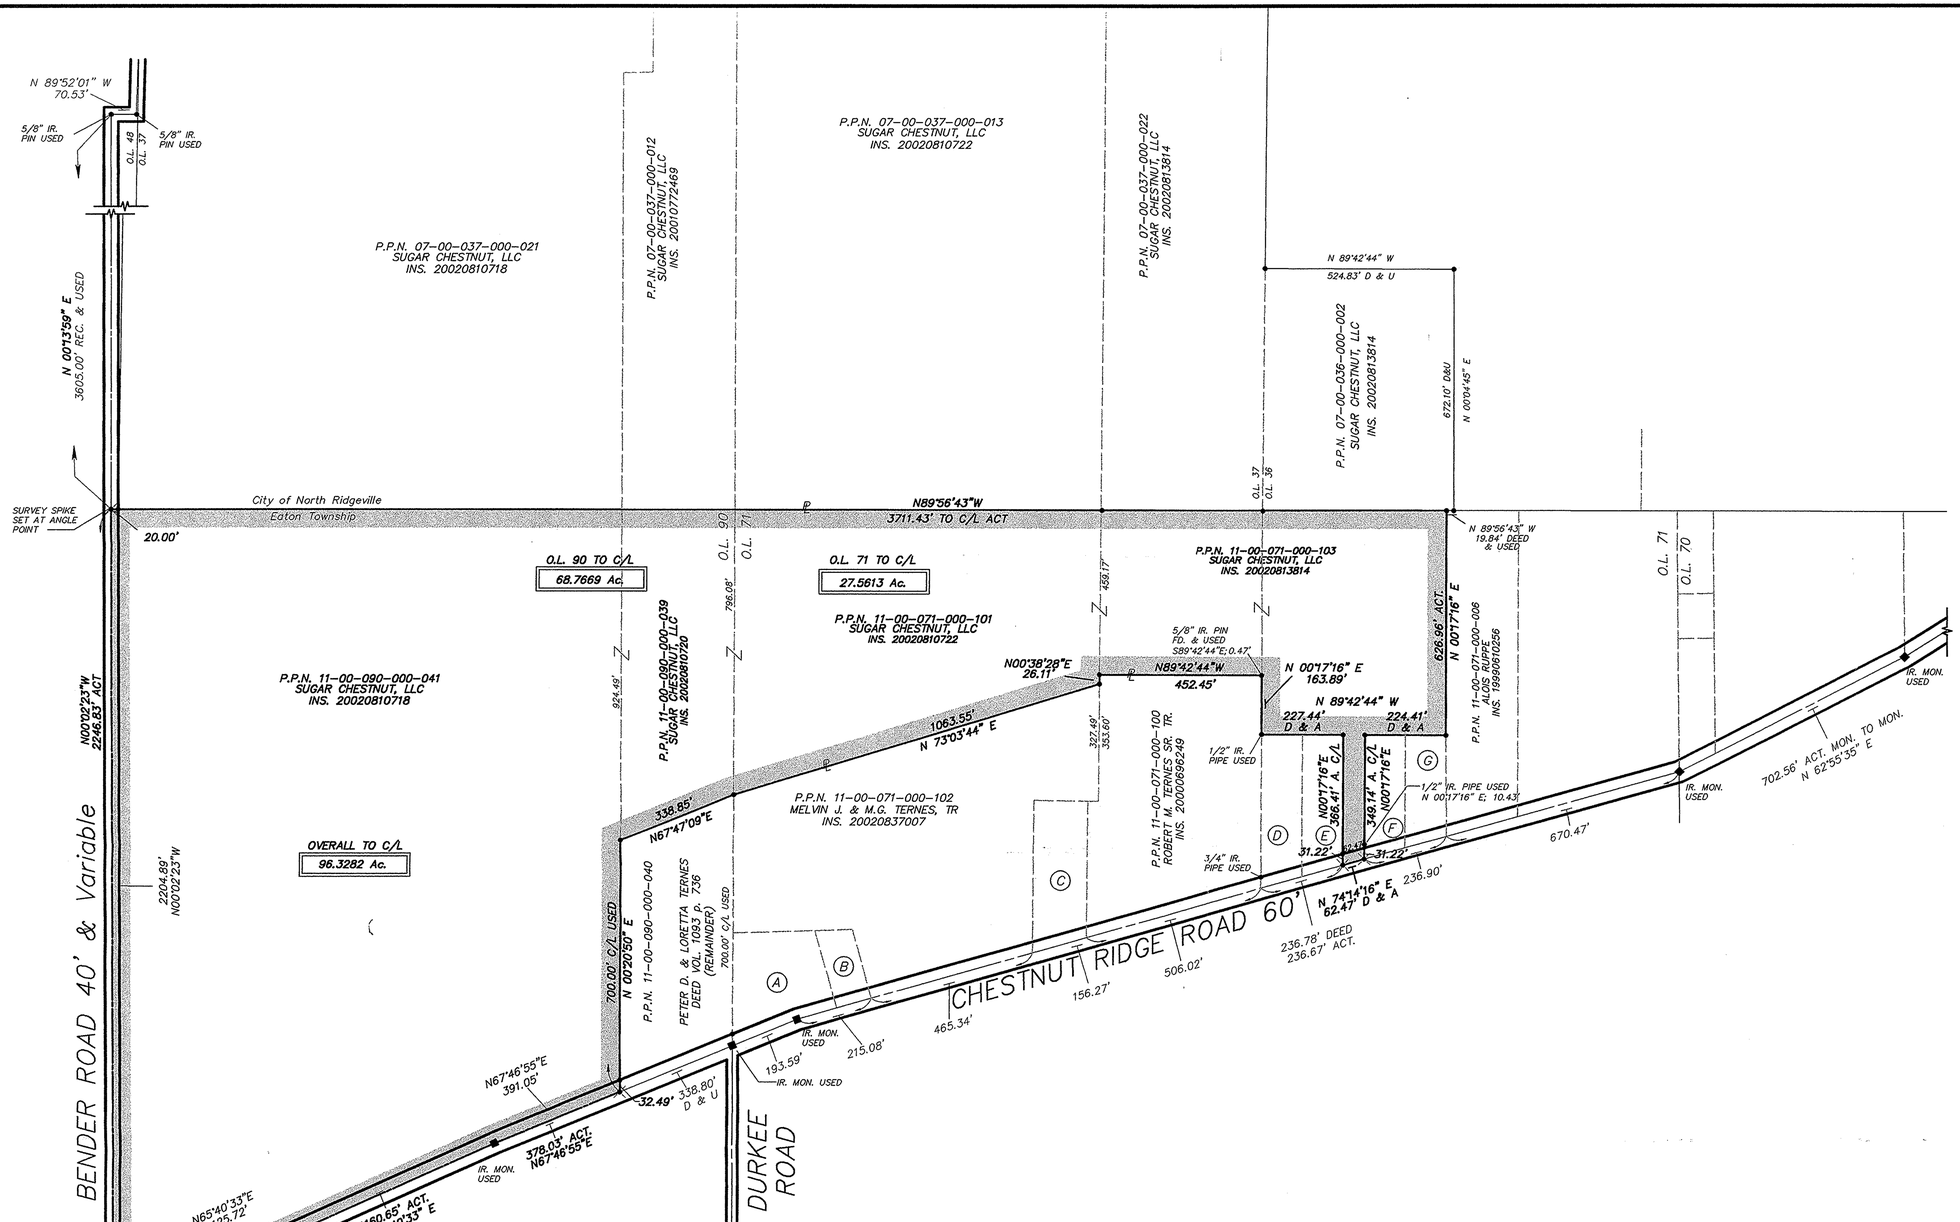

OWNERSHIPS

(A)	11-00-071-000-071	MELVIN H. TERNES & MARIE G. TERNES	176/869 O.R.
(B)	11-00-071-000-056	MELVIN H. & MARIE G. TERNES, TRS.	20020849447
(C)	11-00-071-000-097	JOEL & TRACEY PETERSEN	20000699678
(D)	11-00-071-000-004	HENRY SUNDERMAN & DAWN L. SUNDERMAN	1398/941
(E)	11-00-071-000-005	DONALD T. & DONNA KAY REISZ	20010756154
(F)	11-00-071-000-020	RICHARD W. ADAIR & REBECCA L. ADAIR	996/200 O.R.
(G)	11-00-071-000-016	DAVID E. & AMY L. BROWN	20030974473

NOTES:

• = "IR. PIN SET" INDICATES 5/8" DIAMETER BY 30" LONG REBAR WITH IDENTIFICATION "D.G. BOHNING ASSOC."

⊗ = NAIL SET

SURVEY REFERENCE:
OVERALL SURVEY FOR WATERBURY SUBDIVISION BY DONALD G. BOHNING & ASSOC. INC. FOR SUNRISE DEV. CO. DATED DECEMBER, 1998.

No 01952
APPROVED
LORAIN CO.
MAP DEPT
DATE 7-11-05
PAGE 11-A
11-00-071-A
BY J Hatfield
05-01952

MAP OF SURVEY AND CONSOLIDATION MADE FOR AND AT THE INSTANCE OF SUGAR CHESTNUT, LLC

BEING PART OF ORIGINAL EATON TOWNSHIP LOTS 71 AND 90

NOW IN EATON TOWNSHIP
LORAIN COUNTY, OHIO

DISTANCES ARE GIVEN IN FEET AND DECIMAL PARTS, THEREOF; BEARINGS ARE REFERENCED TO AN ASSUMED MERIDIAN AND ARE USED TO INDICATE ANGLES ONLY.

STATE OF OHIO
KENNETH L. BOHNING
6720
REGISTERED
SURVEYOR

KENNETH L. BOHNING
REGISTERED SURVEYOR NO. 6720
7/23/05
DATE

DONALD G. BOHNING & ASSOCIATES, INC.
CIVIL ENGINEERING & SURVEYING
7979 HUB PARKWAY * VALLEY VIEW, OHIO 44125
PHONE: (216) 642-1130 FAX: (216) 642-1132

HORIZ. SCALE	DR'N	CKD.	DATE	
1"=200'	M.D.	K.B.	FEB., 2005	1/1
GR. SCALE 0' 100' 200'	FILE NO. 287342LC		ORDER NO. 2873-42	

B:\autocad\N\2873-42\dwg\287342lc.dwg 5/27/2005 11:36:12 AM EDT