MAP OF PERIMETER SURVEY

PREPARED FOR

JAMES L. HARTMAN

SITUATED IN THE TOWNSHIP OF ROCHESTER, COUNTY OF LORAIN, STATE OF OHIO AND BEING KNOWN AS PART OF ORIGINAL ROCHESTER TOWNSHIP TRACT 5, LOT 30 AND ALSO BEING ALL OF THE THOSE LANDS DEEDED TO JAMES L. HARTMAN IN DEED INSTRUMENT #20040992901 OF LORAIN COUNTY DEED RECORDS.

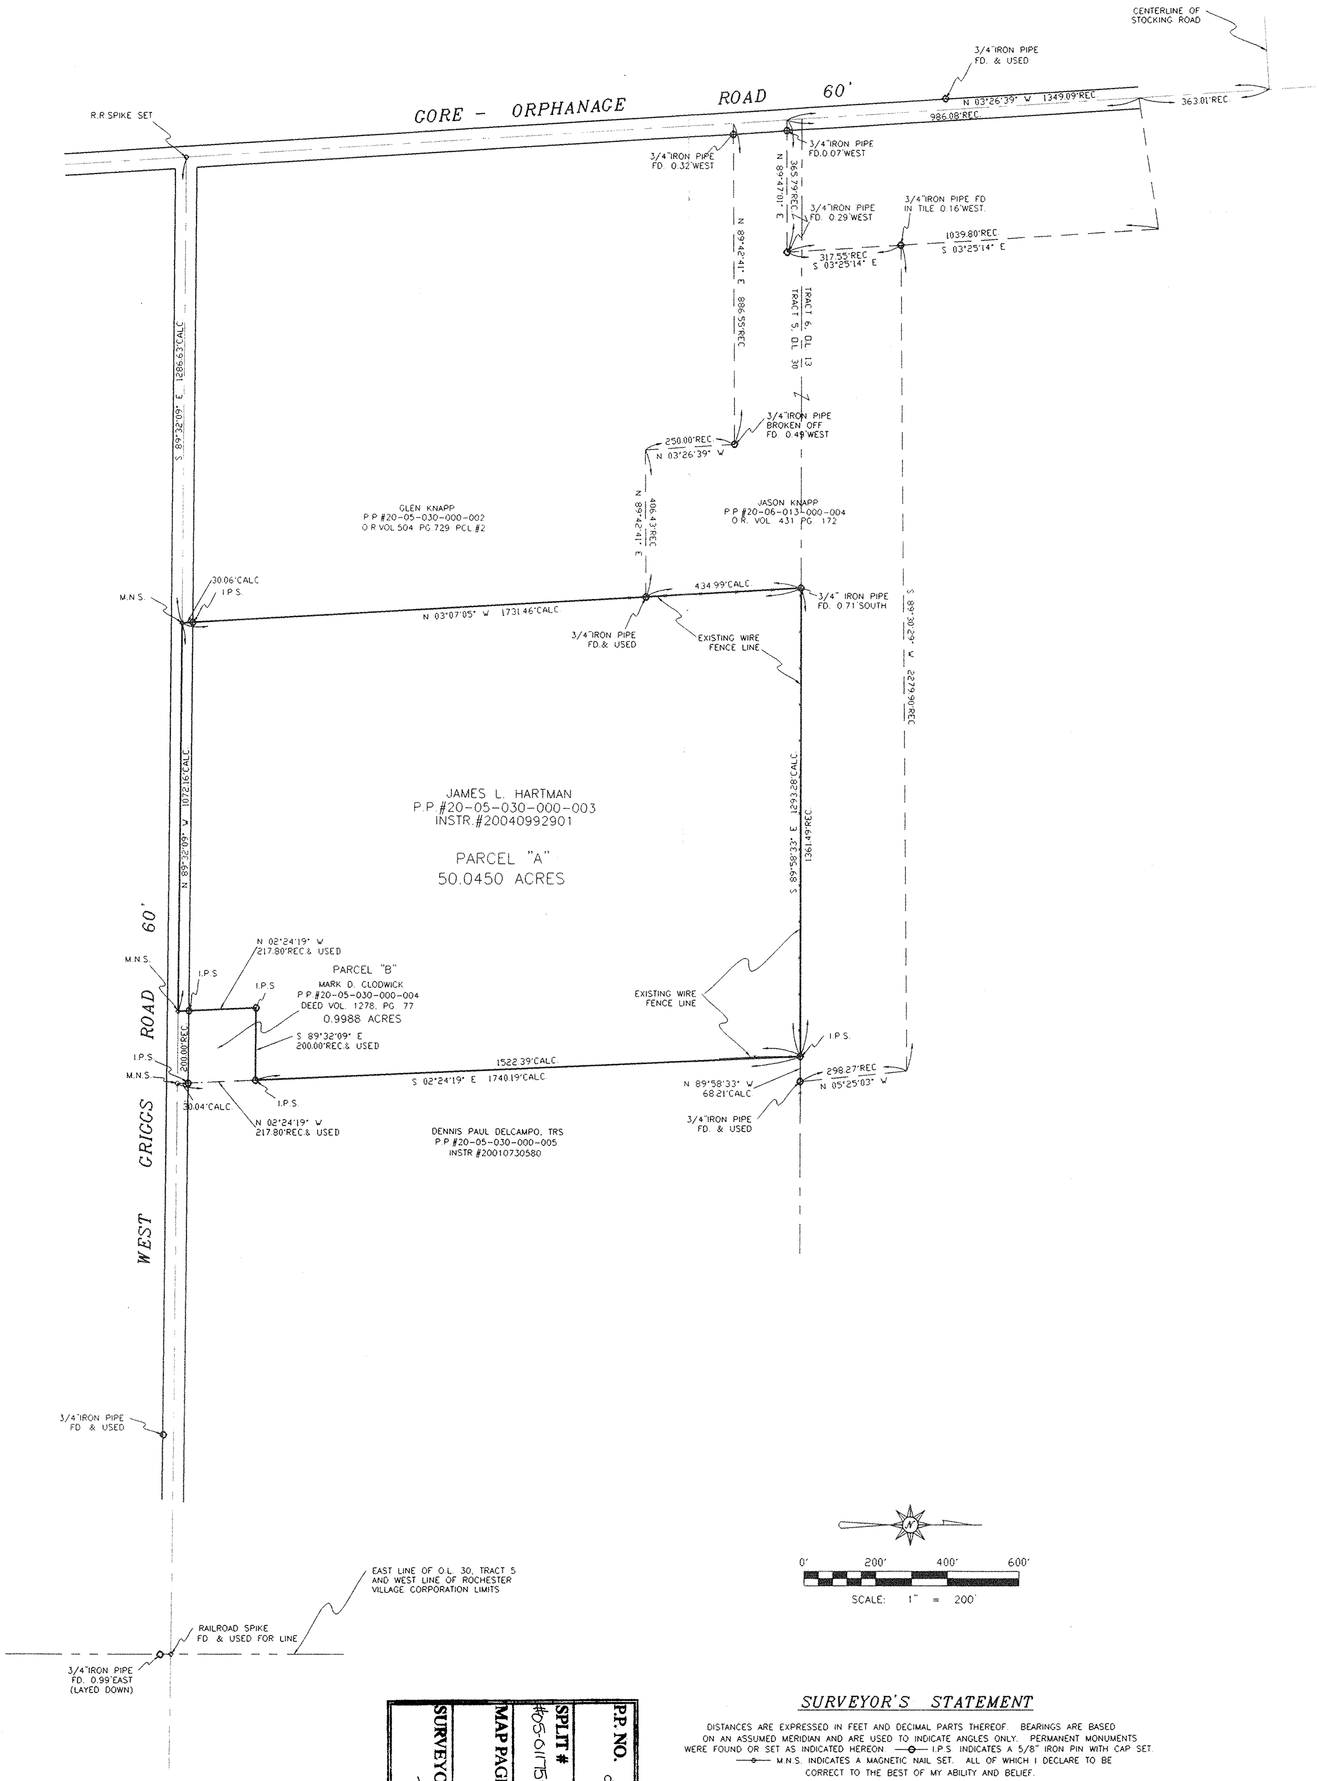

SURVEYOR'S STATEMENT

DISTANCES ARE EXPRESSED IN FEET AND DECIMAL PARTS THEREOF. BEARINGS ARE BASED ON AN ASSUMED MERIDIAN AND ARE USED TO INDICATE ANGLES ONLY. PERMANENT MONUMENTS WERE FOUND OR SET AS INDICATED HEREON. —o— I.P.S. INDICATES A 5/8" IRON PIN WITH CAP SET. —◇— M.N.S. INDICATES A MAGNETIC NAIL SET. ALL OF WHICH I DECLARE TO BE CORRECT TO THE BEST OF MY ABILITY AND BELIEF.

THOMAS M. SNEZEK, R.L.S. 7051 — DATE 6-27-05

STATE OF OHIO — THOMAS M. SNEZEK 7051 — SURVEYOR

P.P. NO.	20-05-030-000-003
SPLIT #	465-01175-C
DATE OF SURVEY	June 2005
MAP PAGE	80-B
SURVEYOR	Thomas M. Snezek

APPROVED LORAIN CO. MAP DEPT.
DATE 7/8/05
PAGE 80-B
BY: D.H.Ward
465-01175-C

PROJECT #0510 FINAL 6/28/05