MAP OF PERIMETER SURVEY

PREPARED FOR

JAMES L. HARTMAN

SITUATED IN THE TOWNSHIP OF ROCHESTER, COUNTY OF LORAIN, STATE OF OHIO AND BEING KNOWN AS PART OF ORIGINAL ROCHESTER TOWNSHIP TRACT 5, LOT 30 AND ALSO BEING ALL OF THE THOSE LANDS DEEDED TO JAMES L. HARTMAN IN DEED INSTRUMENT #20040992901 OF LORAIN COUNTY DEED RECORDS.

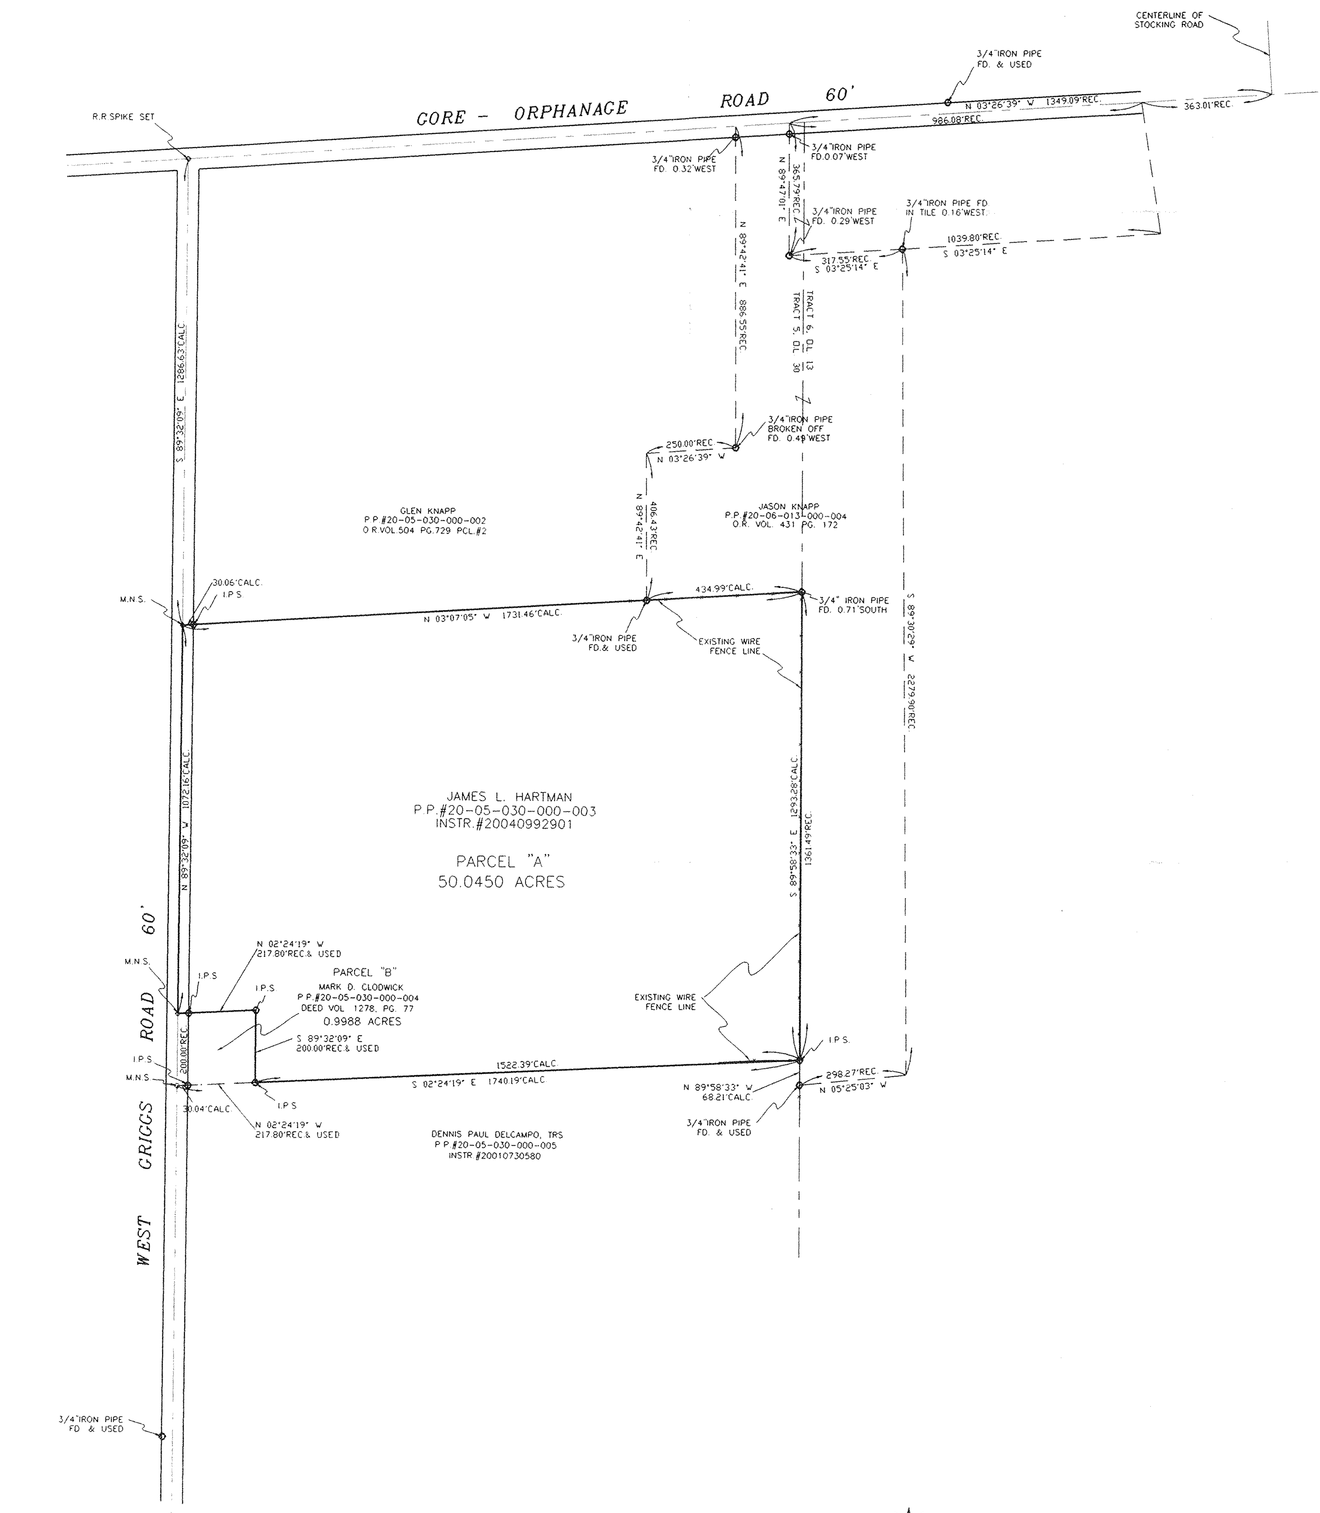

SURVEYOR'S STATEMENT

DISTANCES ARE EXPRESSED IN FEET AND DECIMAL PARTS THEREOF. BEARINGS ARE BASED ON AN ASSUMED MERIDIAN AND ARE USED TO INDICATE ANGLES ONLY. PERMANENT MONUMENTS WERE FOUND OR SET AS INDICATED HEREON. —O— I.P.S. INDICATES A 5/8" IRON PIN WITH CAP SET. —•— M.N.S. INDICATES A MAGNETIC NAIL SET. ALL OF WHICH I DECLARE TO BE CORRECT TO THE BEST OF MY ABILITY AND BELIEF.

THOMAS M. SNEZEK, R.L.S. 7051

6-29-05
DATE

PROJECT #0510 FINAL 6/28/05