SURVEY
OF
7.3508 ACRES
OF PART OF
ORIGINAL AVON TOWNSHIP SECTION NO. 8
NOW IN THE CITY OF AVON LAKE
LORAIN COUNTY, OHIO
FOR
ALLAN, BARBARA, & LEE KLINGSHIRN
BY

THE HENRY G. REITZ ENGINEERING COMPANY
4214 ROCKY RIVER DR., CLEVELAND, OH. 44135
PH: (216) 251-3033, FAX: (216) 251-5149
BY: V. PRESIDENT
JAMES T. SAYLER, REG. SURVEYOR NO. S-7425

STATE OF OHIO
JAMES T. SAYLER
S-7425
REGISTERED
PROFESSIONAL SURVEYOR

SCALE 1" = 60'
OCTOBER, 2004

REVISED 2-24-05
ADDED R/W FOR
WATER EASMENT

GRAPHIC SCALE
0 30 60 120
SCALE: 1" = 60'

N
BASED ON BEARING
SYSTEM USED FOR
WATERSIDE CROSSING
SOUTH PLATS

LEGEND
O DENOTES 5/8" CAPPED
(REITZ ENG.) IRON PIN SET

04-00-008-101-047
KOPF CONSTRUCTION CORP.
INST. # 20000714436

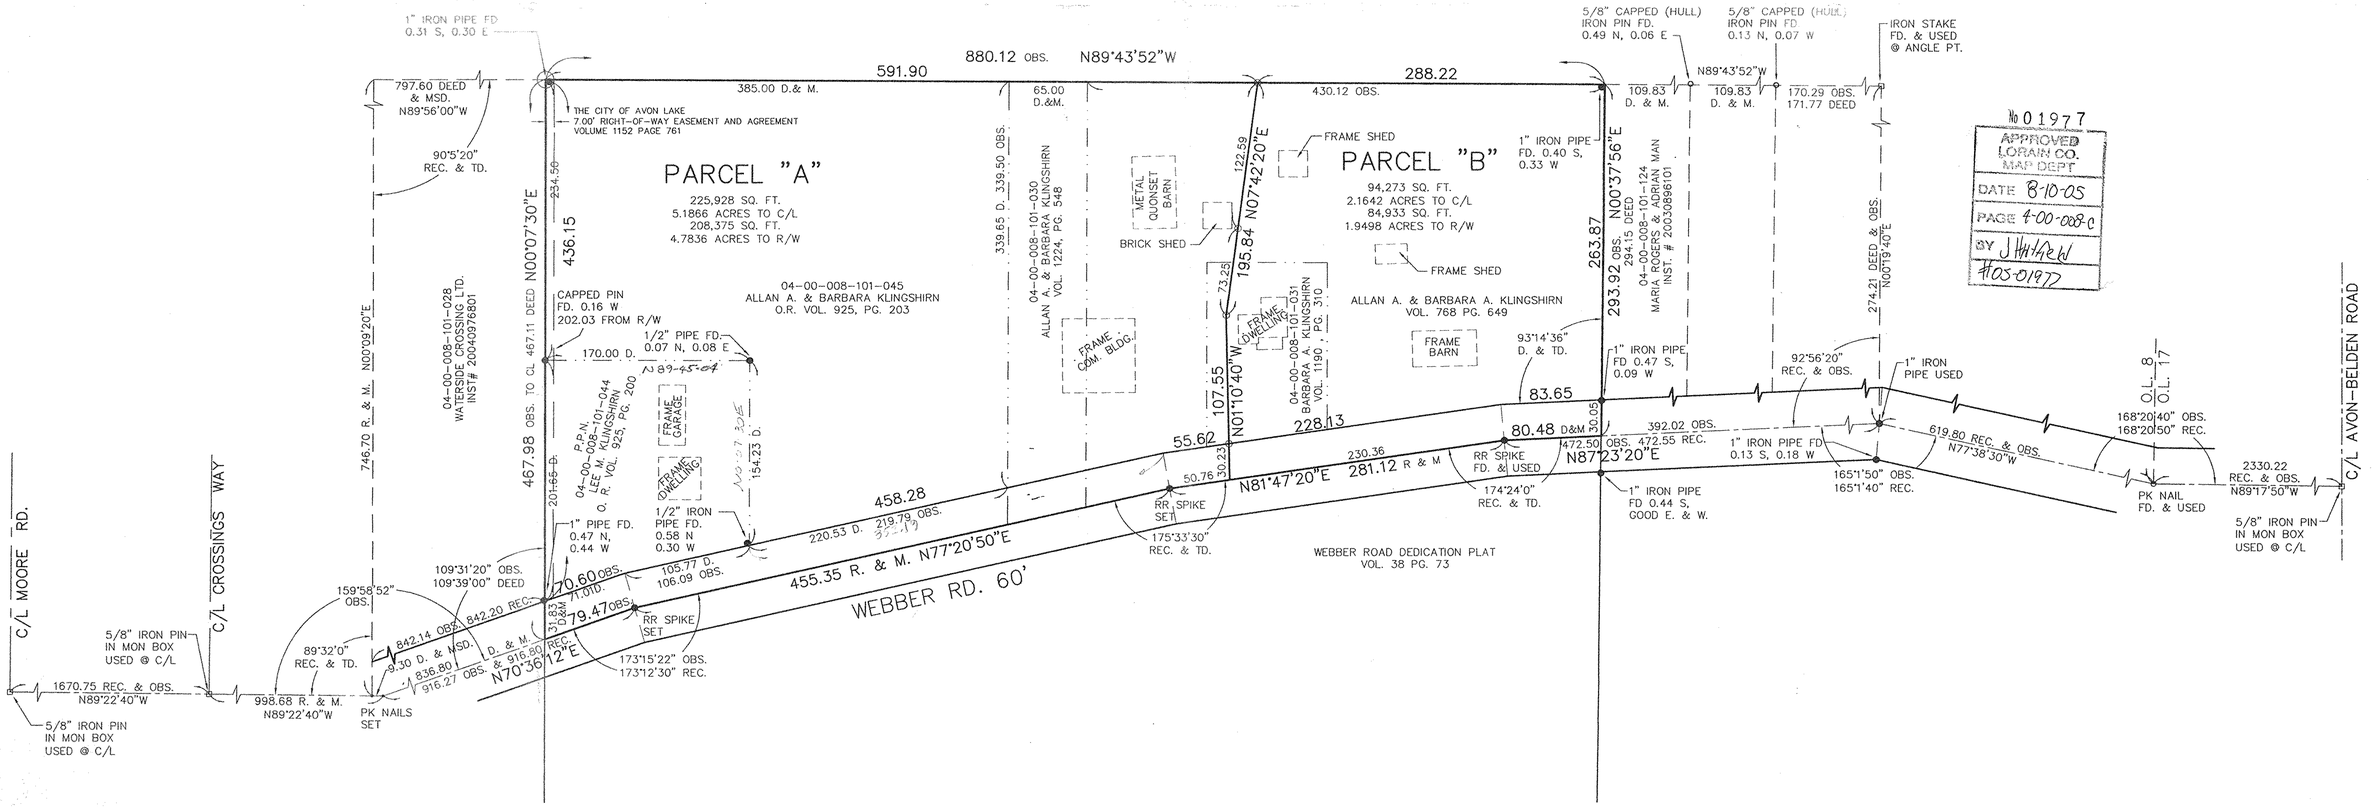

L:\Jobs\Surveys\AVONLAKE\WEBBER RD-KLINGSHIRN\Klng.mb