Plat of Survey
for
Twin Creek Farms, Inc.
O.R. 244 P. 235 — 70.94 Ac.
Carlisle Twp. — Section 19
Lorain Co. — Ohio

Carlson Surveys
February 2005

Scale: 1" = 100'

Rev. 4-8-05 Pcl. 4 & 7 Per County Engineer comments.
Rev. 4-25-05 Pcl. 4 & 7

STATE OF OHIO — RICHARD D. CARLSON 7496 — REGISTERED SURVEYOR — 4-25-05

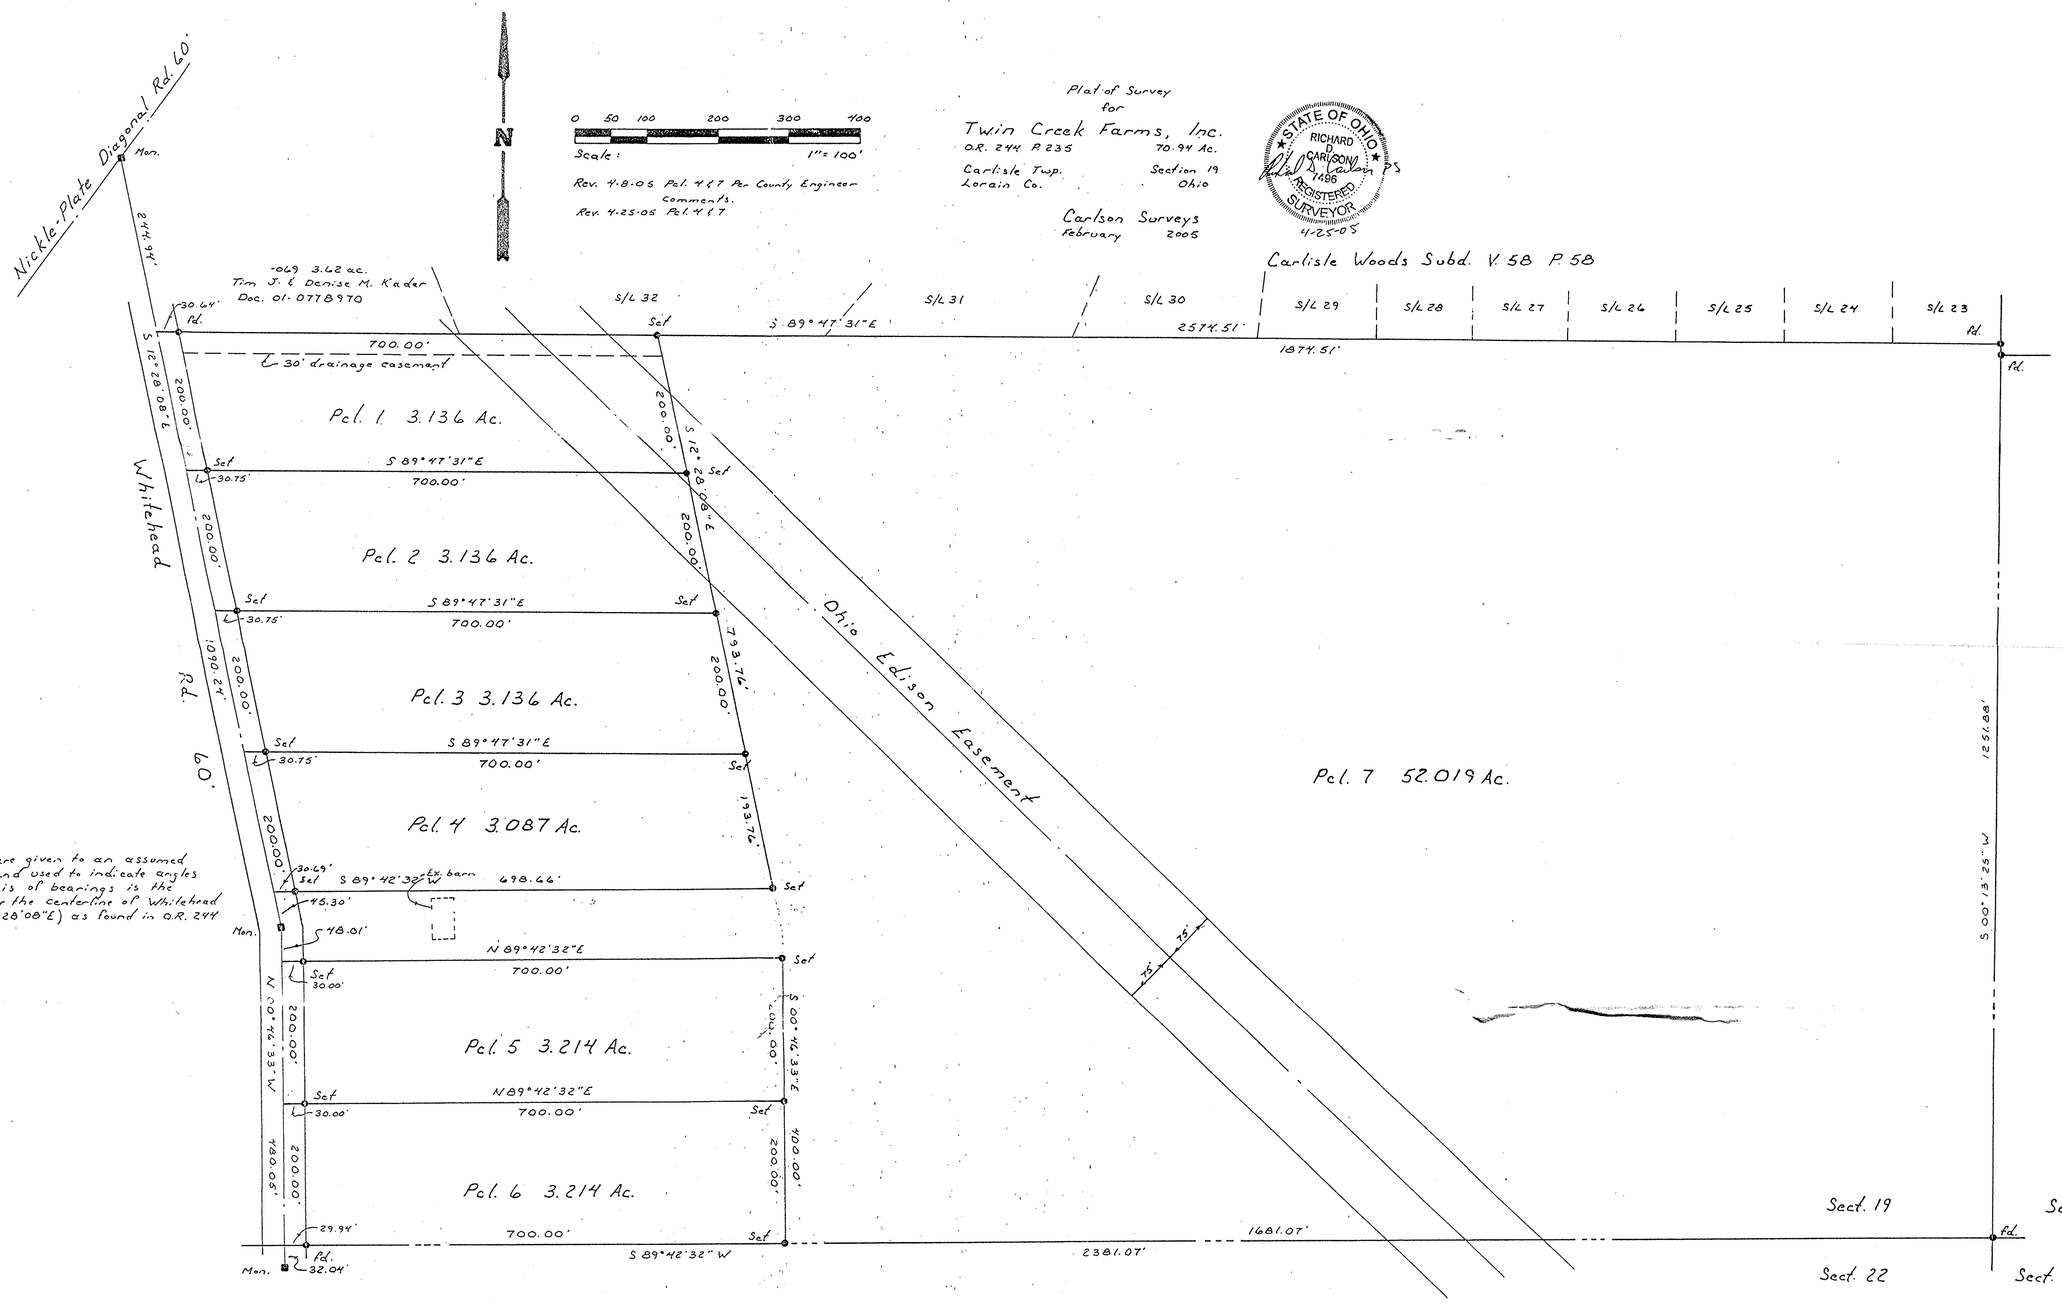

Bearings are given to an assumed meridian and used to indicate angles only. Basis of bearings is the bearing for the centerline of Whitehead Road (S 12°28'08"E) as found in O.R. 244 P. 235

No 01985
APPROVED
LORAIN CO.
MAP DEPT.
DATE 8-19-05
PAGE 10-00019-H
BY JHatfield
05-01985