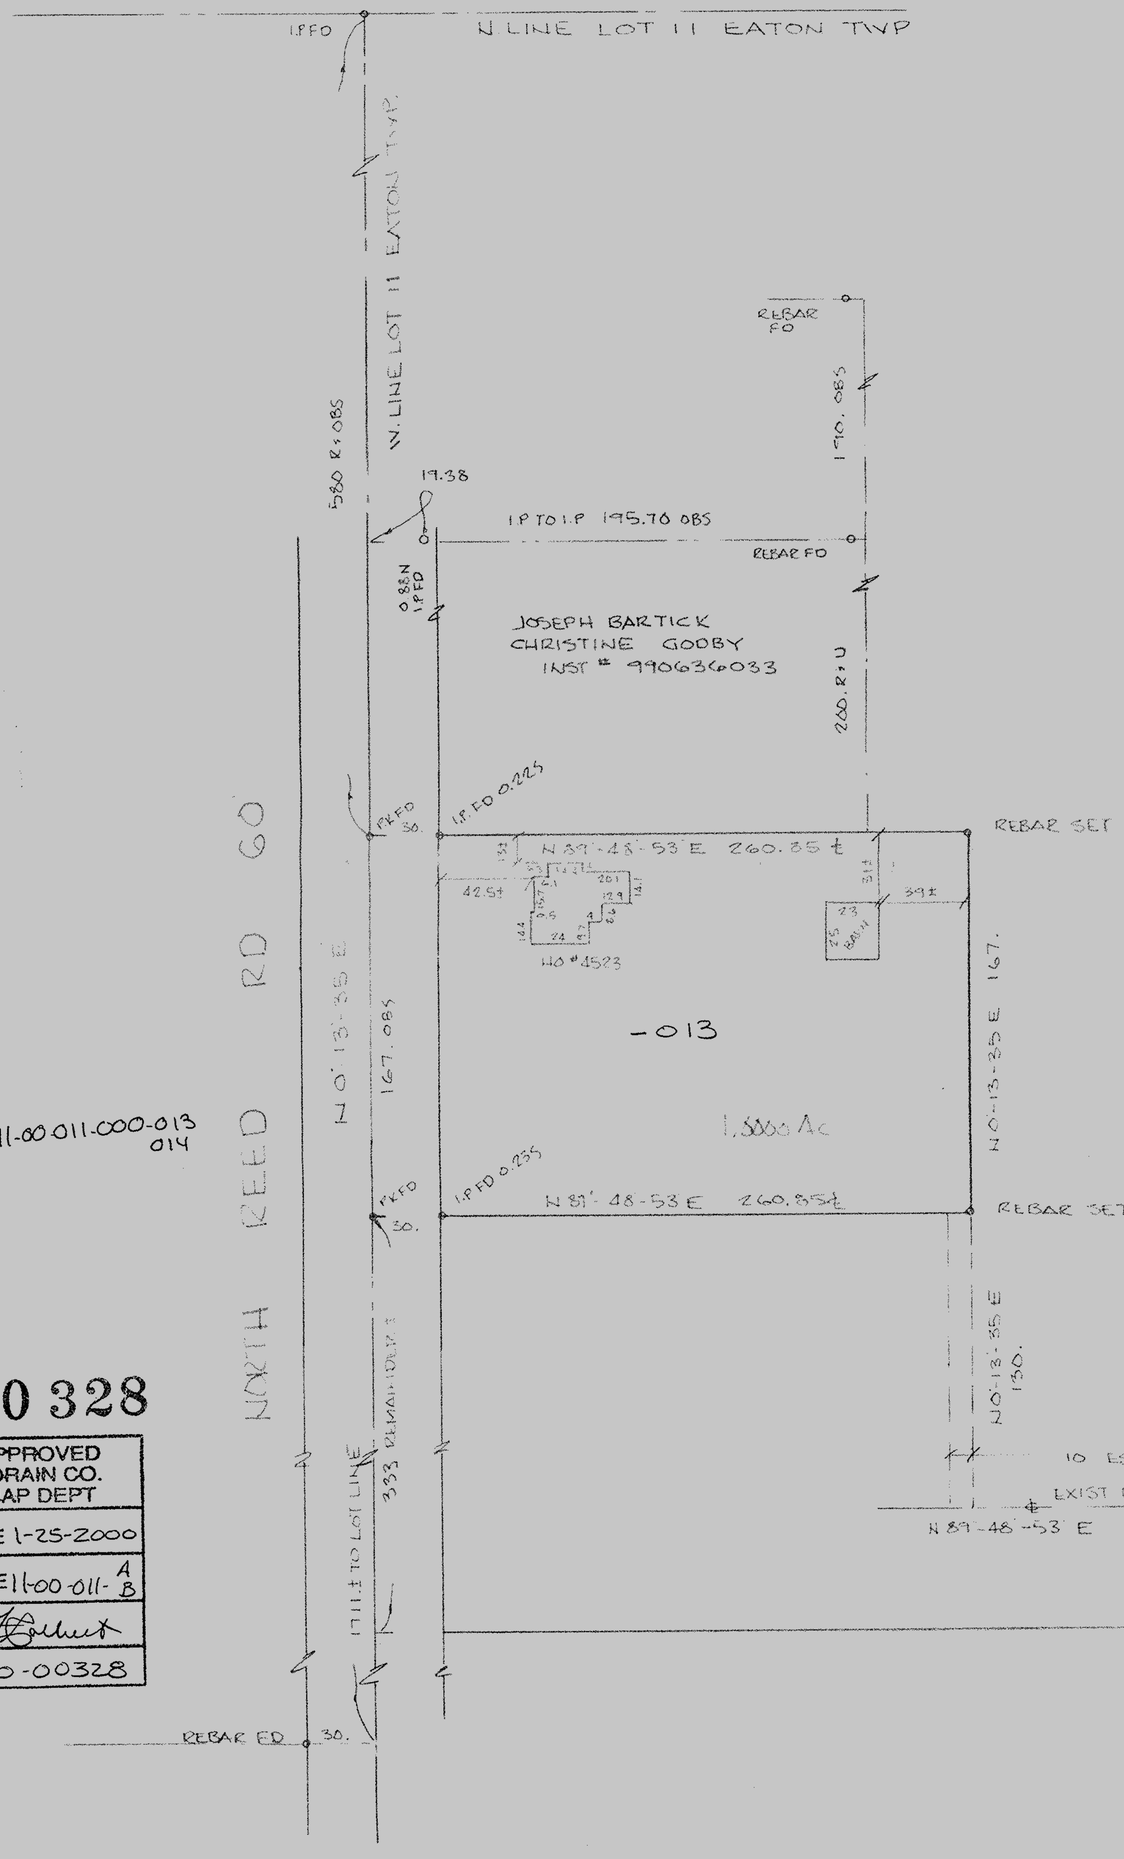

PPN: 11-00 011.000-013
014

#00 328

APPROVED LORAIN CO. MAP DEPT
DATE 1-25-2000
PAGE 11-00-011- A B
BY
#00-00328

N

DATE: DEC. 1999
SCALE: 1" = 50'

REMAINDER
PCL # 11-00-011-000-010
58.19 Ac.

SURVEY
of PART OF
ORIGINAL EATON TWP No 11
COUNTY OF LORAIN STATE OF OHIO

PREPARED FOR:
JOSEPH BARTICK
AND
CHRISTINE GODBY
9521 N REED RD

PREPARED BY
HAPONEK & ASSOC
SURVEYORS
N RIDGEVILLE, OH.

99-19