PPN. 01-00-013-000-000.001

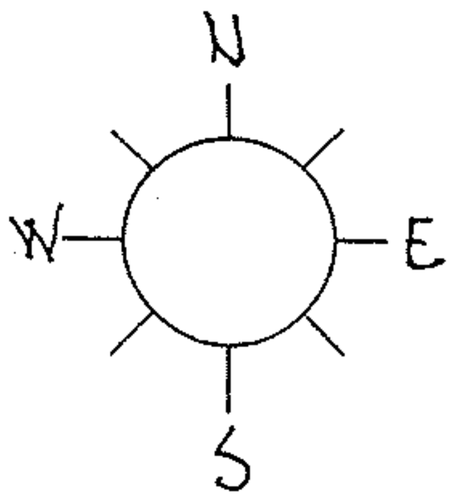

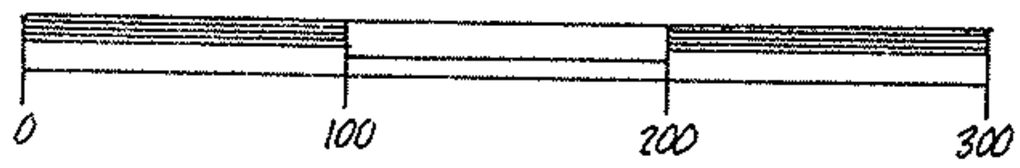

NORTH LINE OF ORIGINAL LOT 12

IRON PIN FOUND

R.R. SPIKE FOUND 8" WEST & 4" SOUTH OF TRUE CORNER

1160.40' EDM

75.00'

P.K. NAIL

℄ 50-FT. EASEMENT

175.00'

P.K. NAIL

ROBERT S. JURSINSKI (GRANTOR) VOL. 1087 PG. 142

IRON PIN SET

S 87°34'10"E, 298.41'

150.00'

148.41'

IRON PIN SET

2'

ALVIN F. & LAUREL J. FRESH VOL. 1346 PG. 803

N 2°25'50"E, 262.50'

0.904 AC.

N 2°25'50"E, 262.50'

0.919 AC.

N 0°38'00"E, 262.63'

165.00'

ROAD

P.K. NAIL

ROBERT S. & ROSALIE C. JURSINSKI O.R. VOL. 1284 PG. 802

165.00'

SUNNYSIDE

1665.40' TO NORTH LINE O.L. 12

IRON PIN SET

150.00'

156.65'

S 87°34'10"E, 306.65'

435.82'

P.K. NAIL

℄ EASEMENT

P.K. NAIL

ROBERT S. JURSINSKI

N 0°38'00"E

MONUMENT

APPROVED LORAIN CO. MAP DEPT
DATE 1-24-2000
PAGE 1-B
BY [signature]
#99-00313

#00313

acreage	1.823
date	OCT.-99
drawn	MGH
scale	1" : 100

STATE OF OHIO
M. G. HURA
No. 4712
REGISTERED PROFESSIONAL SURVEYOR

prepared for BOB JURSINSKI

MICHAEL G. HURA, REGISTERED SURVEYOR
12706 Mason Road, Vermilion Ohio (216) 965-4040

PERIMETER SURVEY

SUBLOT(s) _____ OF _____

_____ Volume ____ Page ____ of PLATS

PART of O.L. 12 Tract _____ Section _____ of

BROWNHELM TOWNSHIP LORAIN CO., OHIO

City of ~~Village of~~ VERMILION