PPN.
05-00-026-102-058 & 059

MAP OF SURVEY
FOR
THE OHIO TURNPIKE COMMISSION
PARCEL ACQUISITION FROM RICHARD A. & KATHLEEN S. GRAHAM

SITUATED IN THE CITY OF AMHERST, COUNTY OF LORAIN, AND STATE OF OHIO
AND KNOWN AS BEING PART OF ORIGINAL AMHERST TOWNSHIP LOT NO. 26

IRON PIN MONUMENTS WERE FOUND OR SET AS SHOWN HEREON.
ALL DIMENSIONS ARE EXPRESSED IN FEET AND DECIMAL PARTS.
BEARINGS ARE TO AN ASSUMED MERIDIAN AND ARE USED TO
SHOW ANGLES ONLY. I DECLARE THIS TO BE A TRUE RETURN OF
A FIELD SURVEY BY ME CORRECT TO THE BEST OF MY ABILITY AND BELIEF.

Western Reserve Engineering and Surveying Company
5605 Valley Belt Road, Independence, Ohio 44131 (216) 398-6400

#00 280

APPROVED LORAIN CO. MAP DEPT
DATE 2-17-2000
PAGE 5-00-026B
BY
#00-00280

WILLIAM J. VONDRA
PROFESSIONAL SURVEYOR NO. 5849

STATE OF OHIO — WILLIAM J. VONDRA 5849 REGISTERED PROFESSIONAL SURVEYOR

GRAPHIC SCALE
(IN FEET)
1 inch = 60 ft.

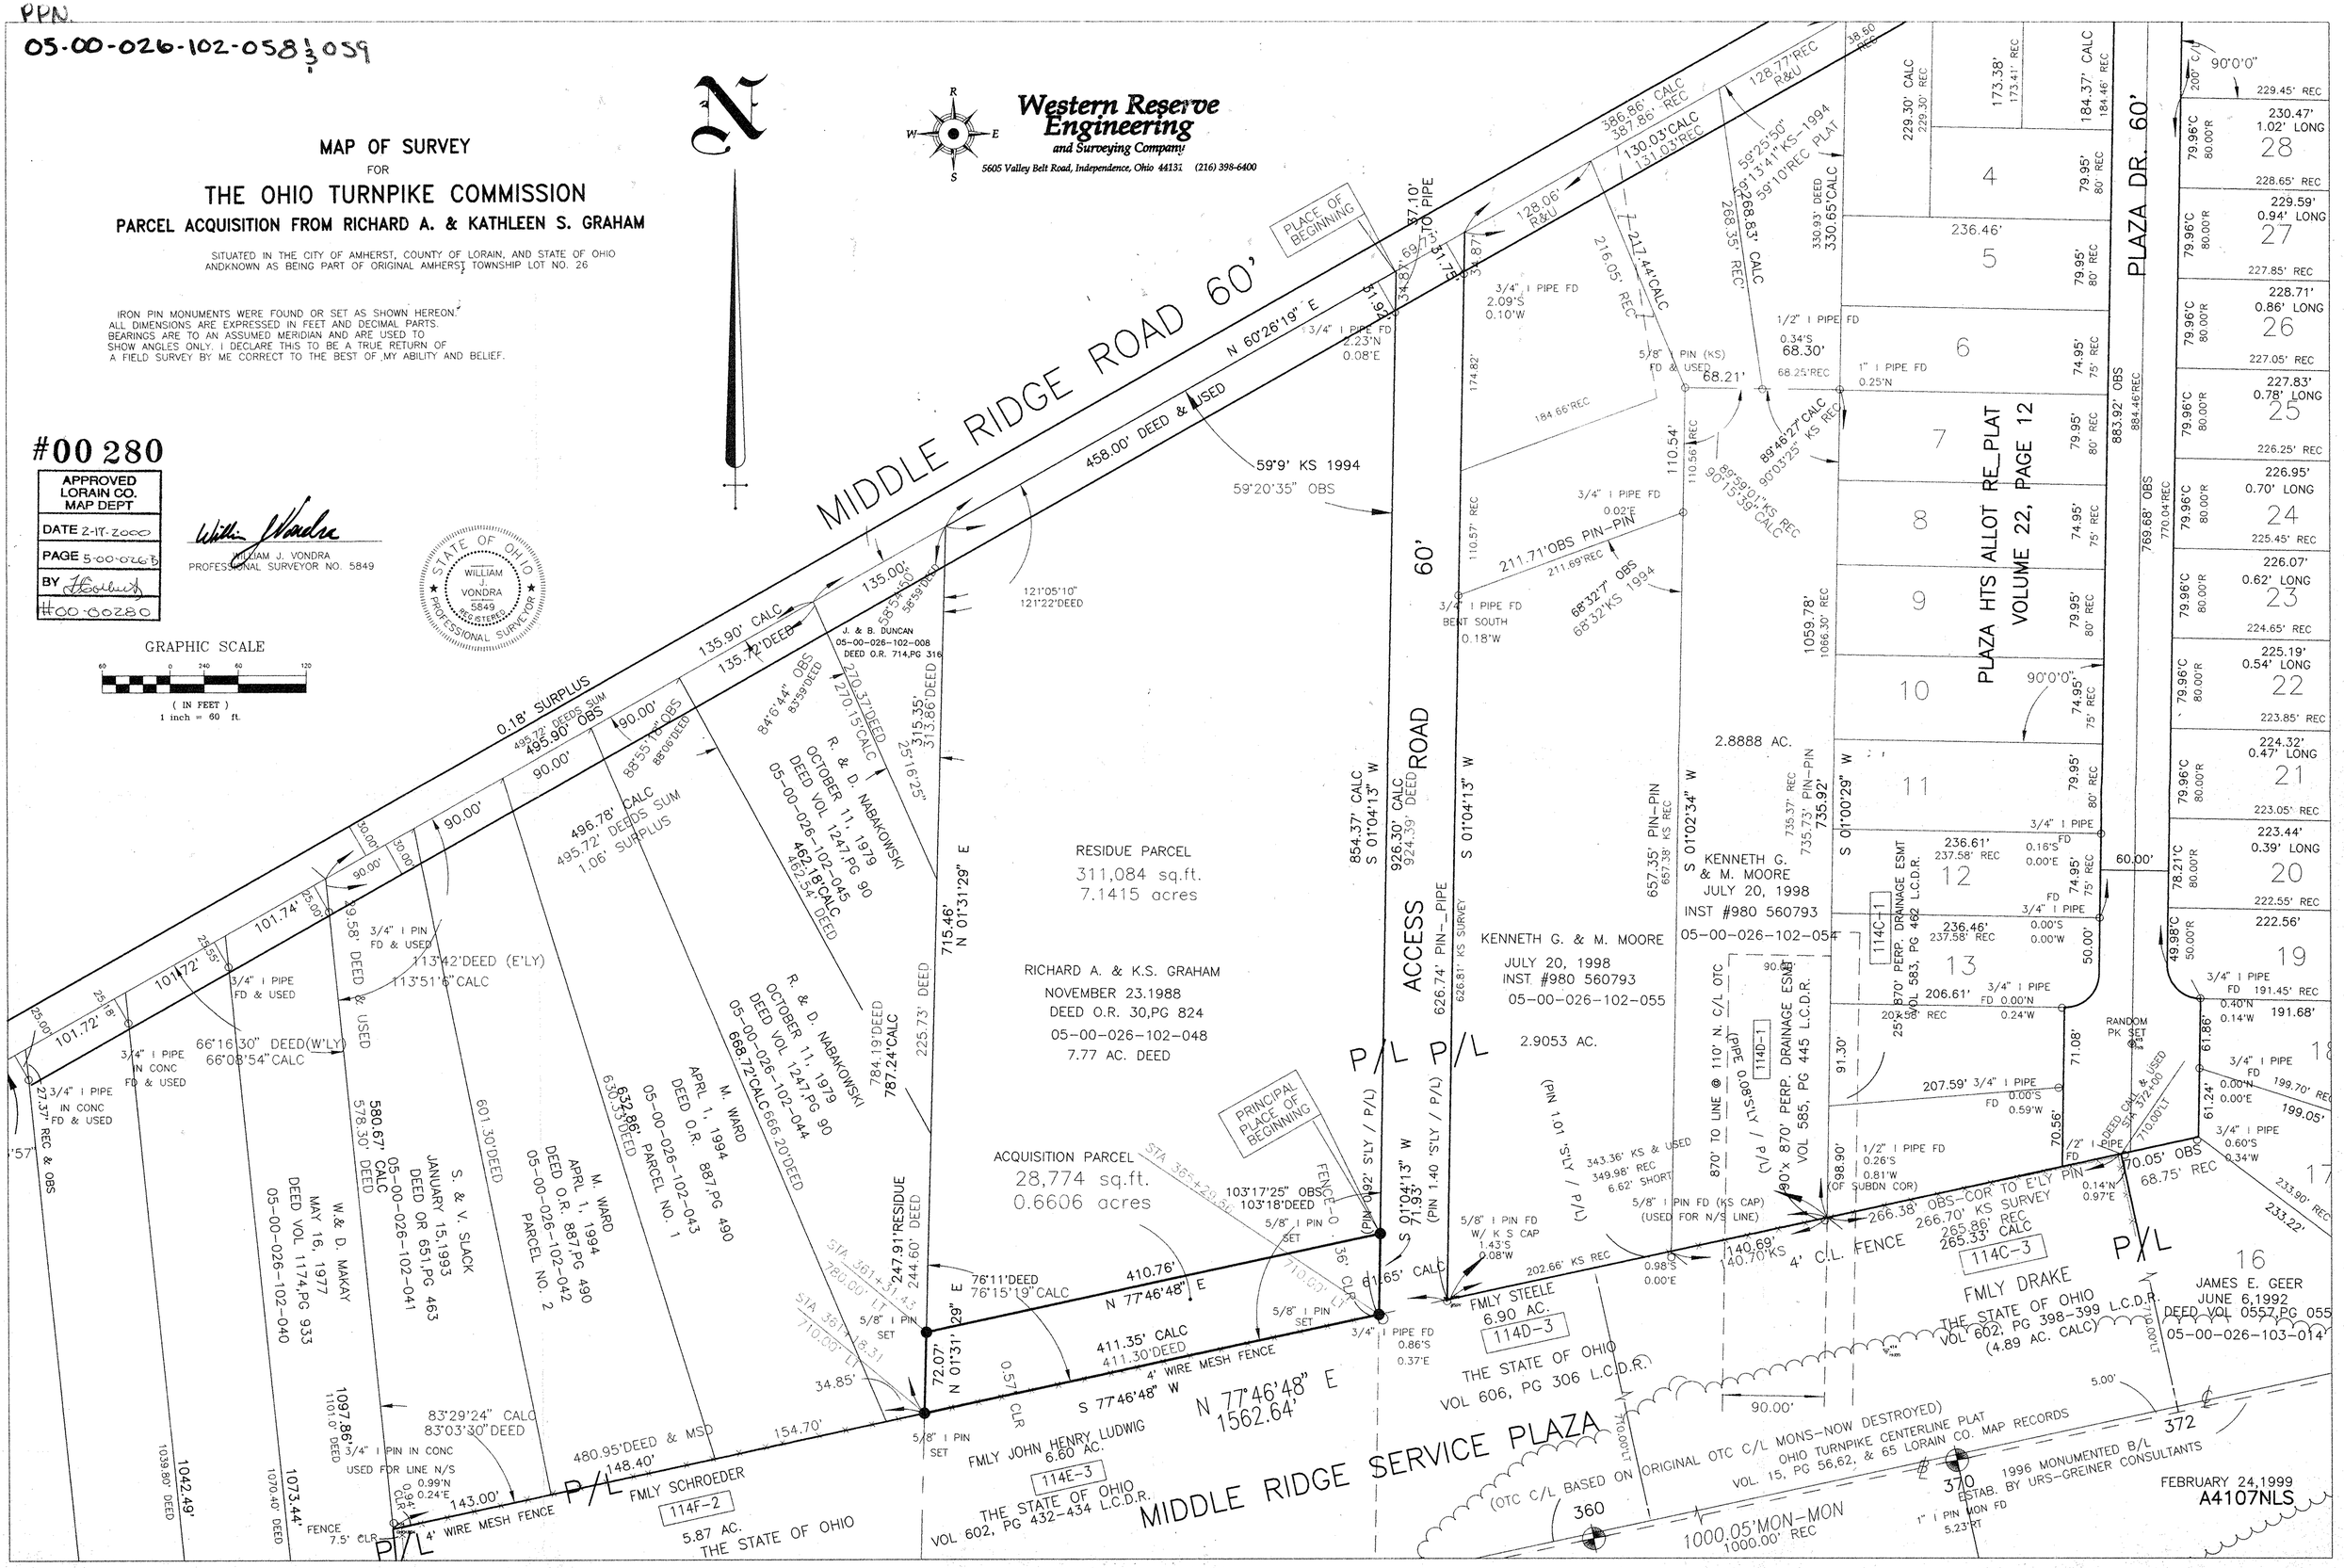

C:\ACAD\DWG\A4100A_2\A4107\A4107NLS Fri Jan 14 12:28:55 2000