LEGEND OF SYMBOLS, LINETYPES, AND ABBREVIATIONS

(E)	STORM MANHOLE
CB	CATCH BASIN
○	IRON PIN FOUND OR AS NOTED
●	IRON PIN SET
—o—o—o—o—	WOODEN FENCE
——— · ———	PROPERTY LINE
——— ———	RIGHT-OF-WAY
——— · ———	CENTERLINE
- - - - - -	EDGE OF PAVEMENT
R, M, U	RECORD, MEASURED, USED

NORTH

GRAPHIC SCALE
0 80
40 160
(IN FEET)

NOTE:

"BEARINGS SHOWN HERE ON ARE TO AN ASSUMED MERIDIAN AND ARE USED TO DENOTE ANGLES ONLY"

LOCATION MAP NTS

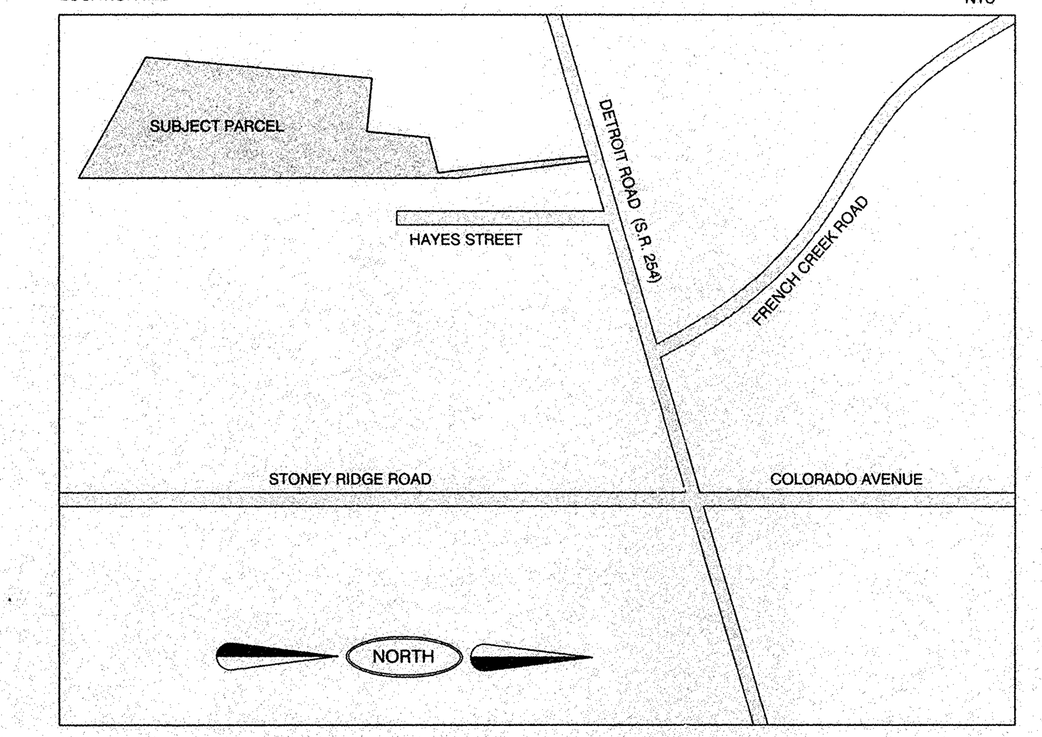

04-00-011-102-118 #119

#00 272

APPROVED
LORAIN CO.
MAP DEPT
DATE 1-21-2000
PAGE 4-00-011-B
BY T. SPILLMAN
#00272

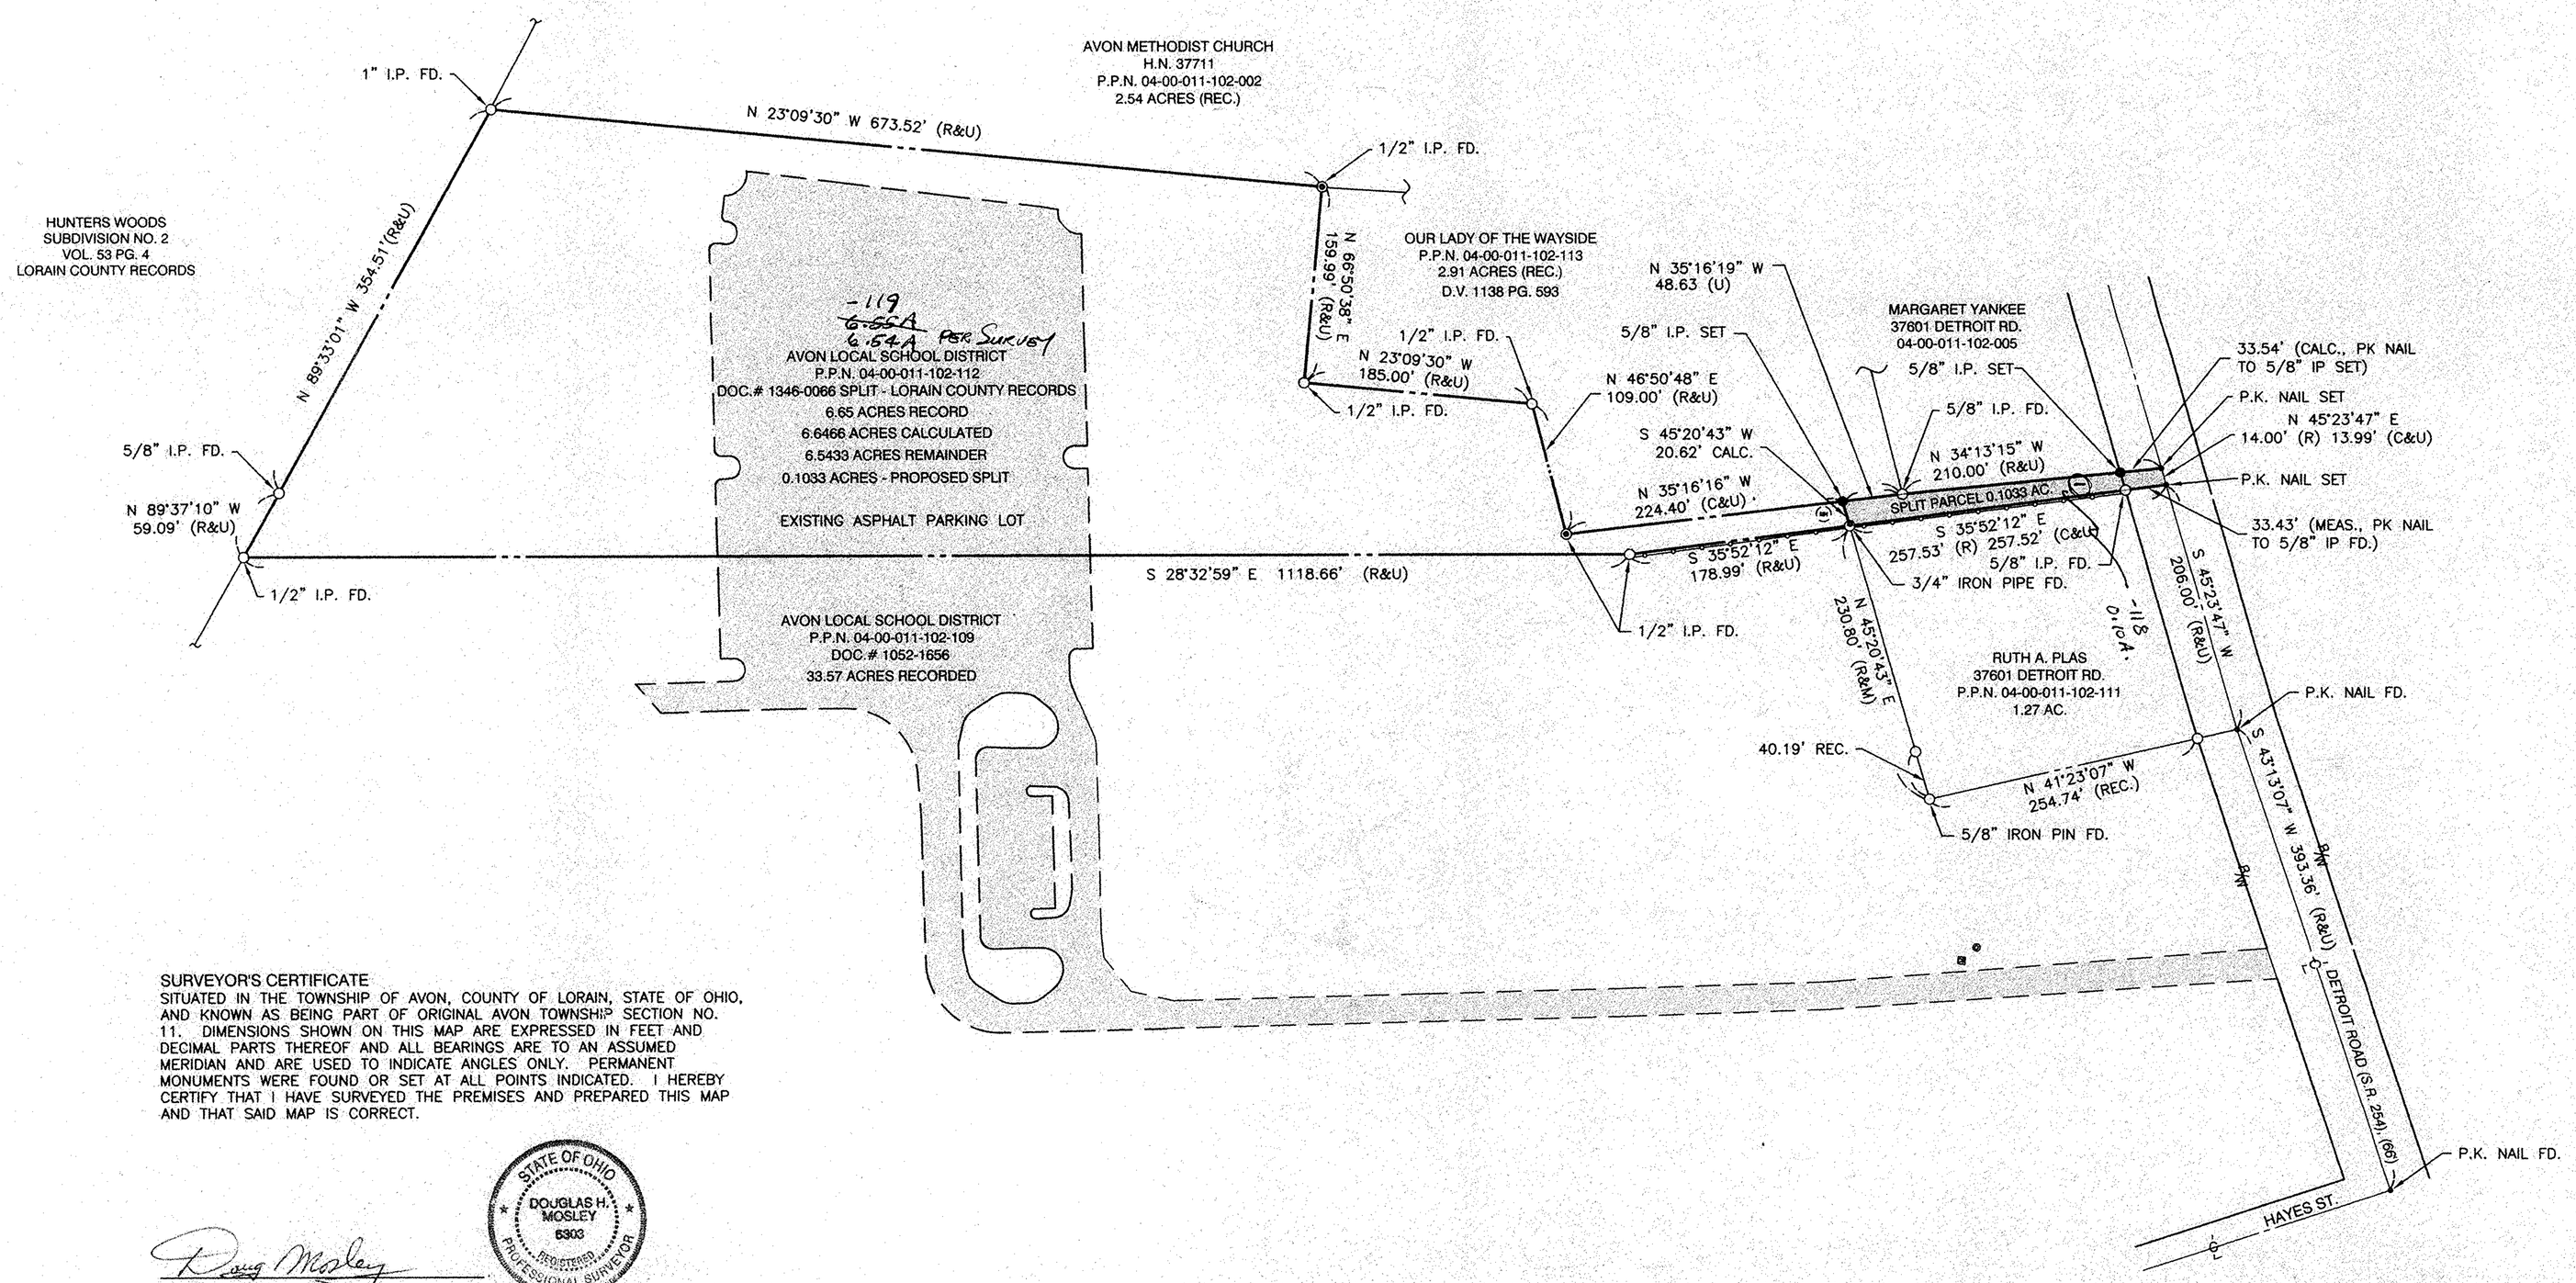

SURVEYOR'S CERTIFICATE

SITUATED IN THE TOWNSHIP OF AVON, COUNTY OF LORAIN, STATE OF OHIO, AND KNOWN AS BEING PART OF ORIGINAL AVON TOWNSHIP SECTION NO. 11. DIMENSIONS SHOWN ON THIS MAP ARE EXPRESSED IN FEET AND DECIMAL PARTS THEREOF AND ALL BEARINGS ARE TO AN ASSUMED MERIDIAN AND ARE USED TO INDICATE ANGLES ONLY. PERMANENT MONUMENTS WERE FOUND OR SET AT ALL POINTS INDICATED. I HEREBY CERTIFY THAT I HAVE SURVEYED THE PREMISES AND PREPARED THIS MAP AND THAT SAID MAP IS CORRECT.

STATE OF OHIO
DOUGLAS H. MOSLEY
6303
REGISTERED
PROFESSIONAL SURVEYOR

Doug Mosley

DOUG MOSLEY
REGISTERED SURVEYOR NO. 6303

BRAMHALL
ENGINEERING AND SURVEYING CO., INC.
37307 HARVEST DRIVE AVON, OHIO 44011
(440) 934 - 7878 (440) 934 - 7879 FAX

PARCEL SPLIT
FOR 04-00-011-102-112 PREPARED FOR
AVON LOCAL SCHOOL DISTRICT
SITUATED IN THE CITY OF AVON,
COUNTY OF LORAIN, STATE OF OHIO
A PART OF ORIG. AVON TWP. SECTION NO. 11

N

SCALE
1" = 80'

DATE
11/98 ORIGINAL

REV.
12/15/99
11/25/98

SHEET
1 / 1

JOB NO.
98-453
REVISED 12/99