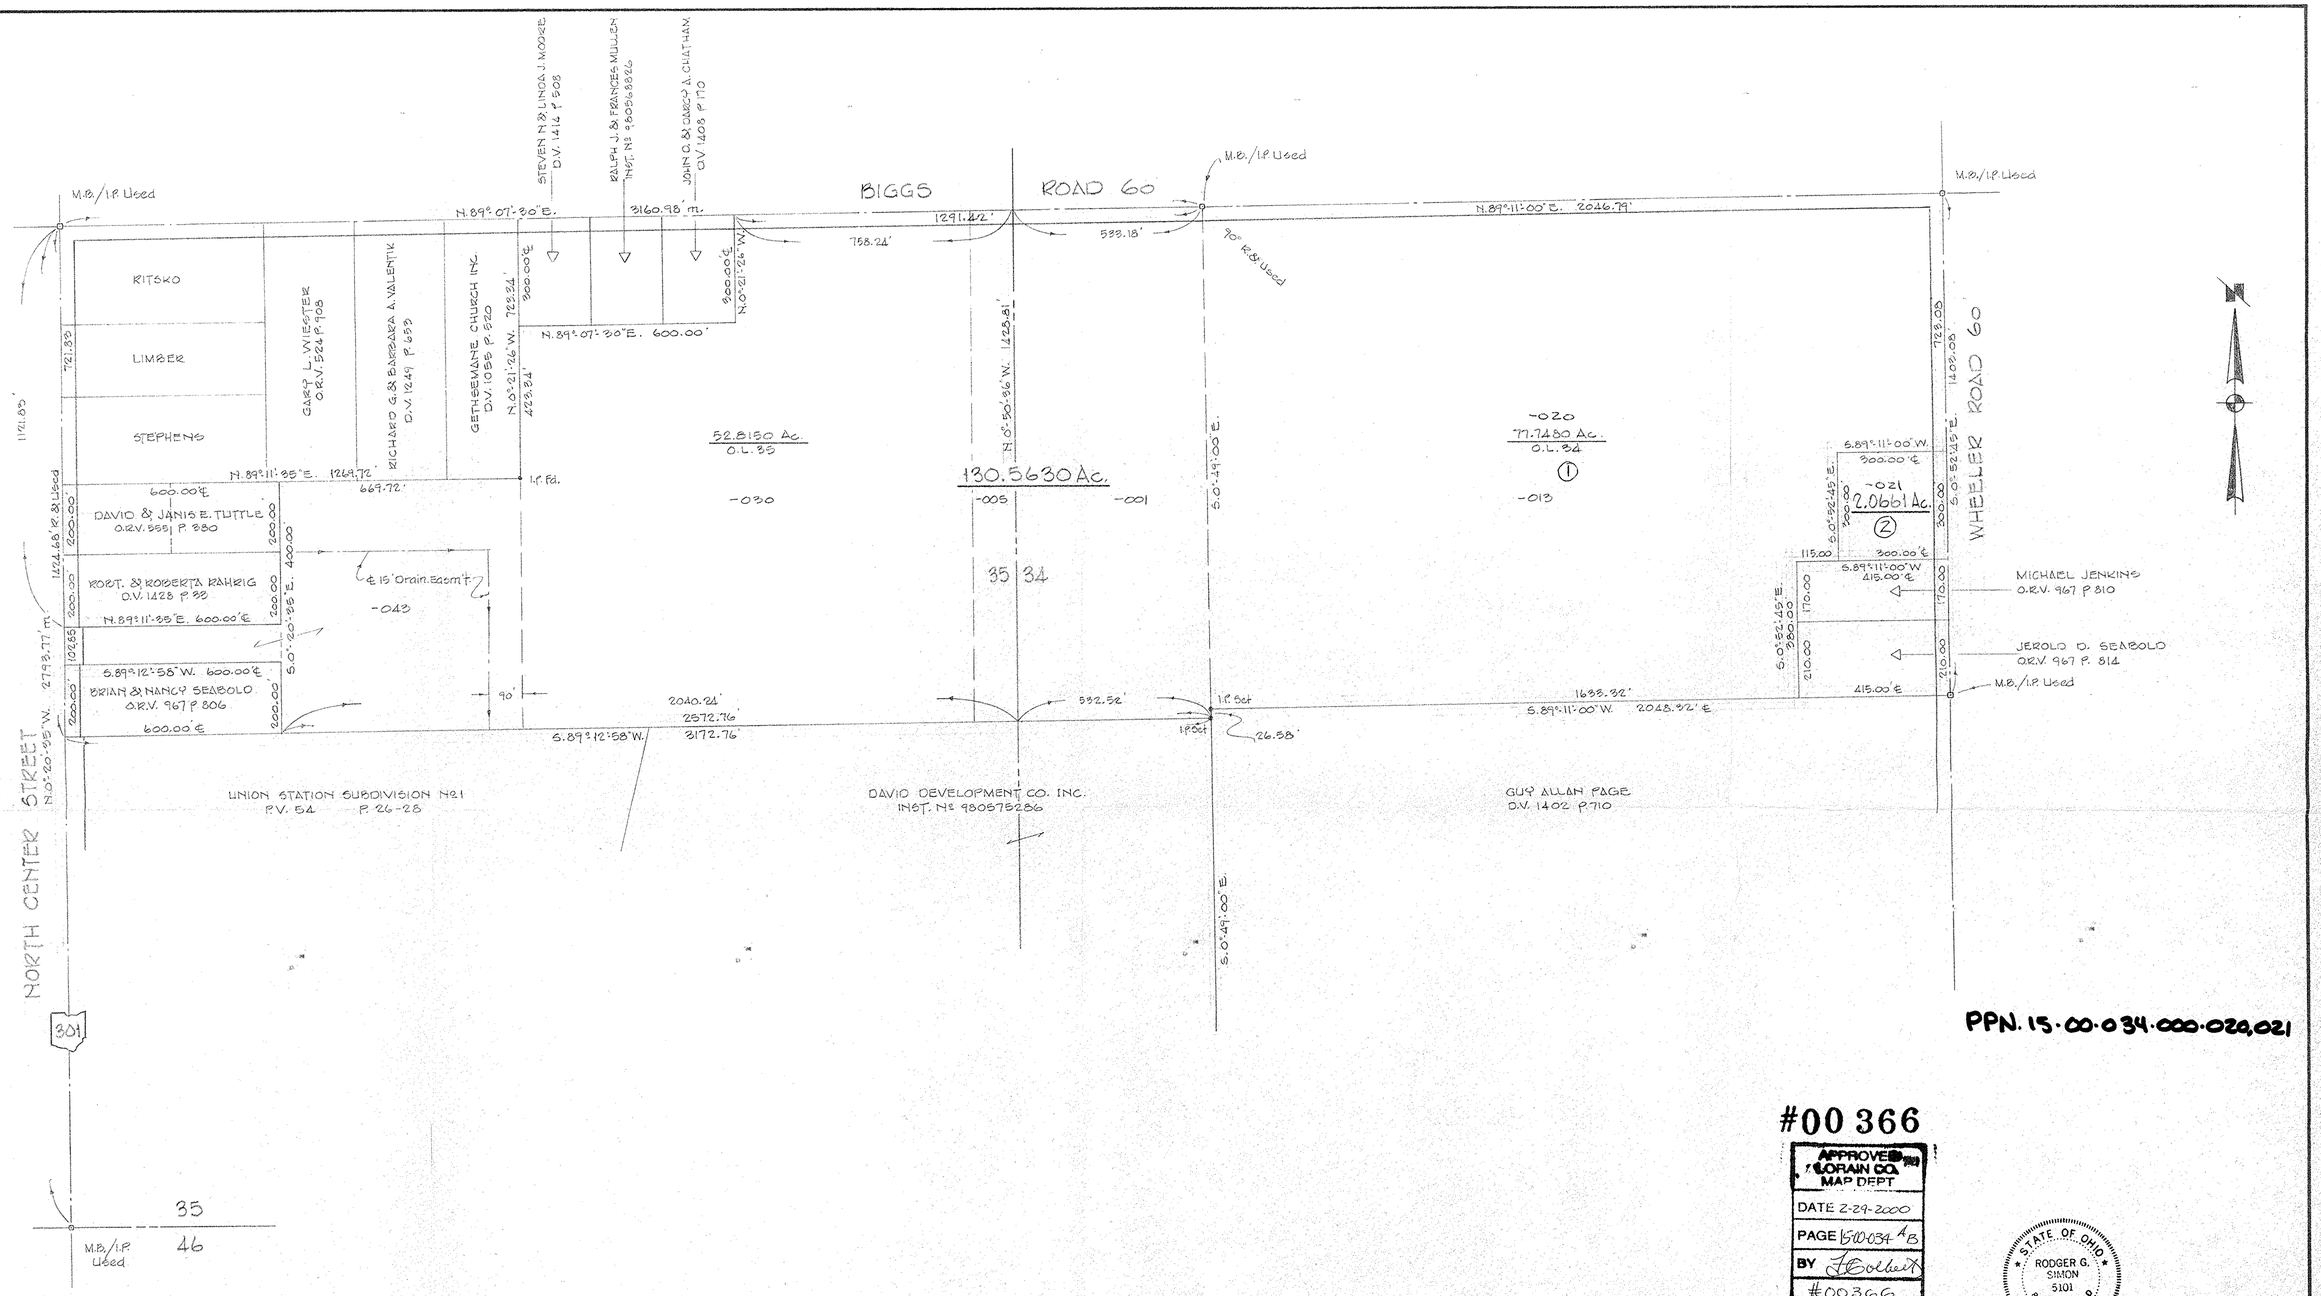

PPN. 15-00-034-000-020,021

#00 366

APPROVED LORAIN CO. MAP DEPT
DATE 2-29-2000
PAGE 510-034 A/B
BY L. Colbert
#00366

STATE OF OHIO
RODGER G. SIMON
5101
REGISTERED SURVEYOR

SURVEY FOR

THE SEABOLO BROTHERS, AN OHIO PARTNERSHIP

PART OF O.L.'S 34 & 35 TOWNSHIP OF LAGRANGE
VILLAGE OF LAGRANGE - COUNTY OF LORAIN - STATE OF OHIO
OCTOBER, 1999 SCALE 1" = 200'
LAUNDON • SIMON • CAHL & ASSOC.
PROFESSIONAL LAND SURVEYORS

99-3191