

RECEIVED

05 AUG 31 AM 9:44

LORAIN COUNTY AUDITOR

Point	Northing	Easting	Description
1	500.00000	500.00000	IRON PIN FOUND
2	570.00000	500.00000	
3	570.00000	410.00000	
4	500.00000	410.00000	
5	389.15000	500.00000	
6	374.57000	410.00000	
7	369.40740	503.19830	
8	500.00000	520.00000	
9	372.12930	520.00000	
10	885.00000	500.00000	IRON PIN FOUND
11	578.36040	532.67270	nail
12	570.01080	410.15380	IRON PIN FOUND
13	690.30970	499.98170	IRON PIN FOUND
14	780.71710	519.96500	p.k. found
15	569.99750	499.98950	REBAR SET
16	500.00090	410.16860	IRON PIN FOUND



Being known as sublots 1018 and 1019 of the Vermilion on the Lake Subdivision in the City of Vermilion, County of Lorain, in the State of Ohio.

Note: Only copies signed with Red Ink shall be considered Valid.

*Patrick A. McGannon*  
Patrick A. McGannon P.S. 7154

Prepared for Creolla Mustard of 389 Cumming Road Vermilion, Ohio, 44089.

Note: Bearings shown are to an assumed meridian and are used to describe angles only.

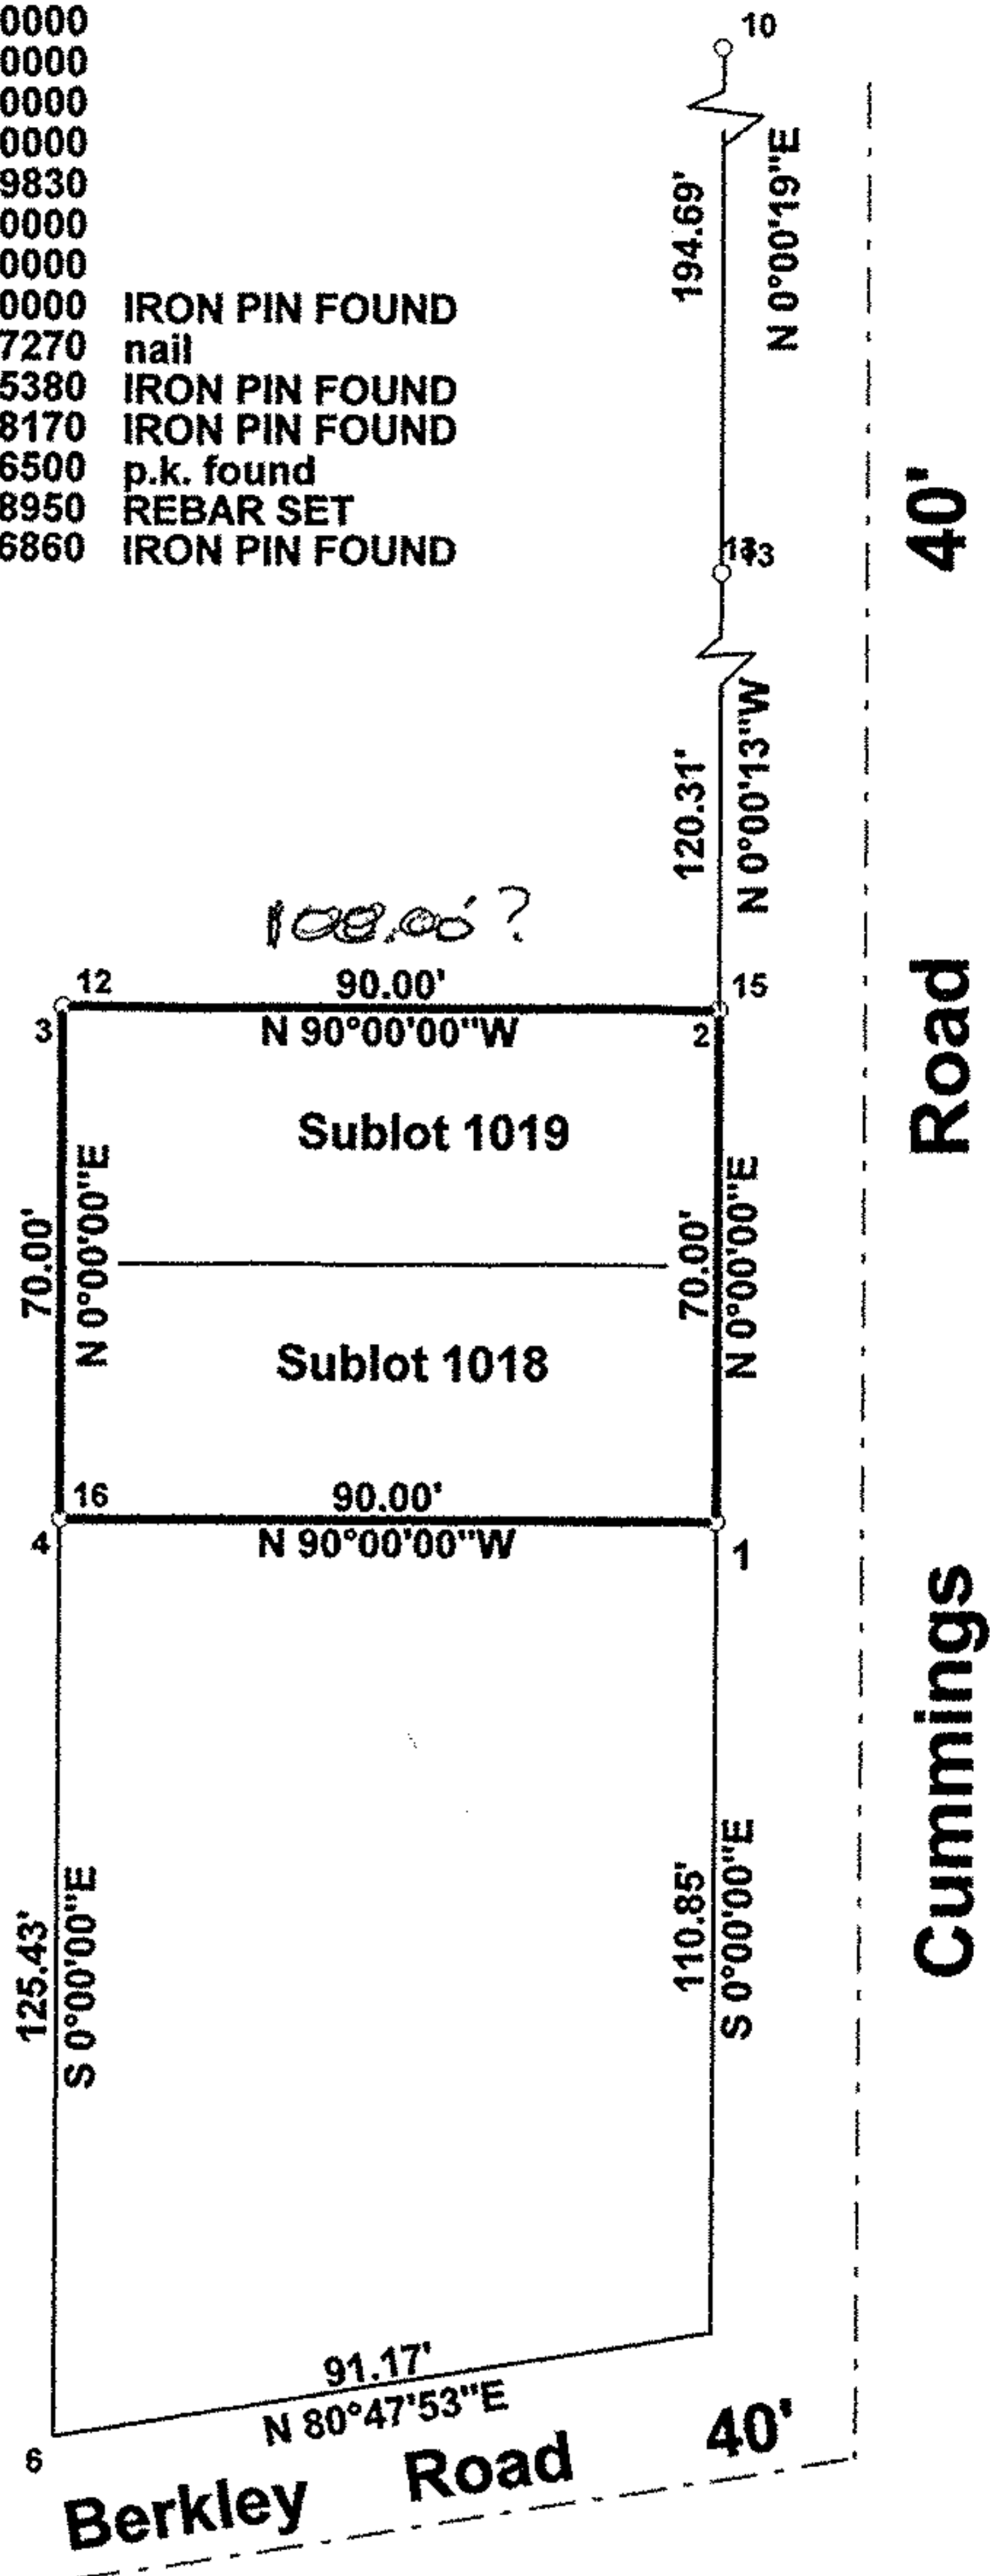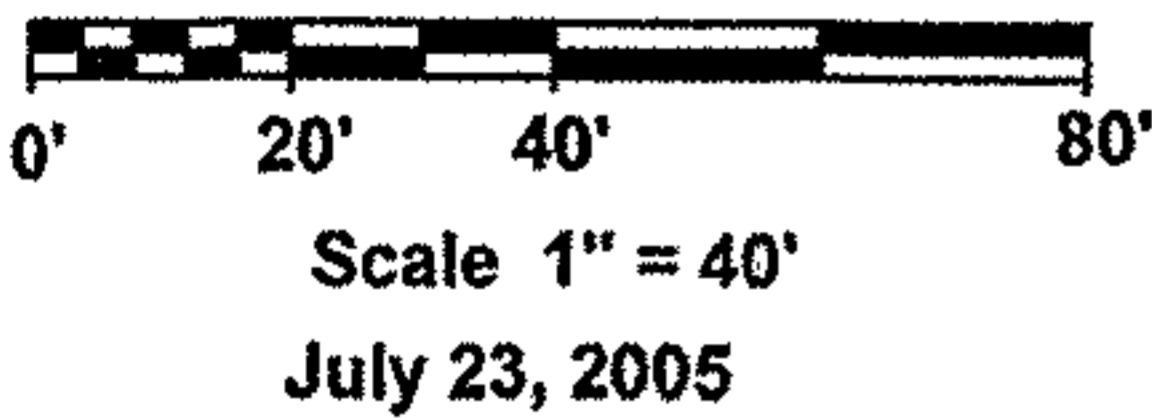

# Boundary Survey

## Patrick A. McGannon Registered Professional Surveyor

1731 Gettysburg Drive, Lorain, Ohio 44053

(440)-2822712



01-00-002-111-~~003~~,  
-003,  
F.R. Fig. 1-00-002-~~002~~.  
B