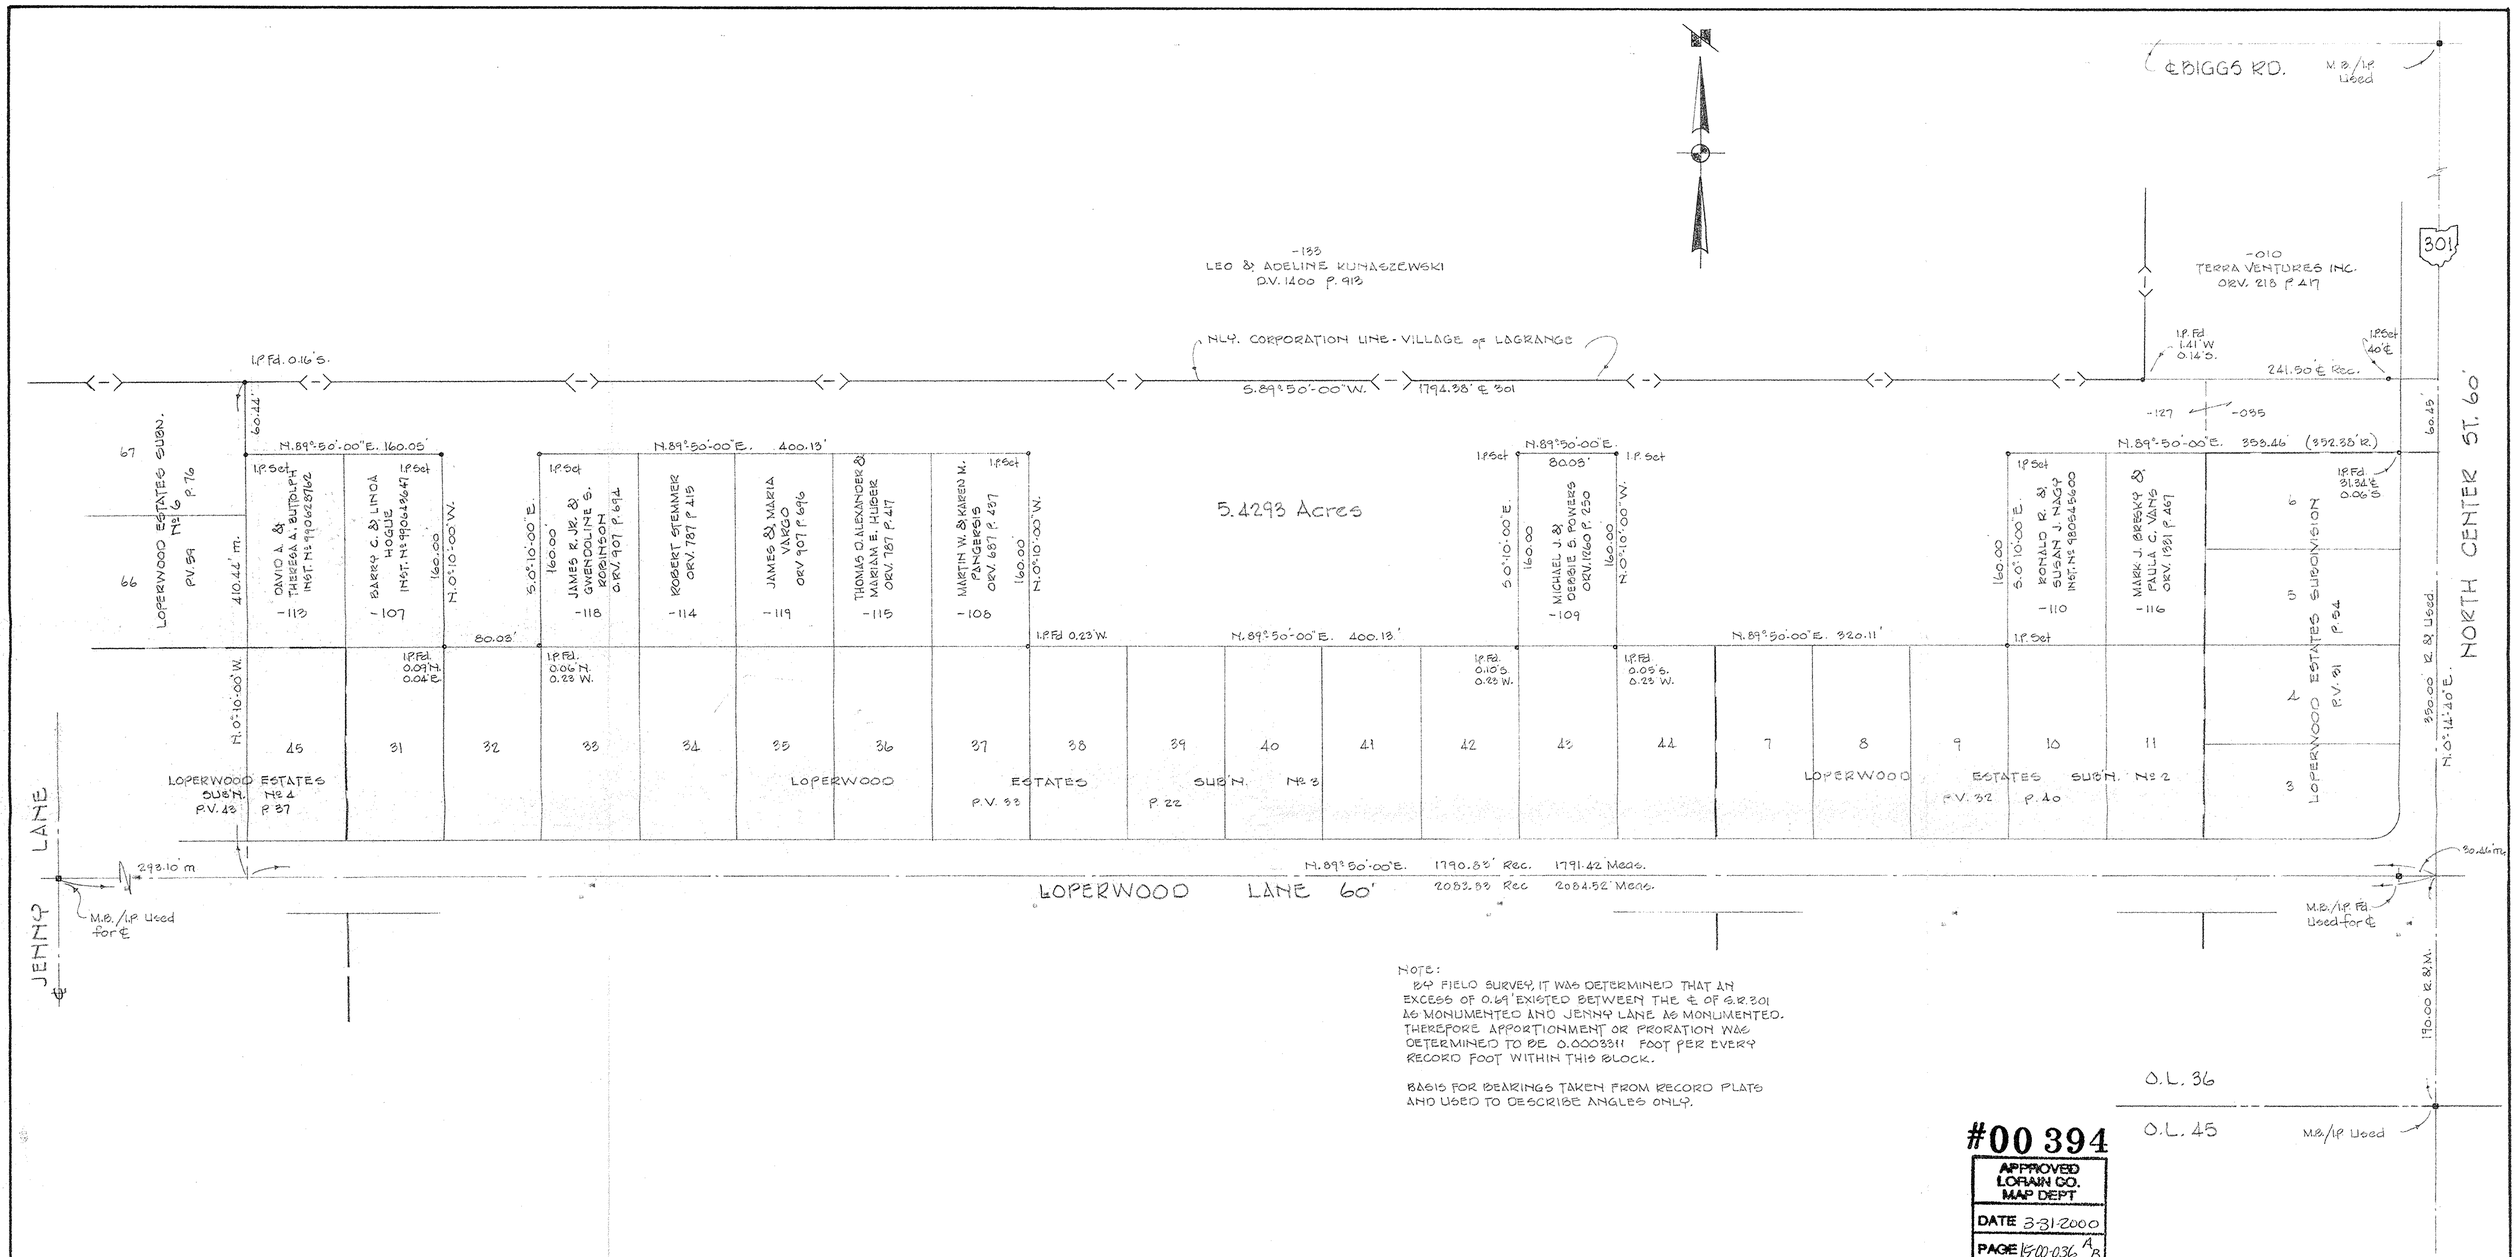

NOTE:
BY FIELD SURVEY, IT WAS DETERMINED THAT AN EXCESS OF 0.69' EXISTED BETWEEN THE ℄ OF S.R. 301 AS MONUMENTED AND JENNY LANE AS MONUMENTED. THEREFORE APPORTIONMENT OR PRORATION WAS DETERMINED TO BE 0.0003311 FOOT PER EVERY RECORD FOOT WITHIN THIS BLOCK.

BASIS FOR BEARINGS TAKEN FROM RECORD PLATS AND USED TO DESCRIBE ANGLES ONLY.

#00394

APPROVED LORAIN CO. MAP DEPT
DATE 3-31-2000
PAGE 15-00-036 A B
BY [illegible]
#00394

SURVEY FOR

ROBERT S. LOPER

PART of O.L. 36 TOWNSHIP of LAGRANGE
VILLAGE of LAGRANGE • COUNTY of LORAIN • STATE of OHIO
SCALE 1" = 60' JANUARY, 2000
BY
LAUNDON • SIMON • CAHL & ASSOC.
PROFESSIONAL LAND SURVEYORS
JOB № 99-3202 F.B. 247 P.21

REV. 1-28-2000 Added Corp. Line to Dwg. - RGS