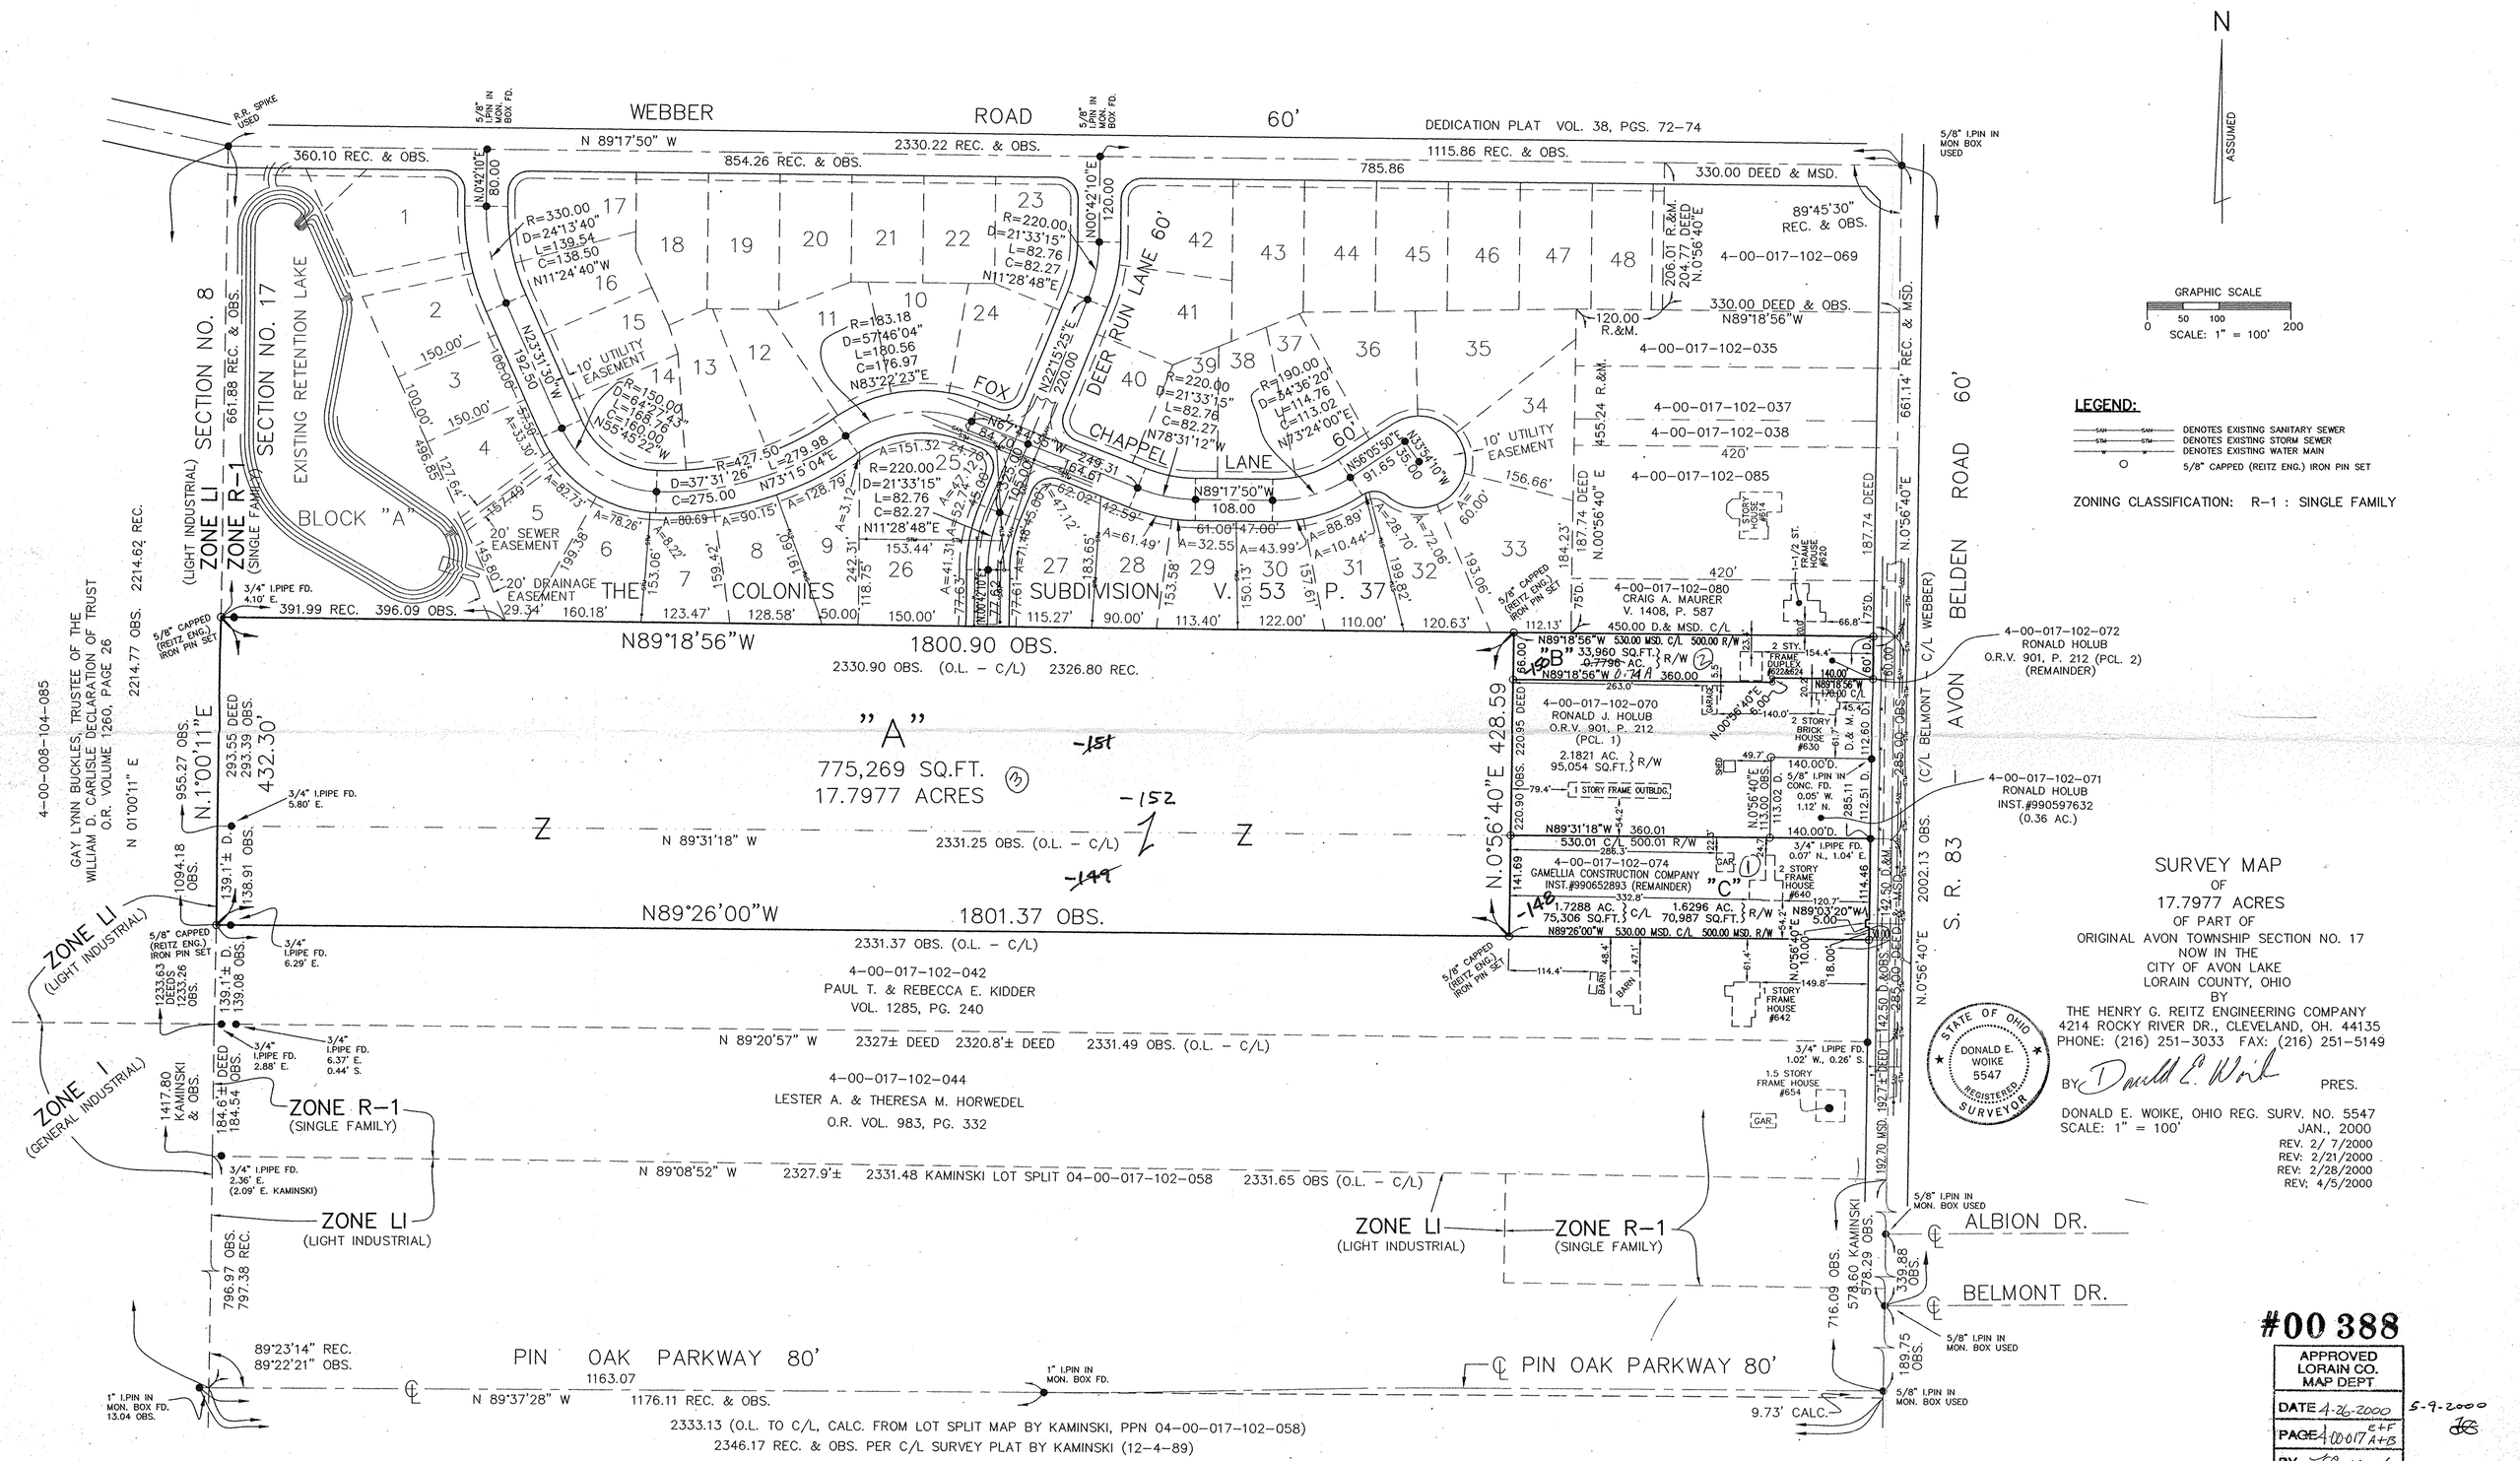

SURVEY MAP
OF
17.7977 ACRES
OF PART OF
ORIGINAL AVON TOWNSHIP SECTION NO. 17
NOW IN THE
CITY OF AVON LAKE
LORAIN COUNTY, OHIO
BY
THE HENRY G. REITZ ENGINEERING COMPANY
4214 ROCKY RIVER DR., CLEVELAND, OH. 44135
PHONE: (216) 251-3033 FAX: (216) 251-5149

BY Donald E. Woike PRES.

DONALD E. WOIKE, OHIO REG. SURV. NO. 5547
SCALE: 1" = 100'
JAN., 2000
REV. 2/ 7/2000
REV: 2/21/2000
REV: 2/28/2000
REV: 4/5/2000

#00 388

APPROVED
LORAIN CO.
MAP DEPT

DATE 4-26-2000 5-9-2000
PAGE 4-00017 A+B
BY
#00388