New M.A.P.

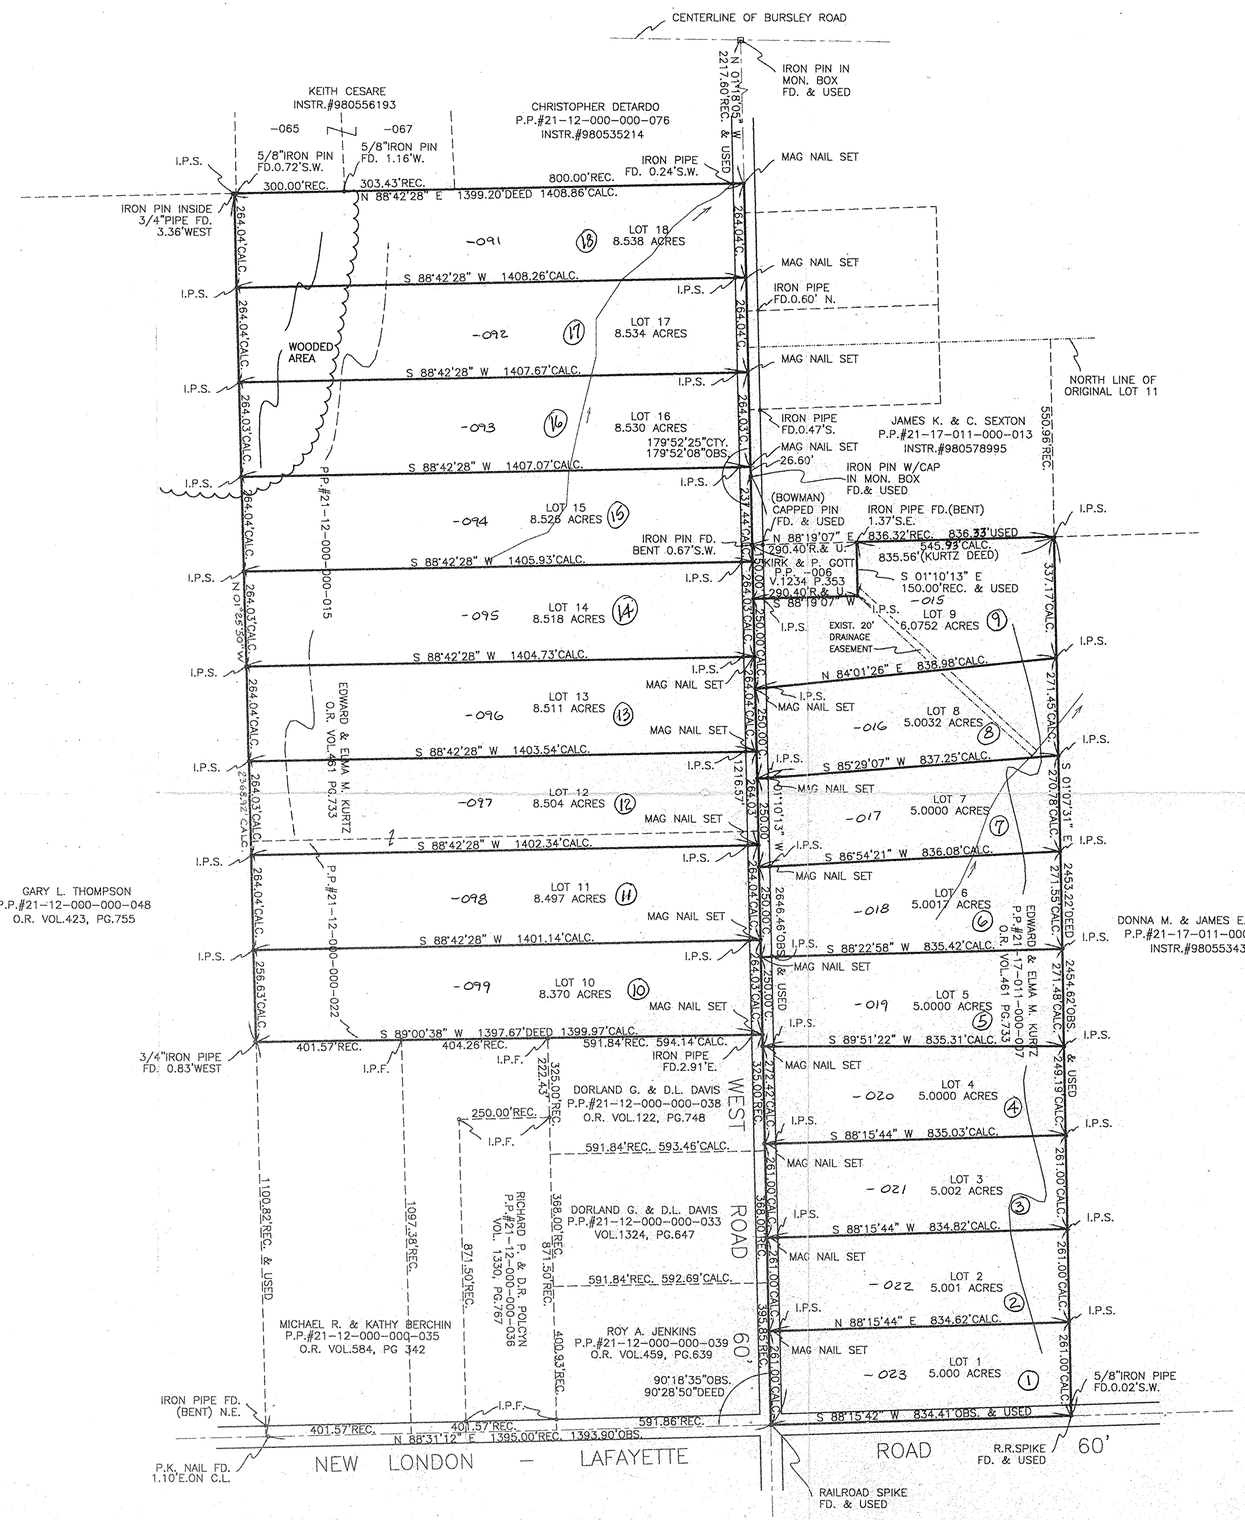

MAP OF SURVEY AND LOT SPLIT

PREPARED FOR

KINGLAND COMPANY

SITUATED IN THE TOWNSHIP OF HUNTINGTON, COUNTY OF LORAIN, STATE OF OHIO AND BEING KNOWN AS PART OF ORIGINAL HUNTINGTON TOWNSHIP TRACT 12 AND TRACT 17, LOT 11

200' 0' 200' 400'

SCALE: 1" = 200'

SURVEYOR'S STATEMENT

DISTANCES ARE EXPRESSED IN FEET AND DECIMAL PARTS THEREOF. BEARING ARE BASE ON LORAIN COUNTY ENGINEERS RECORD PLAT V.26 P.32. PERMANENT MONUMENTS WERE FOUND OR SET AS INDICATED HEREON. —o— I.P.S. INDICATES A 5/8" IRON PIN WITH CAP SET. —o— I.P.F. INDICATES A 5/8" IRON PIN WITH CAP FOUND UNLESS OTHERWISE INDICATED. ALL OF WHICH I DECLARE TO BE CORRECT TO THE BEST OF MY ABILITIES AND BELIEFS.

Thomas M. Snezek — 2-4-00

THOMAS M. SNEZEK, R.L.S. #7051 — DATE

STATE OF OHIO THOMAS M. SNEZEK S-7051 SURVEYOR

#00 387

APPROVED LORAIN CO. MAP DEPT

DATE 3-28-2000

PAGE 21-D 21-17-011-A

BY

00387

REVISED 3/9/00

Rev. 2/19/00

PROJECT NO. 9920F 2/4/00