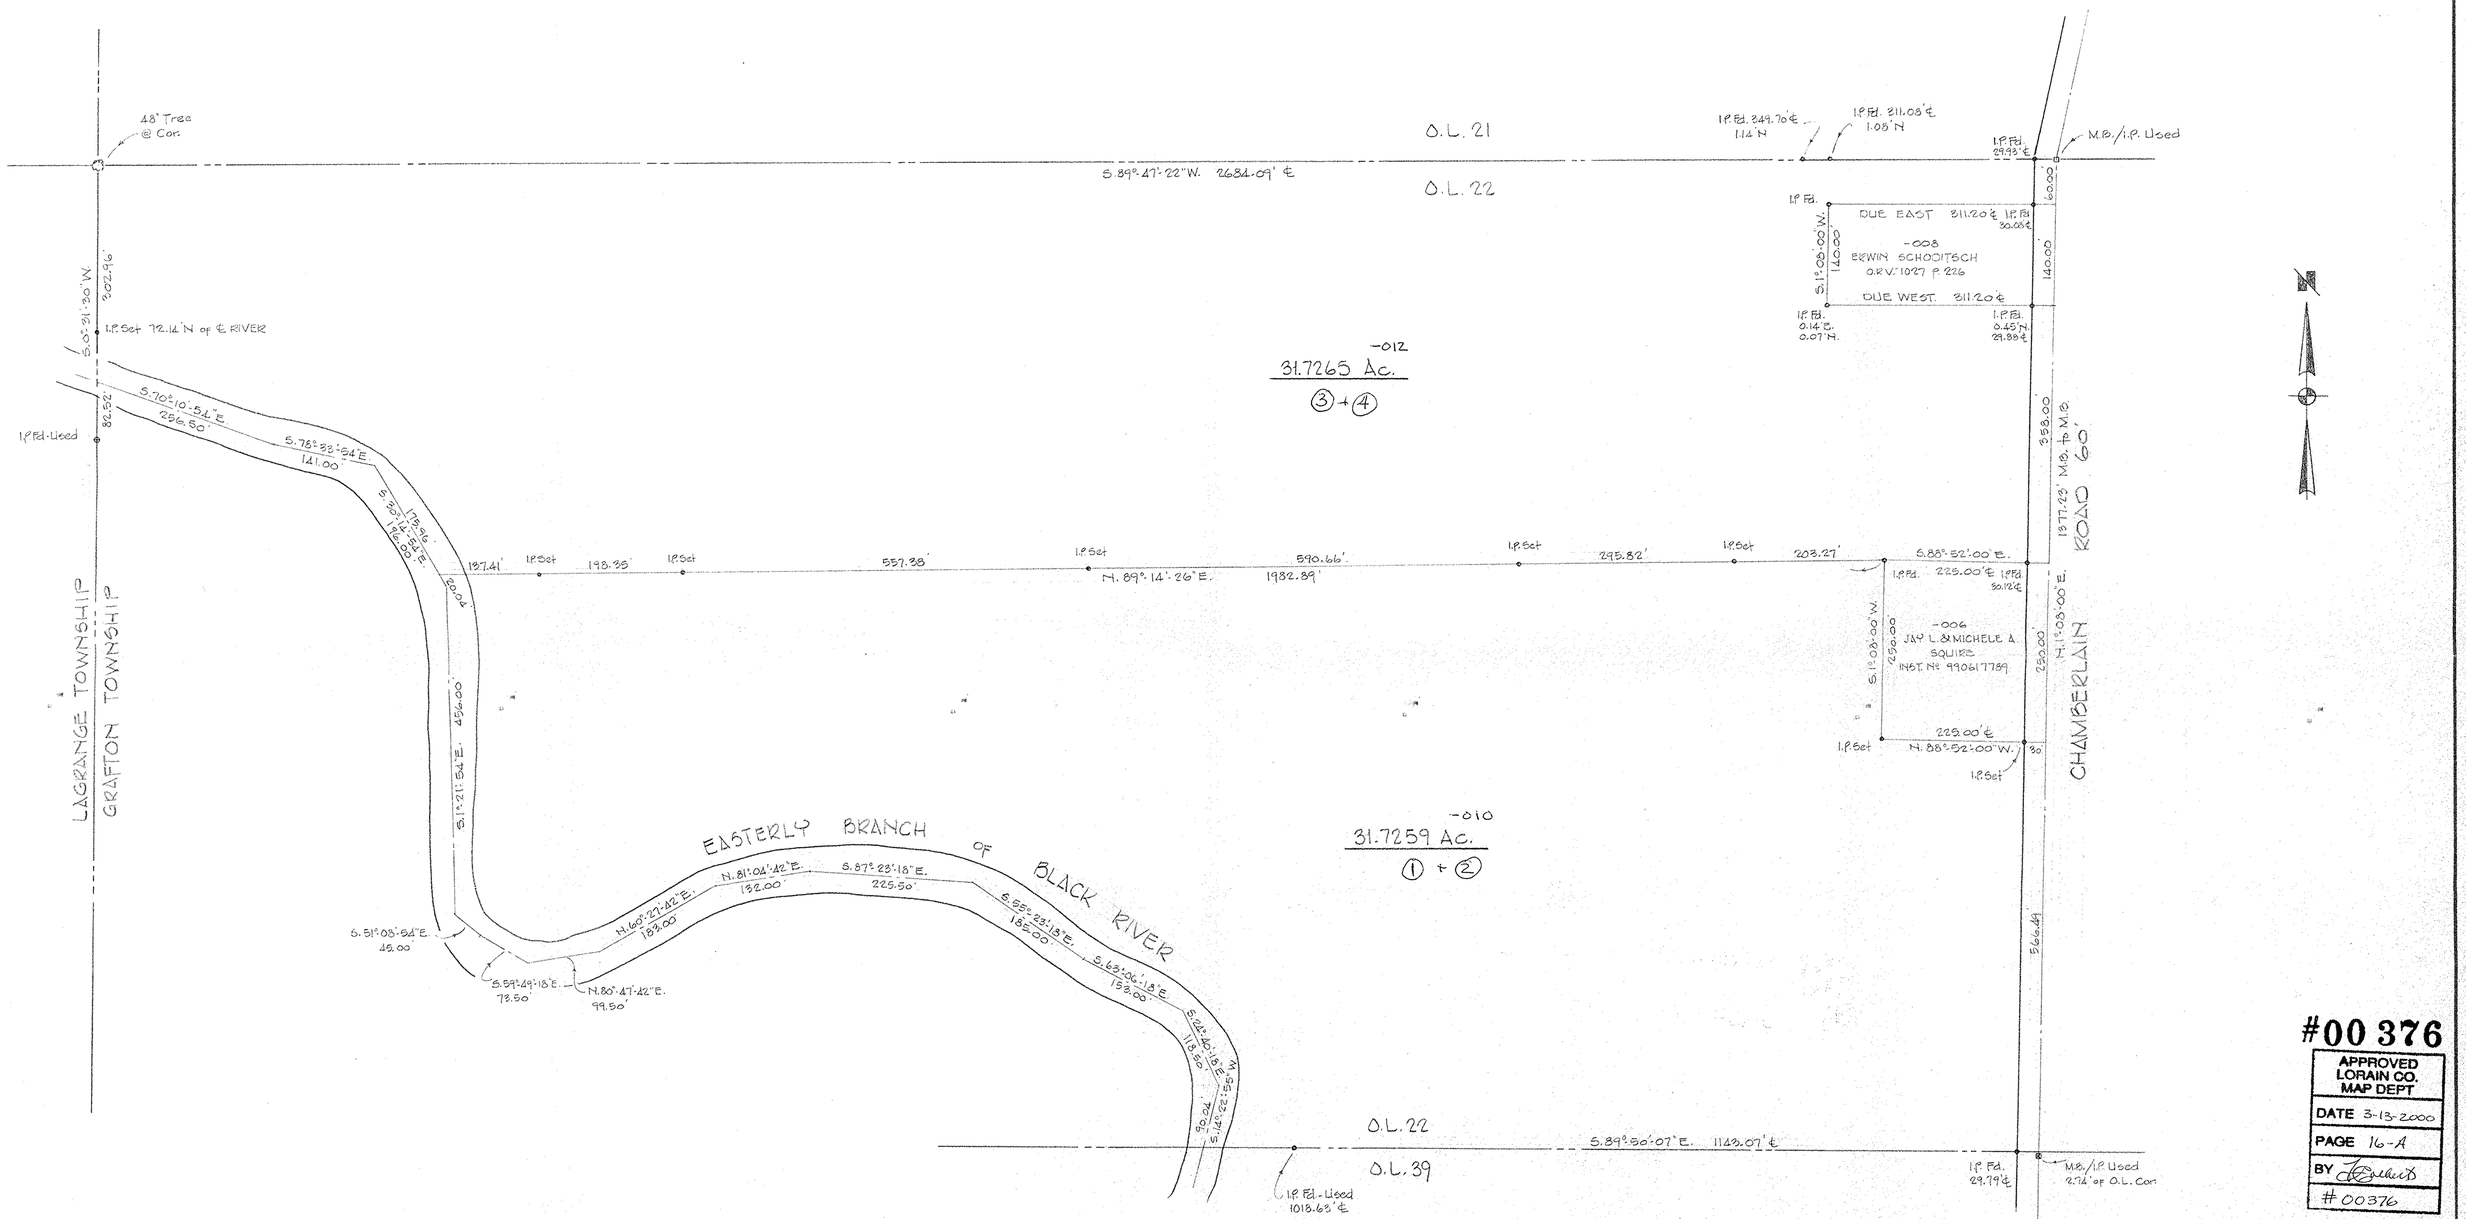

#00 376

APPROVED
LORAIN CO.
MAP DEPT
DATE 3-13-2000
PAGE 16-A
BY
#00376

STATE OF OHIO
RODGER G. SIMON
5101
REGISTERED SURVEYOR

SURVEY FOR THE
ESTATE of CHARLES A. MLAZOVSKY

PART of O.L. 22 TOWNSHIP of GRAFTON
COUNTY of LORAIN STATE of OHIO
OCTOBER 1999 SCALE 1"=100'
BY
LAUNDON • SIMON • CAHL & ASSOC.
PROFESSIONAL LAND SURVEYORS
JOB Nº 99-3185 FB. 245 P. 77-79