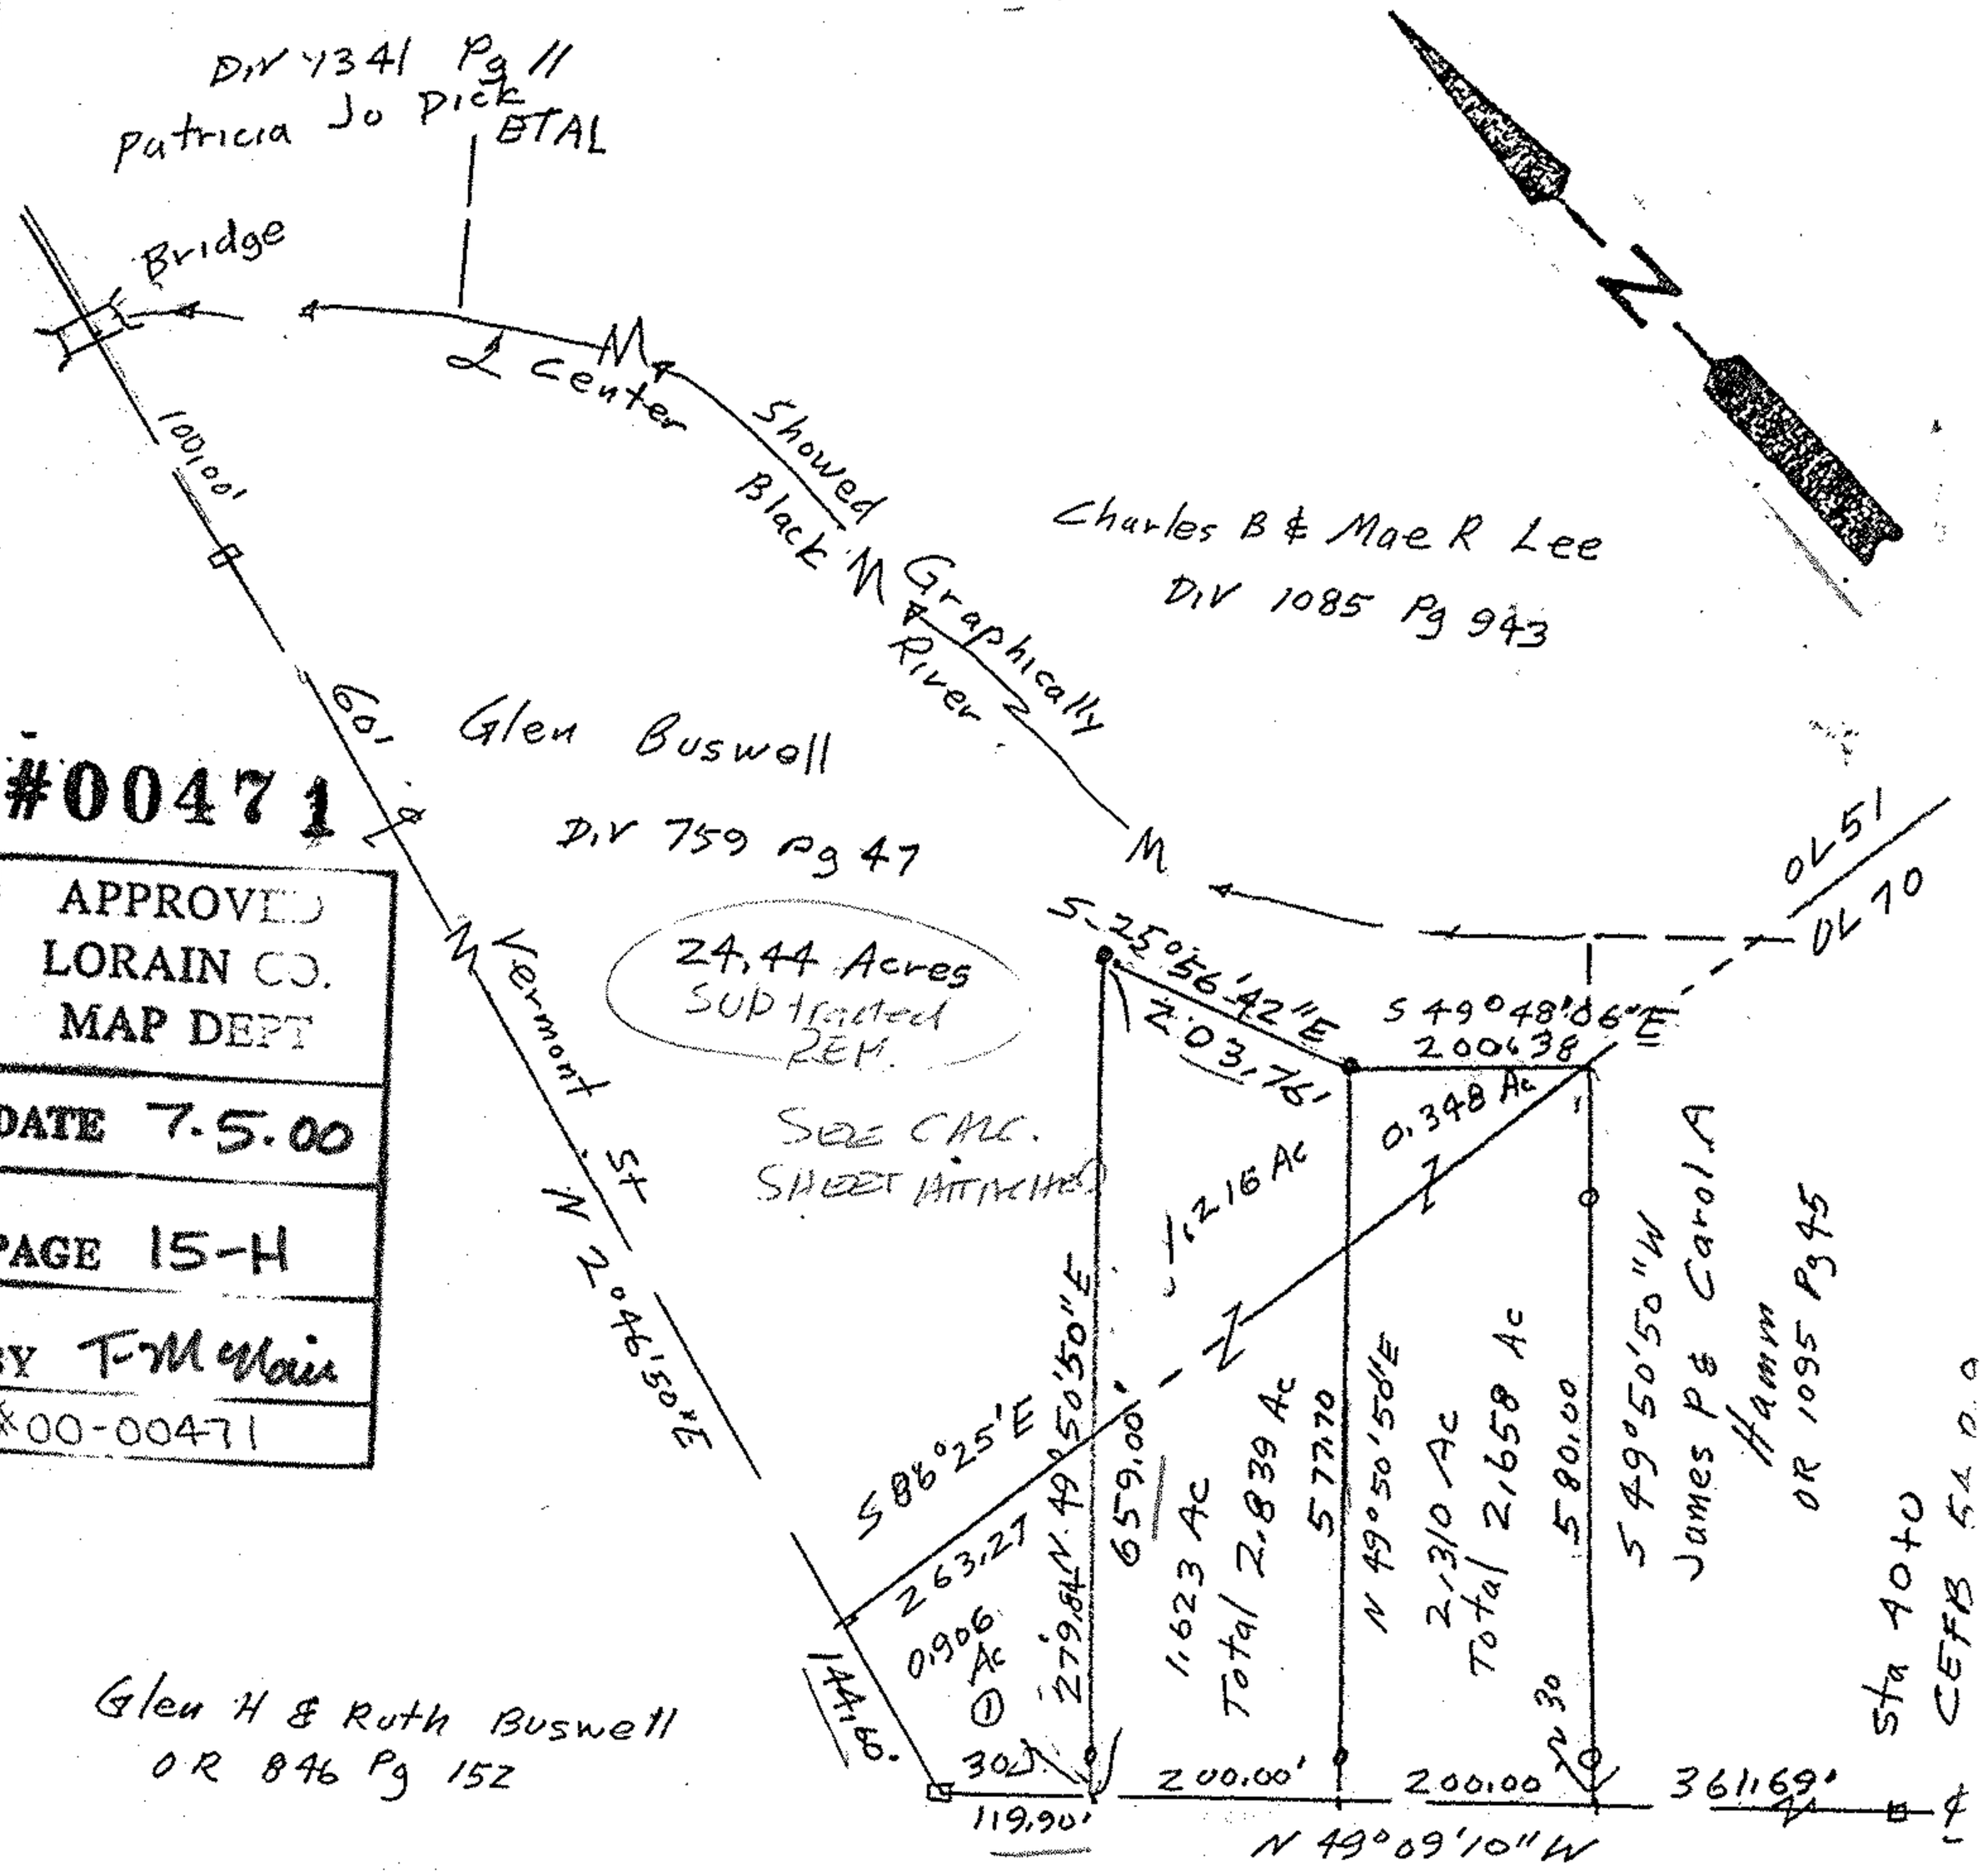

#00471

APPROVED LORAIN CO. MAP DEPT
DATE 7.5.00
PAGE 15-H
BY T-McClain
#00-00471

o iron pins fd
o iron pins set
□ monument boxes

STATE OF OHIO
JOHN POZYWAK
5292
REGISTERED
SURVEYOR

Survey of Parcel Splits
Glen Buswell
Original Lot 70 OL 51 ?
LaGrange Township
Scale 1" = 200' Nov 1999
John Pozywak
Rev's June 2000