06-23-001-103-011,072

#00 456

APPROVED LORAIN CO. MAP DEPT.
DATE 6-8-00
PAGE 6-19
BY J Hatfield
00-456

DATE: DEC 1993
SCALE 1" = 40'

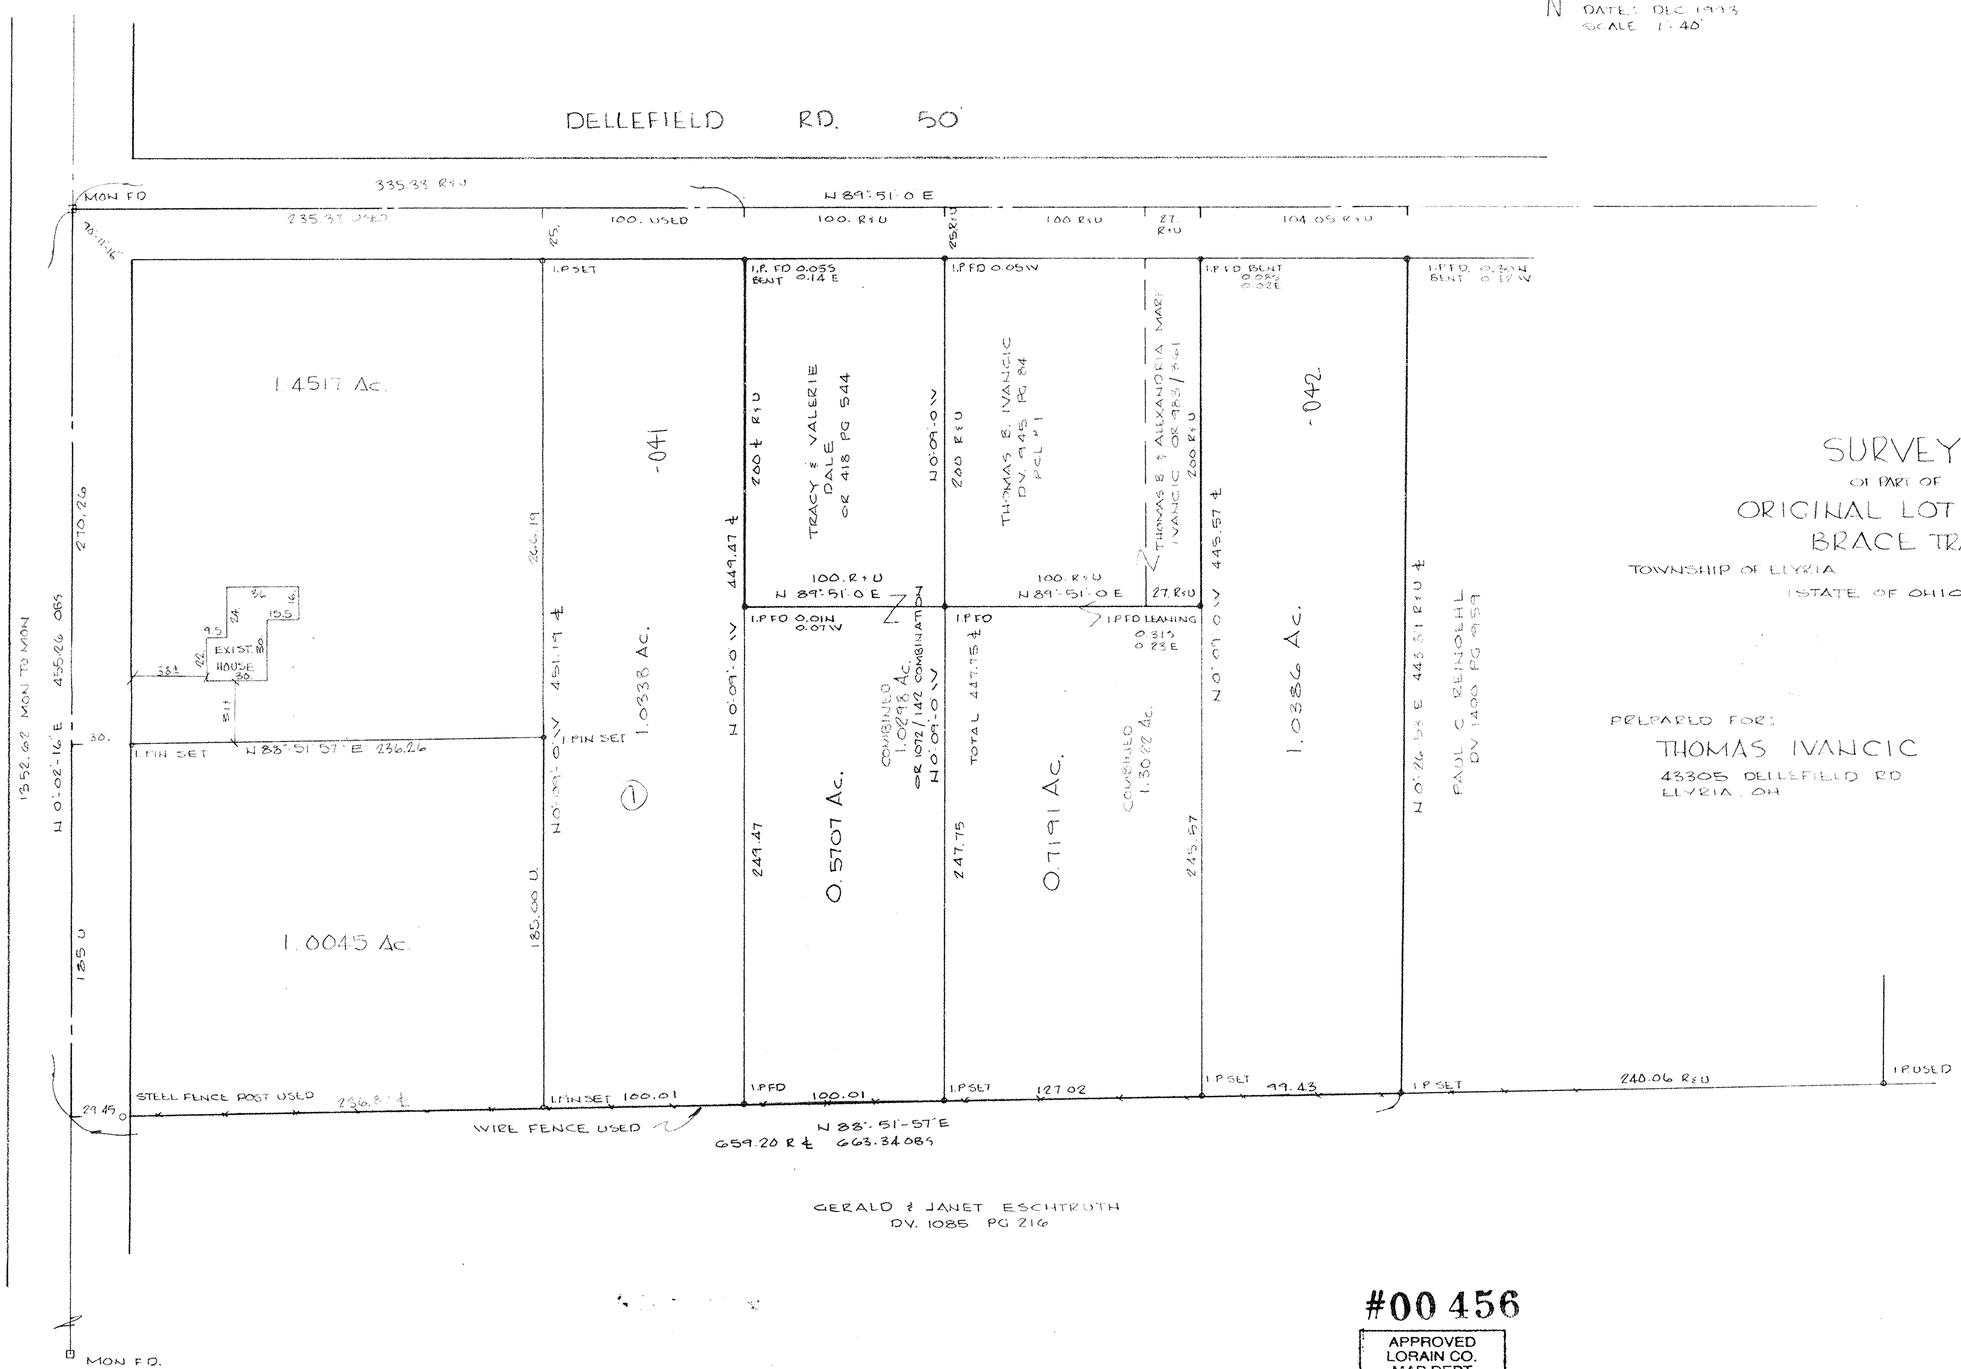

SURVEY
OF PART OF
ORIGINAL LOT Nº 1
BRACE TRACT
TOWNSHIP OF ELYRIA COUNTY OF LORAIN
STATE OF OHIO

PREPARED FOR:
THOMAS IVANCIC
43305 DELLEFIELD RD
ELYRIA, OH

PREPARED BY:
HAPONEK AND ASSOC INC.
ENGINEERS AND SURVEYORS
N. RIDGEVILLE, OH.

STATE OF OHIO
DANE A. HAPONEK
5621
REGISTERED SURVEYOR

#00 456

APPROVED LORAIN CO. MAP DEPT
DATE 6-8-00
PAGE 6-19
BY J. Hatfield
00-00456

REVISED SEPT 1999
93-46
REVISED FEB. 9, 1995