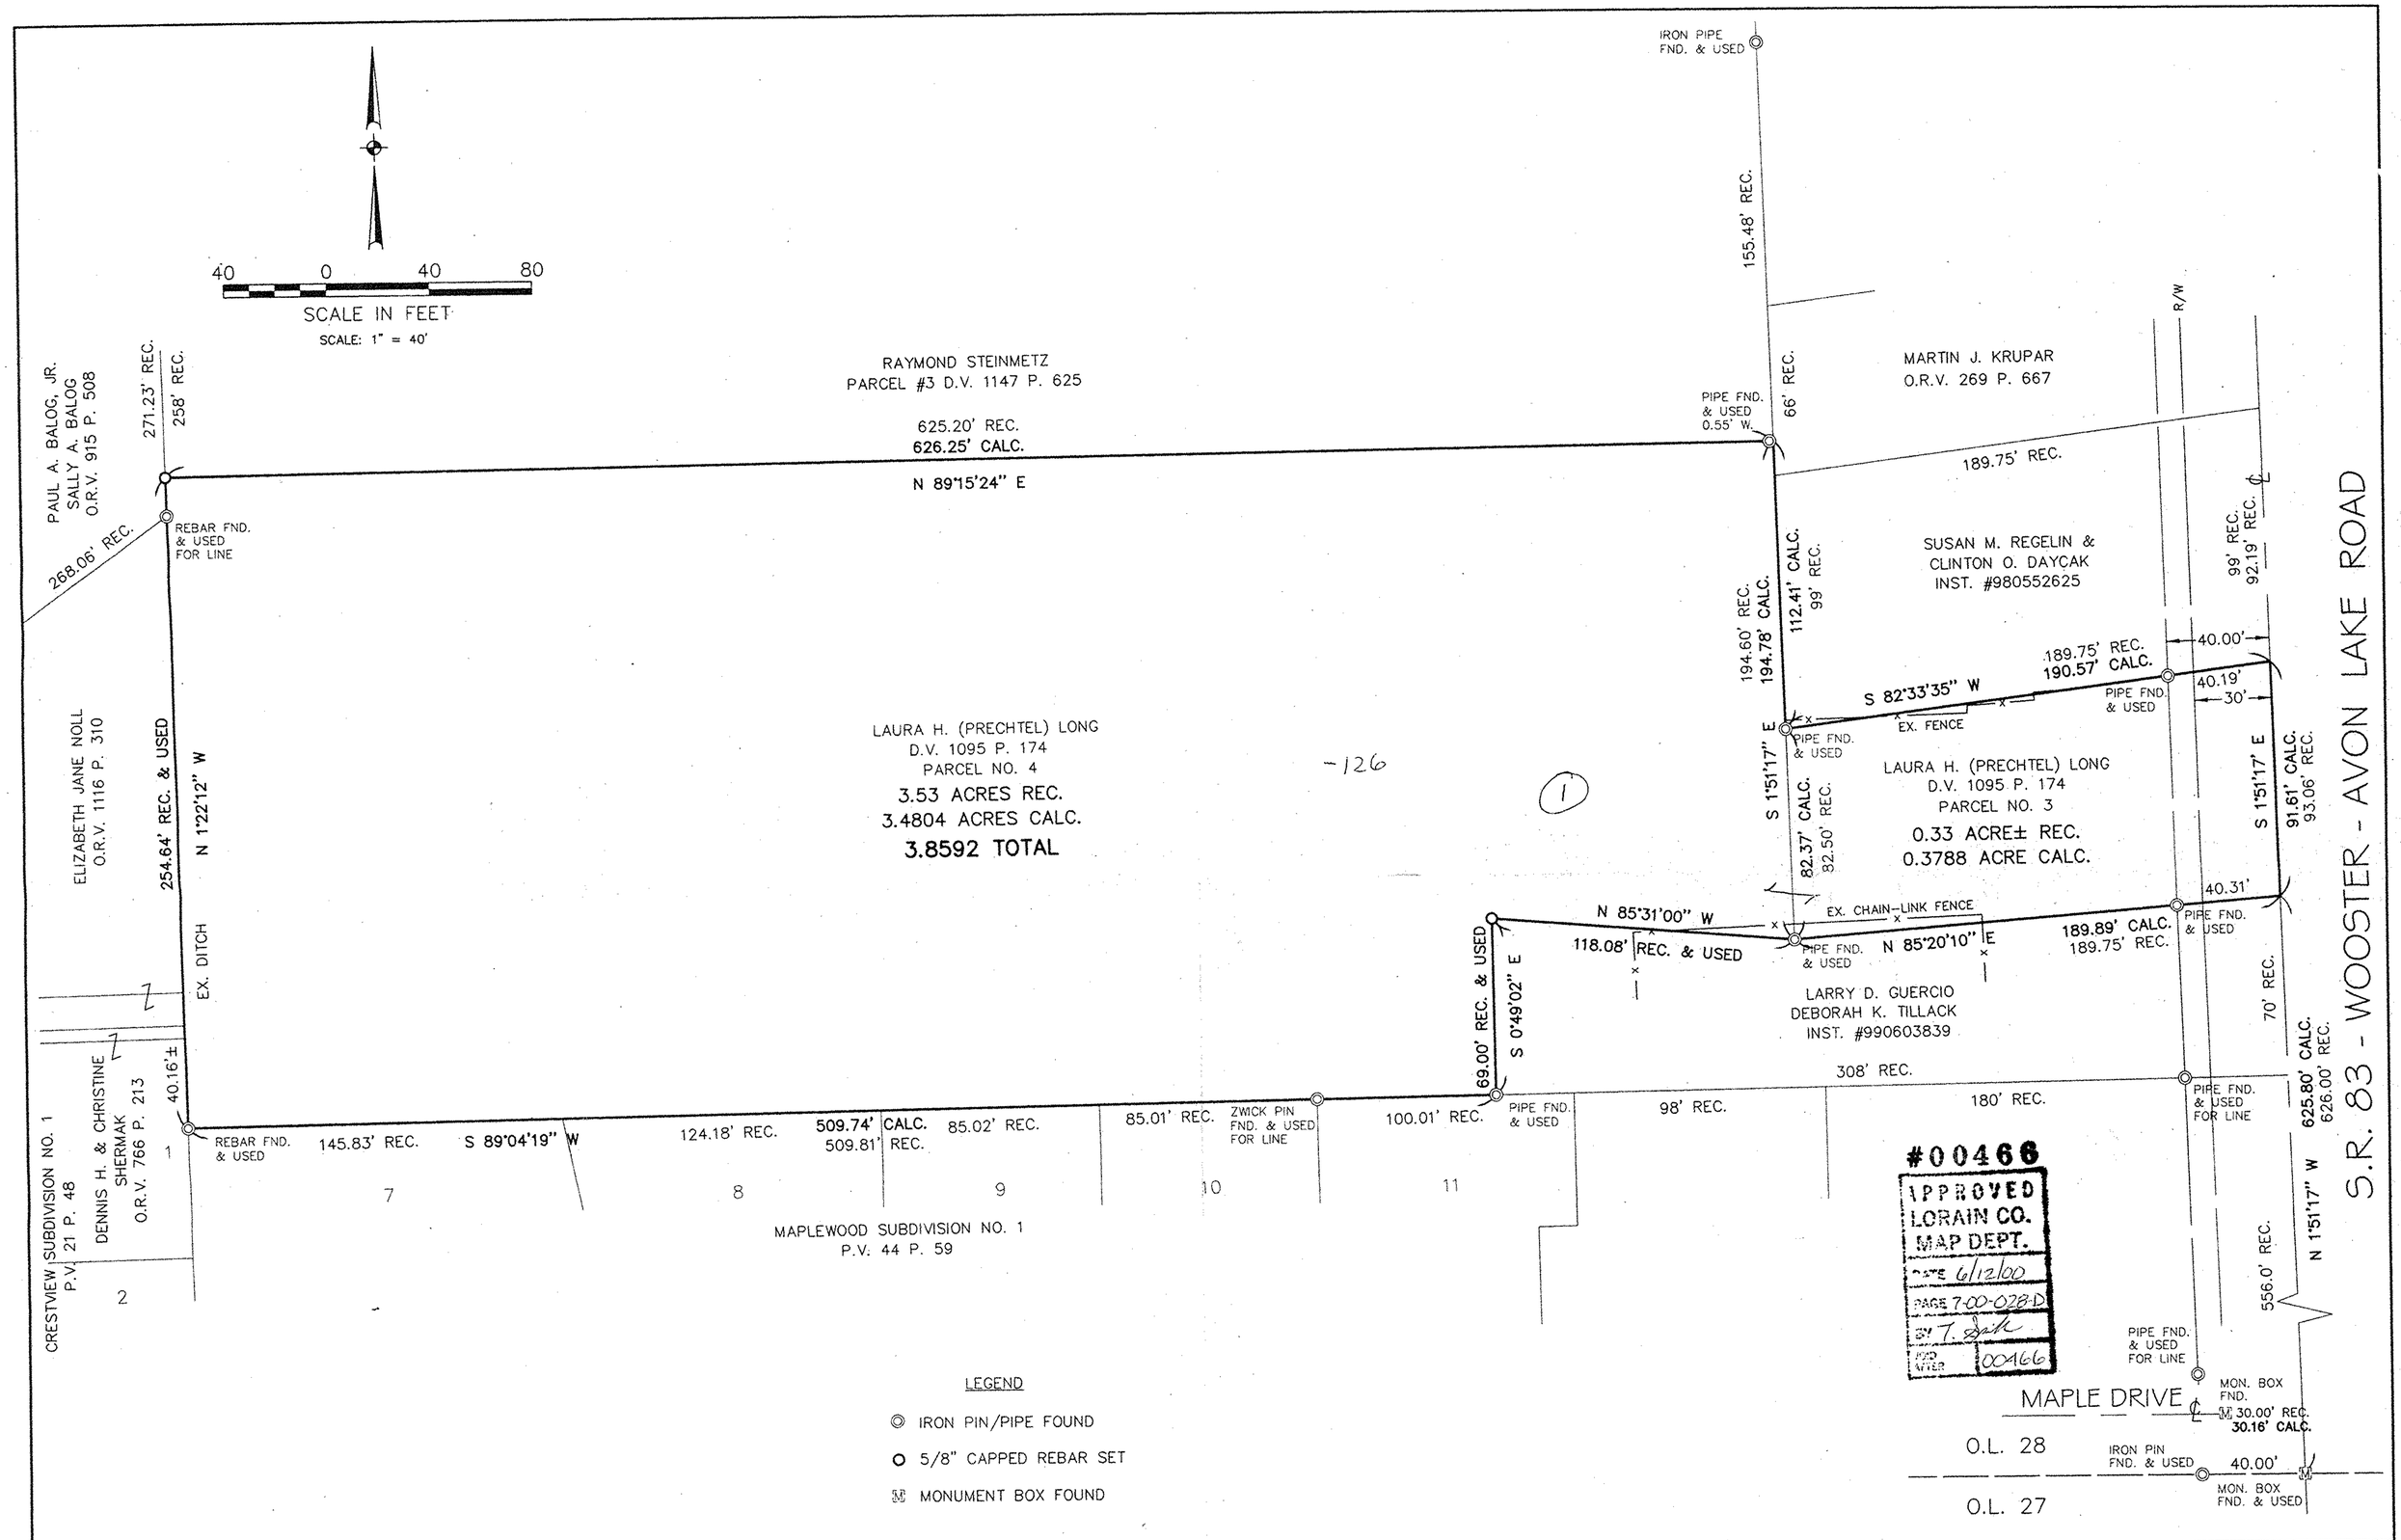

STATE OF OHIO
DAVID L ELWELL
6333
REGISTERED SURVEYOR

David L Elwell
DAVID L. ELWELL, REGISTERED SURVEYOR NO. 6333

KS ASSOCIATES
424 Middle Avenue
P.O. Box 569
Elyria, Ohio 44036
Phone (440) 322-6317
Fax (440) 284-0623
mailroom@ksassoc.com
www.ksassoc.com

SURVEY MAP

OF PART OF

ORIGINAL RIDGEVILLE TOWNSHIP LOT NO. 28
CITY OF NORTH RIDGEVILLE COUNTY OF LORAIN STATE OF OHIO

DATE: NOVEMBER 18, 1999

JOB NO. 99201

DWG. NAME O-SURVO1