Flores Property

Sheffield Township ~ Lorain County ~ State of Ohio
Part of Original Sheffield Township Lots 108 & 113

P.P.N. 03-00-108-112-040
Lorain County O.R. Vol. 1462 Page 712

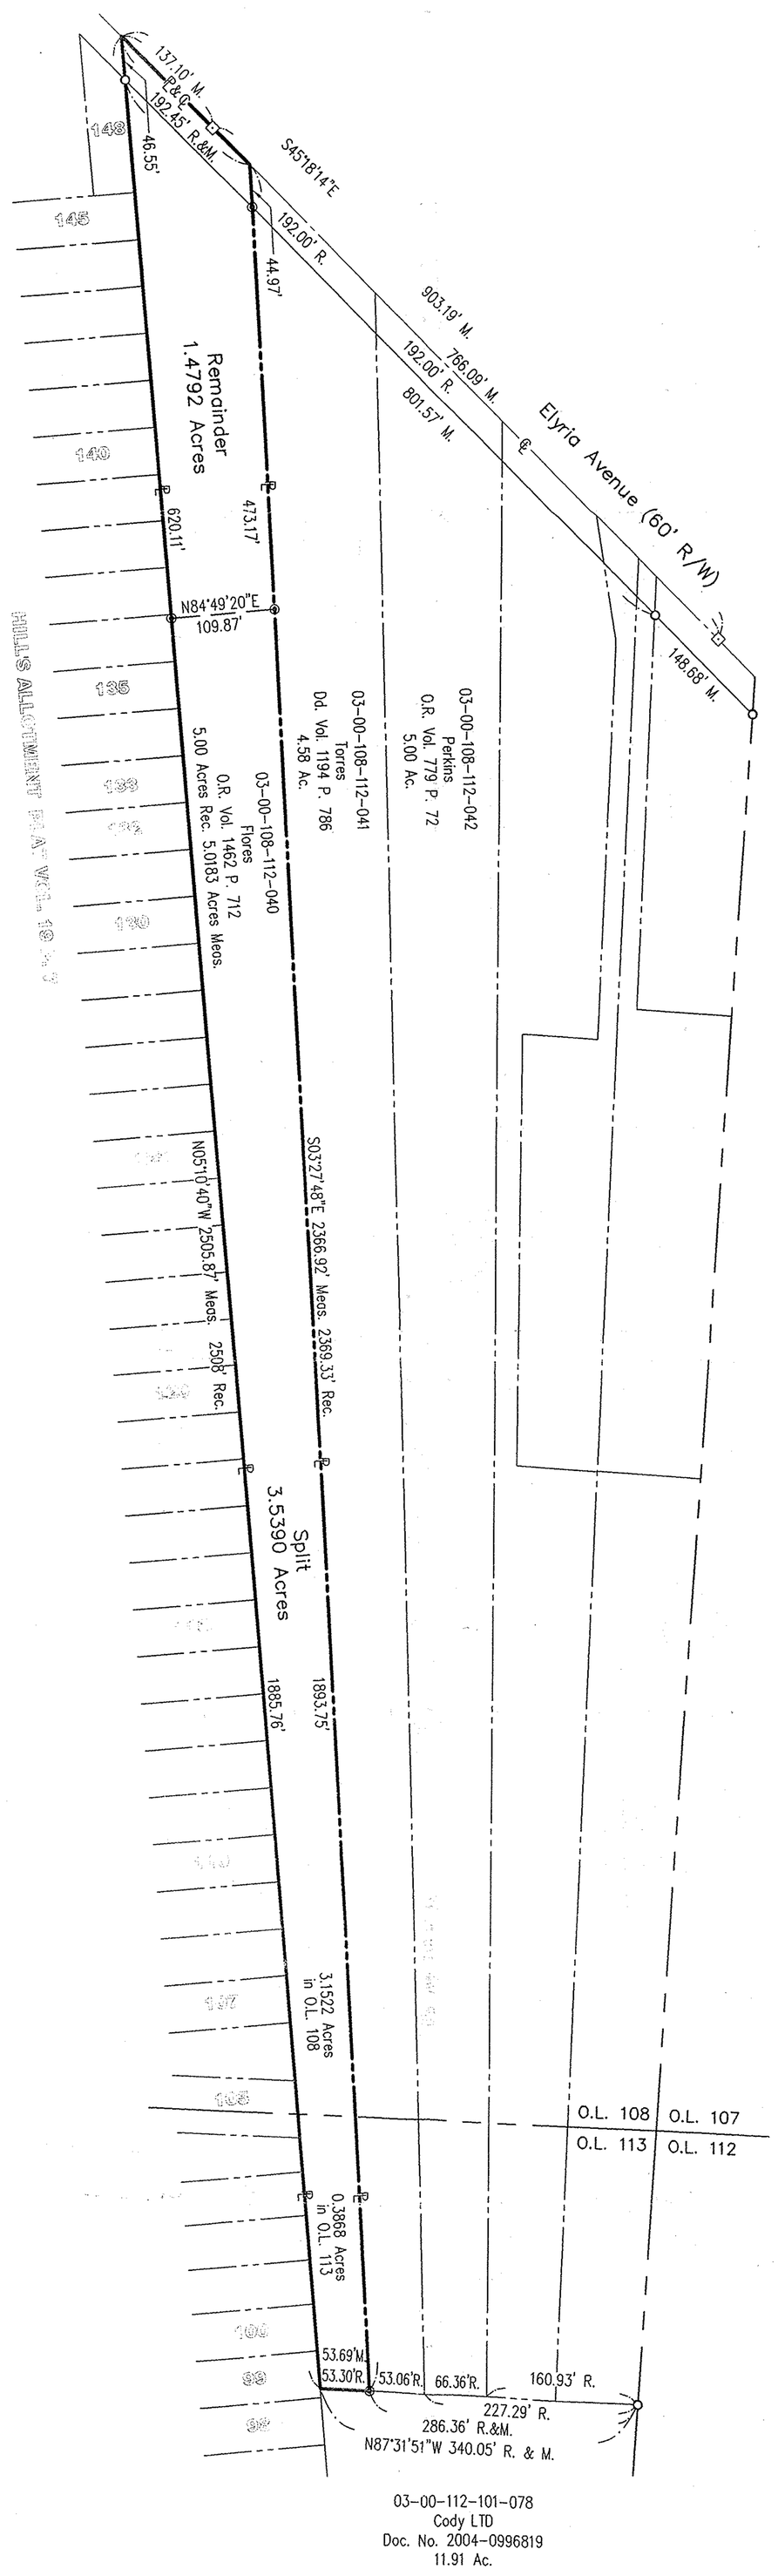

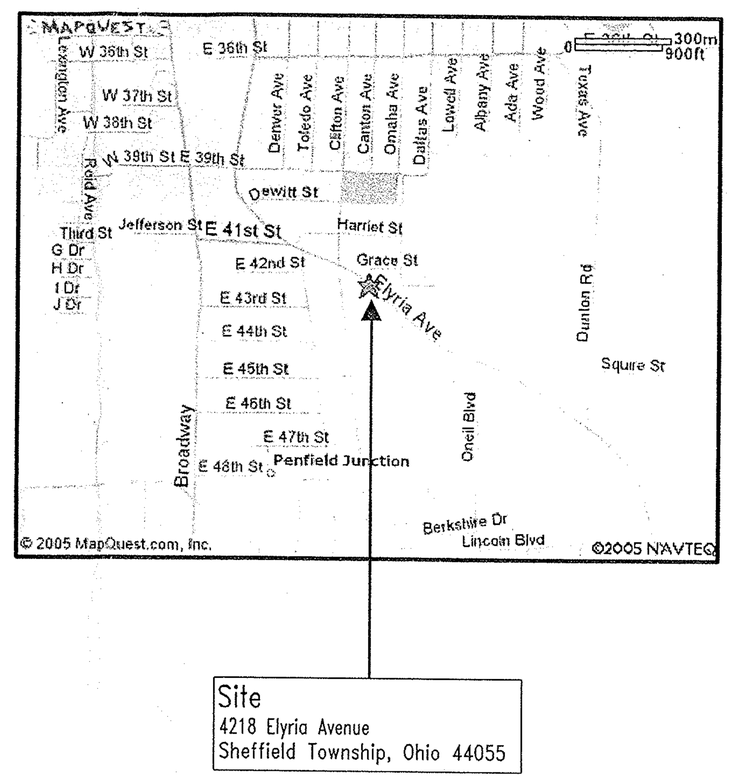

Site
4218 Elyria Avenue
Sheffield Township, Ohio 44055

LEGEND OF SYMBOLS & LINETYPES

- IRON PIN FOUND
- IRON PIN SET
  30" LONG, 5/8" REBAR WITH
  CAP STAMPED "HAYWOOD 8284"
- PROPERTY LINE
- CENTERLINE
- LOT SPLIT LINE

REC., R. ~ RECORD
MEAS., M. ~ MEASURED

Boundary Survey

0 50 100 200 400
SCALE: 1 IN. = 100 FT.

Prepared By

HAYWOOD
Civil Engineering & Land Surveying, Inc.

630 Cleveland Street
Elyria, Ohio 44035
www.haywoodcivilengineering.com
(440) 365-9831 Office
(440) 365-3426 Fax

Prepared For
Norma Flores
4218 Elyria Avenue
Sheffield Township, Ohio 44055
(440) 233-5624

No 01997

APPROVED
LORAIN CO.
ENGINEER
DATE 9-7-05
FAGIT 3-00-108-B
BY JHatfield
05-01997

STATE OF OHIO
DALE R. HAYWOOD
S-8284
REGISTERED
PROFESSIONAL SURVEYOR

Dimensions shown on this plat are in feet and decimal parts thereof, all bearings are to an assumed meridian and intended to describe angles only. Permanent monuments were found or set at all points indicated hereon, all of which I certify to be correct.

The basis of bearings is the east line of Hill's Allotment – North 05°10'40" West.

Dale Haywood 5/9/05
Dale R. Haywood, P.S. Date
Registered State of Ohio Surveyor No. 8284

COPY

REVISION May 2005
April 2005
Project #05-265 Flores