BOUNDARY SURVEY

for

OHIO EDISON COMPANY

SITUATED IN THE CITY OF LORAIN, COUNTY OF LORAIN, STATE OF OHIO AND KNOWN AS BEING PART OF ORIGINAL BLACK RIVER TOWNSHIP LOT NUMBER 3, TRACT NUMBER 3.

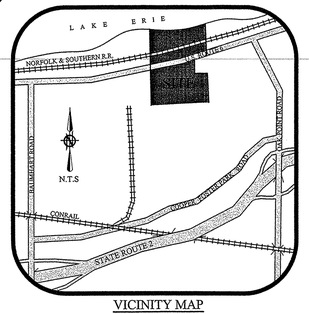

VICINITY MAP

GRAPHIC SCALE

0 60 120 240

(IN FEET)

SCALE: 1" = 120'

BASIS OF BEARINGS:

A PORTION OF THE CENTERLINE OF U.S. ROUTE 6 (a.k.a. LAKE ROAD) (WIDTH VARIES) WHICH WAS ASSUMED TO BE NORTH 71° 50' 00" EAST AS OBSERVED IN LORAIN COUNTY RIGHT-OF-WAY PLANS LOR-6-(0.00-1.75)

AS SURVEYED IN AUGUST OF 2005

LEGEND OF SYMBOLS AND LINETYPES

—℄—	CENTERLINE OF RIGHT-OF-WAY
○	IRON PIPE OR PIN FOUND AS INDICATED
●	5/8" IRON REBAR W/CAP STAMPED "BRAMHALL 8073" SET
P.O.C.	POINT OF COMMENCEMENT
T.P.O.B.	TRUE PLACE OF BEGINNING
—x—	FENCE
(F) (FND.)	FOUND
(R) (REC.)	RECORD
(M) (MEAS.)	MEASURED
(C) (CALC.)	CALCULATED
B/W	RIGHT-OF-WAY LINE
[M]	MONUMENT BOX WITH 1" IRON PIN FOUND

PARCEL SUMMARY
N.T.S

SURVEYOR'S CERTIFICATE:

THIS IS TO CERTIFY THAT, AT THE REQUEST OF THE OWNERS, I HAVE SURVEYED AND PLATTED THE BOUNDARY SURVEY AS SHOWN HEREON, SITUATED IN THE CITY OF LORAIN, COUNTY OF LORAIN, STATE OF OHIO AND KNOWN AS BEING A PARCEL OF LAND DESCRIBED IN A DEED TO OHIO EDISON COMPANY AS RECORDED IN VOLUME 637, PAGE 76 OF THE LORAIN COU NTY DEED RECORDS, CONTAINING 182.5697 ACRES OF LAND IN ORIGINAL BLACK RIVER TOWNSHIP LOT NUMBER 3, TRACT NUMBER 3, BE THE SAME MORE OR LESS, BUT SUBJECT TO ALL LEGAL HIGHWAYS AND EASEMENTS. AT ALL POINTS THUSLY INDICATED ○ IRON PIN MONUMENTS WERE FOUND AND AT ALL POINTS THUSLY INDICATED ● IRON PIN MONUMENTS WERE SET. DISTANCES ARE SHOWN IN FEET AND DECIMAL PARTS THEREOF. BEARINGS SHOWN ARE ASSUMED AND USED TO DESCRIBE ANGLES ONLY. THE PLAN REPRESENTS A SURVEY IN WHICH A TRAVERSE OF THE EXTERIOR BOUNDARIES OF THE TRACT AND EACH BLOCK COMPUTED FROM FIELD MEASUREMENTS OF GROUND CLOSED WITHIN A LIMIT OF ERROR OF ONE (1) FOOT TO TEN THOUSAND (10,000) FEET OF THE PERIMETER BEFORE BALANCING THE SURVEY. ALL OF WHICH I CERTIFY TO BE CORRECT.

Christopher M. Hirzel 8/31/2005

CHRISTOPHER M. HIRZEL, P.S.
REGISTERED SURVEYOR NO. 8081

DATE

STATE OF OHIO CHRISTOPHER M. HIRZEL 8081 REGISTERED PROFESSIONAL SURVEYOR

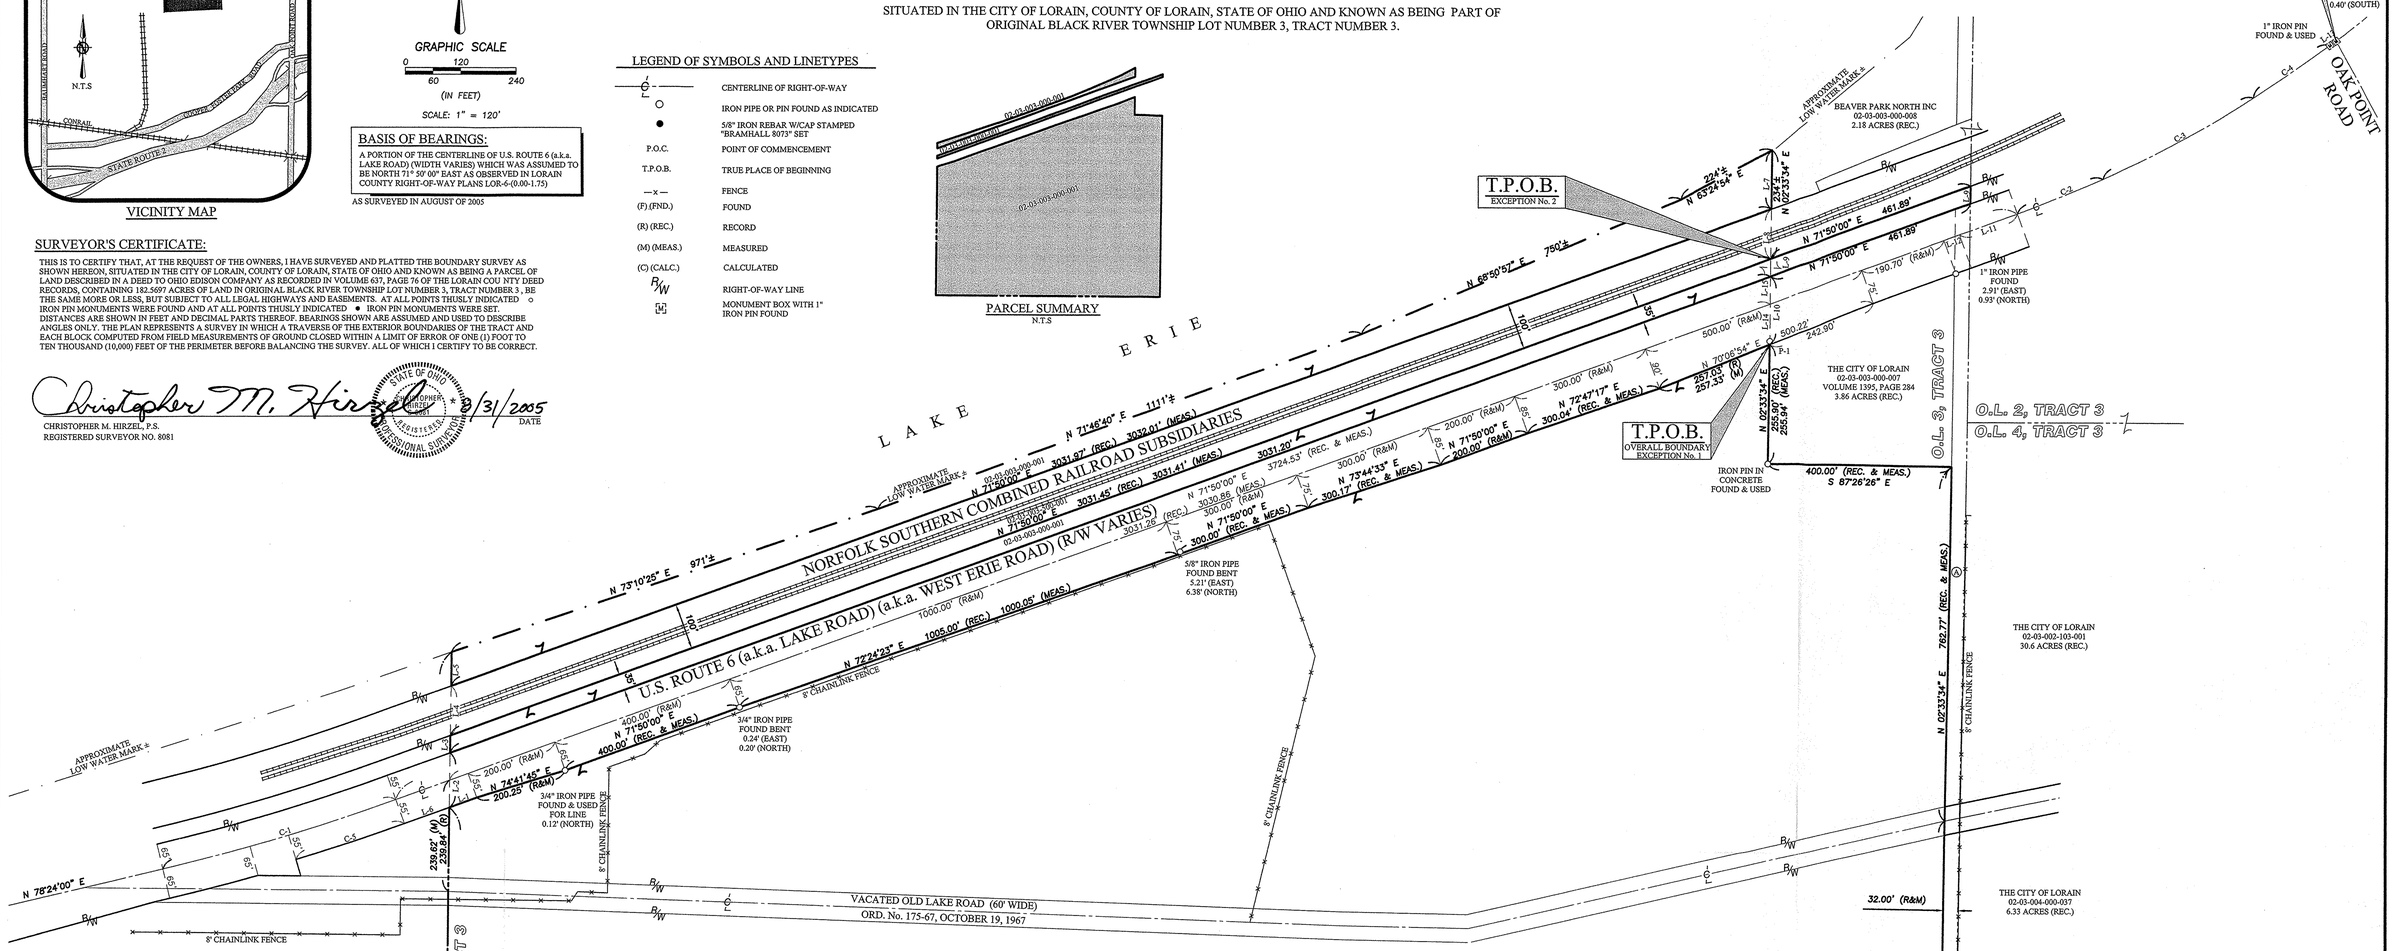

TABLE OF LINES		
LINE	BEARING	DISTANCE
L-1	N 71°50'00" E	63.00' (R&M) 63.47' (R)
L-2	N 02°15'25" E	117.40' (REC.) 117.38' (MEAS.)
L-3	N 02°15'25" E	37.35' (R&M)
L-4	N 02°15'25" E	106.42' (REC.) 106.71' (MEAS.)
L-5	N 02°15'25" E	70.00' (REC.) 73' ± (MEAS.)
L-6	N 71°50'00" E	102.57' (R&M)
L-7	N 02°33'34" E	245.00'(REC.) 127' ± (MEAS.)
L-8	N 02°33'34" E	106.91' (REC.) 106.92' (MEAS.)
L-9	N 02°33'34" E	37.42' (R&M)
L-10	N 02°33'34" E	146.78' (R&M)
L-11	N 71°50'00" E	124.86'
L-12	N 71°50'00" E	35.50' (R&M)
L-13	N 02°33'34" E	16.19'
L-14	N 02°33'34" E	87.98'
L-15	N 55°05'00" E	58.81'

TABLE OF MONUMENTS	
PIN	DESCRIPTION
P-1	3/4" IRON PIPE FOUND 0.43' (EAST) 7.67' (NORTH)

TABLE OF OWNERSHIP	
Ⓐ	LORAIN COUNTY METRO PARK DISTRICT BOARD OF PARK COMMISSIONERS 02-03-003-000-004 DOC. # 200309042759 1.29 ACRES (REC.)
Ⓑ	LORAIN COUNTY METRO PARK DISTRICT BOARD OF PARK COMMISSIONERS DOC. # 199906061588 0.98 OF AN ACRE (REC.)

TABLE OF CURVES						
CURVE	LENGTH	RADIUS	CHORD	BEARING	TANGENT	DELTA
C-1	525.33'	4583.66'	525.05'	N 75°07'00" E	262.95'	01°15'00"
C-2	200.00'	3055.91'	199.97'	N 69°57'30" E	100.04'	03°45'00"
C-3	370.00'	2291.83'	369.60'	N 63°27'30" E	185.40'	09°15'00"
C-4	200.00'	3055.91'	199.97'	N 56°57'30" E	100.04'	03°45'00"
C-5	247.37'	4638.66'	247.34'	N 73°21'40" E	123.71'	03°03'19"

REVISIONS		
DATE:	BY:	DESCRIPTION:
08-16-05	CMH	ISSUE TO CLIENT
09-01-05	CMH	REVISED PER CLIENT

P.P. NO.	02-03-003-000-001
SPLIT #	#05-01200-0
DATE OF SURVEY	8/31/05
MAP PAGE	2-E
SURVEYOR	Christopher M. Hirzel

APPROVED
LORAIN CO.
MAP DEPT
DATE 9/23/05
PAGE 2-E
BY D. Holland
#05-01200-0

DRAWN BY: BDA

CHECKED BY: CMH

BRAMHALL
ENGINEERING AND SURVEYING CO., INC.
37307 HARVEST DRIVE AVON, OHIO 44011
(440) 934 - 7878 (440) 934 - 7879 FAX

SHEET 1 OF 1

JOB NO. 05-2145

ED J:\JS2145\DRAWINGS\DWG\MASTER.DWG