THOMAS W. & KAREN S. GRASSE
O.V. 1421 P. 718

DAVID C. DILLEN & FRAN ZUPANCIC
INST. Nº 980546790

JAMES E. & KOLLEEN T. HOOOUS
INST. Nº 980575386

JAMES GROBE ET AL TRS
O.V. 1190 P. 925

ASHER & FRANCINE REYNOLDS
O.V 1290 P. 505

LAGRANGE RD.

SLIFE RD.

SEC. 18

SEC. 17

SEC. 23

1 2.4542 Ac.℄ 0.1721 Ac. R/W

2 2.4631 Ac.℄ 0.1722 Ac. R/W

3 2.9624 ℄'s 0.4924 Ac. R/W's

4 2.1554 Ac.℄ 0.1654 Ac. R/W

RMDR. of -006
~~32.2900 Ac.~~
22.2349 Ac.

-040
RMDR of -008
~~28.2780 Ac.~~
19.7116 Ac.

-039 4 2.1391 Ac.℄ 0.1370 Ac. R/W

-038 3 2.1407 Ac.℄ 0.1370 Ac. R/W

-037 2 2.1425 Ac.℄ 0.1370 Ac. R/W

-036 1 2.1441 Ac.℄ 0.1372 Ac. R/W

#00497
APPROVED
LORAIN CO.
MAP DEPT.
DATE 7/19/00
BY T. SPILLMAN
NO. 00497

STATE OF OHIO
RODGER G. SIMON
5101
REGISTERED SURVEYOR

SURVEY FOR

RAINTREE DEVELOPMENT GROUP

PART OF ORIG. SEC. 18 — TOWNSHIP OF CARLISLE
COUNTY OF LORAIN — STATE OF OHIO
SCALE 1" = 100' — FEB. 1999

BY

LAUNDON • SIMON • CAHL & ASSOC.
PROFESSIONAL LAND SURVEYORS
JOB Nº 99-3121 — FB. 245 P. 2 & 7

REVISED 6/8/00 Split 8 lots from Orig. Survey
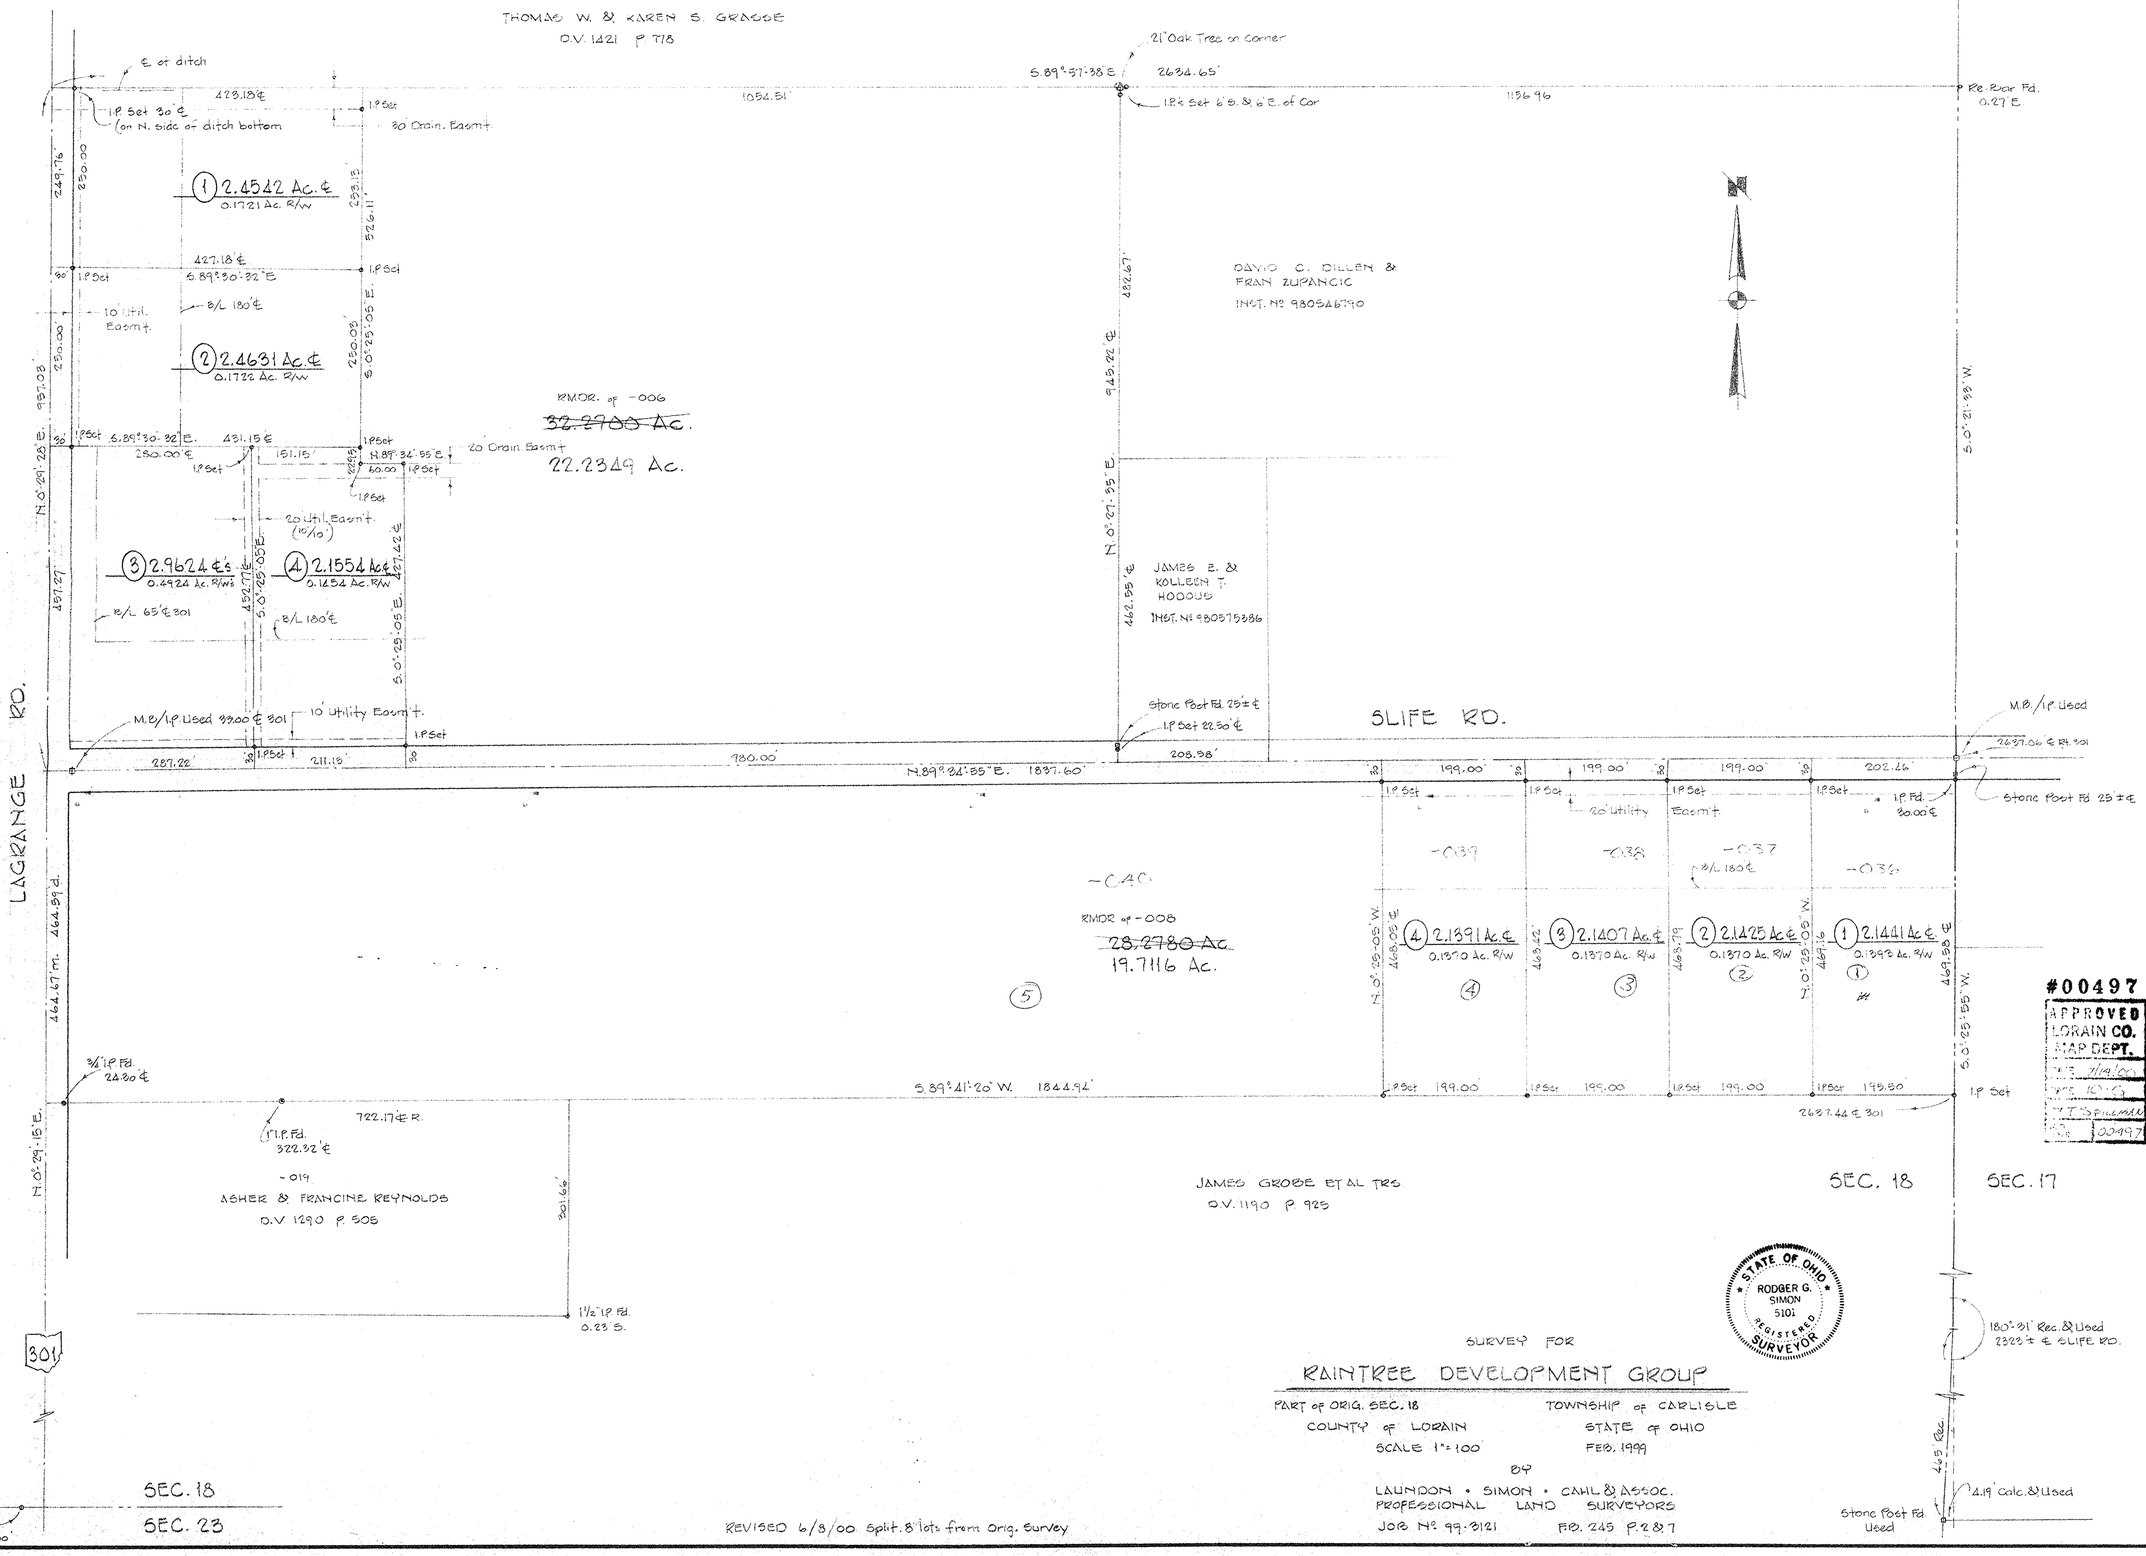
010-080-018-102