18-00-006-000-045 thru 048

MAP OF SURVEY AND LOT SPLIT

PREPARED FOR

RICHARD SUGASKI AND LAURA W. KIMMEL

SITUATED IN THE TOWNSHIP OF WELLINGTON, COUNTY OF LORAIN, STATE OF OHIO AND BEING KNOWN AS PART OF ORIGINAL WELLINGTON TOWNSHIP LOT 6

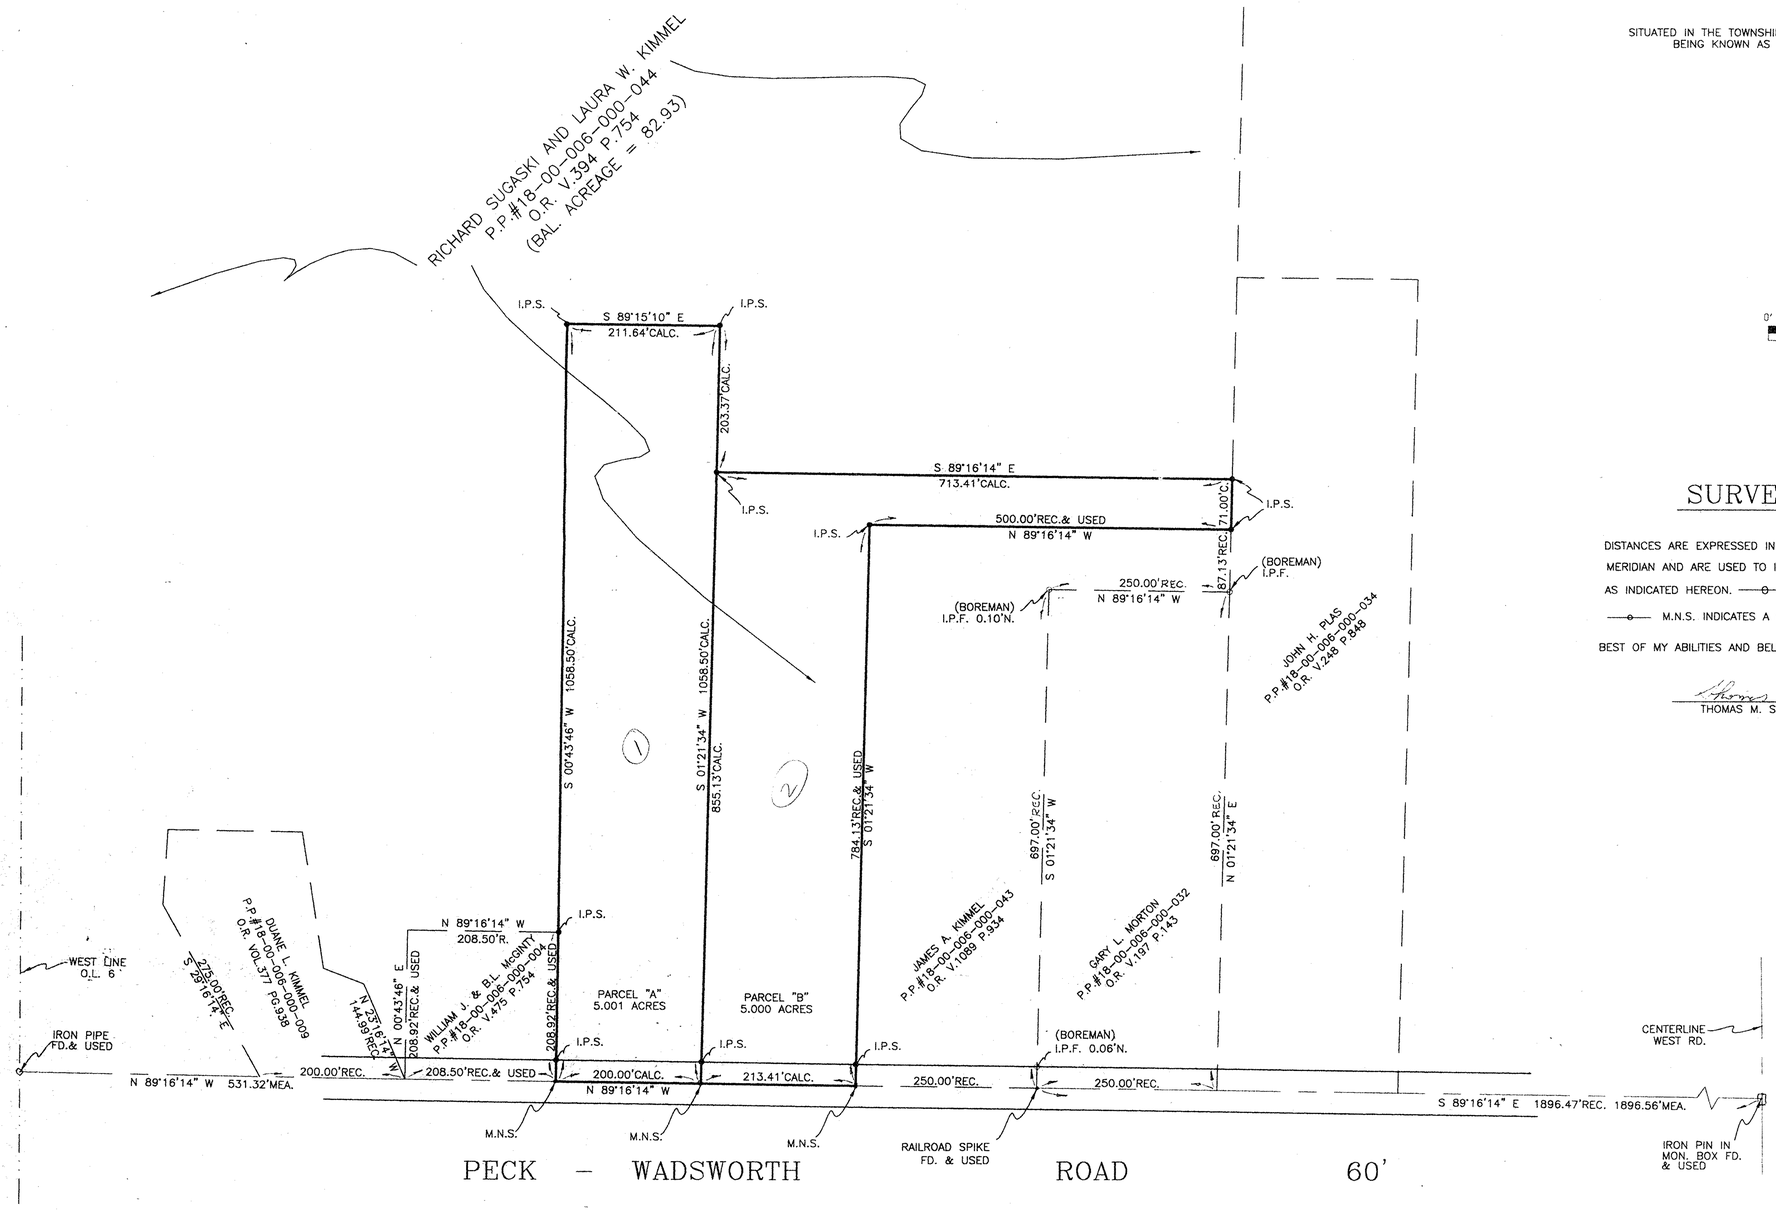

0' 100' 200' 300'

SCALE: 1" = 100'

SURVEYOR'S STATEMENT

DISTANCES ARE EXPRESSED IN FEET AND DECIMAL PARTS THEREOF. BEARINGS ARE TO AN ASSUMED MERIDIAN AND ARE USED TO INDICATE ANGLES ONLY. PERMANENT MONUMENTS WERE FOUND OR SET AS INDICATED HEREON. —o— I.P.S. INDICATES A 5/8" IRON PIN WITH IDENTIFICATION CAP SET. —o— M.N.S. INDICATES A MAGNETIC NAIL SET. ALL OF WHICH I DECLAIR TO BE CORRECT TO THE BEST OF MY ABILITIES AND BELIEF.

Thomas M. Snezek — 3-24-00

THOMAS M. SNEZEK, R.L.S. No.7051 — DATE

STATE OF OHIO
THOMAS M. SNEZEK S-7051
SURVEYOR

#00495
APPROVED
LORAIN CO.
MAP DEPT.
DATE 7/13/00
PAGE 18-D
BY T. SPILLMAN
JOB NO. 00495

PROJECT No.9930 3/23/00