15-00-094.000-026 thru 028
#00-00491

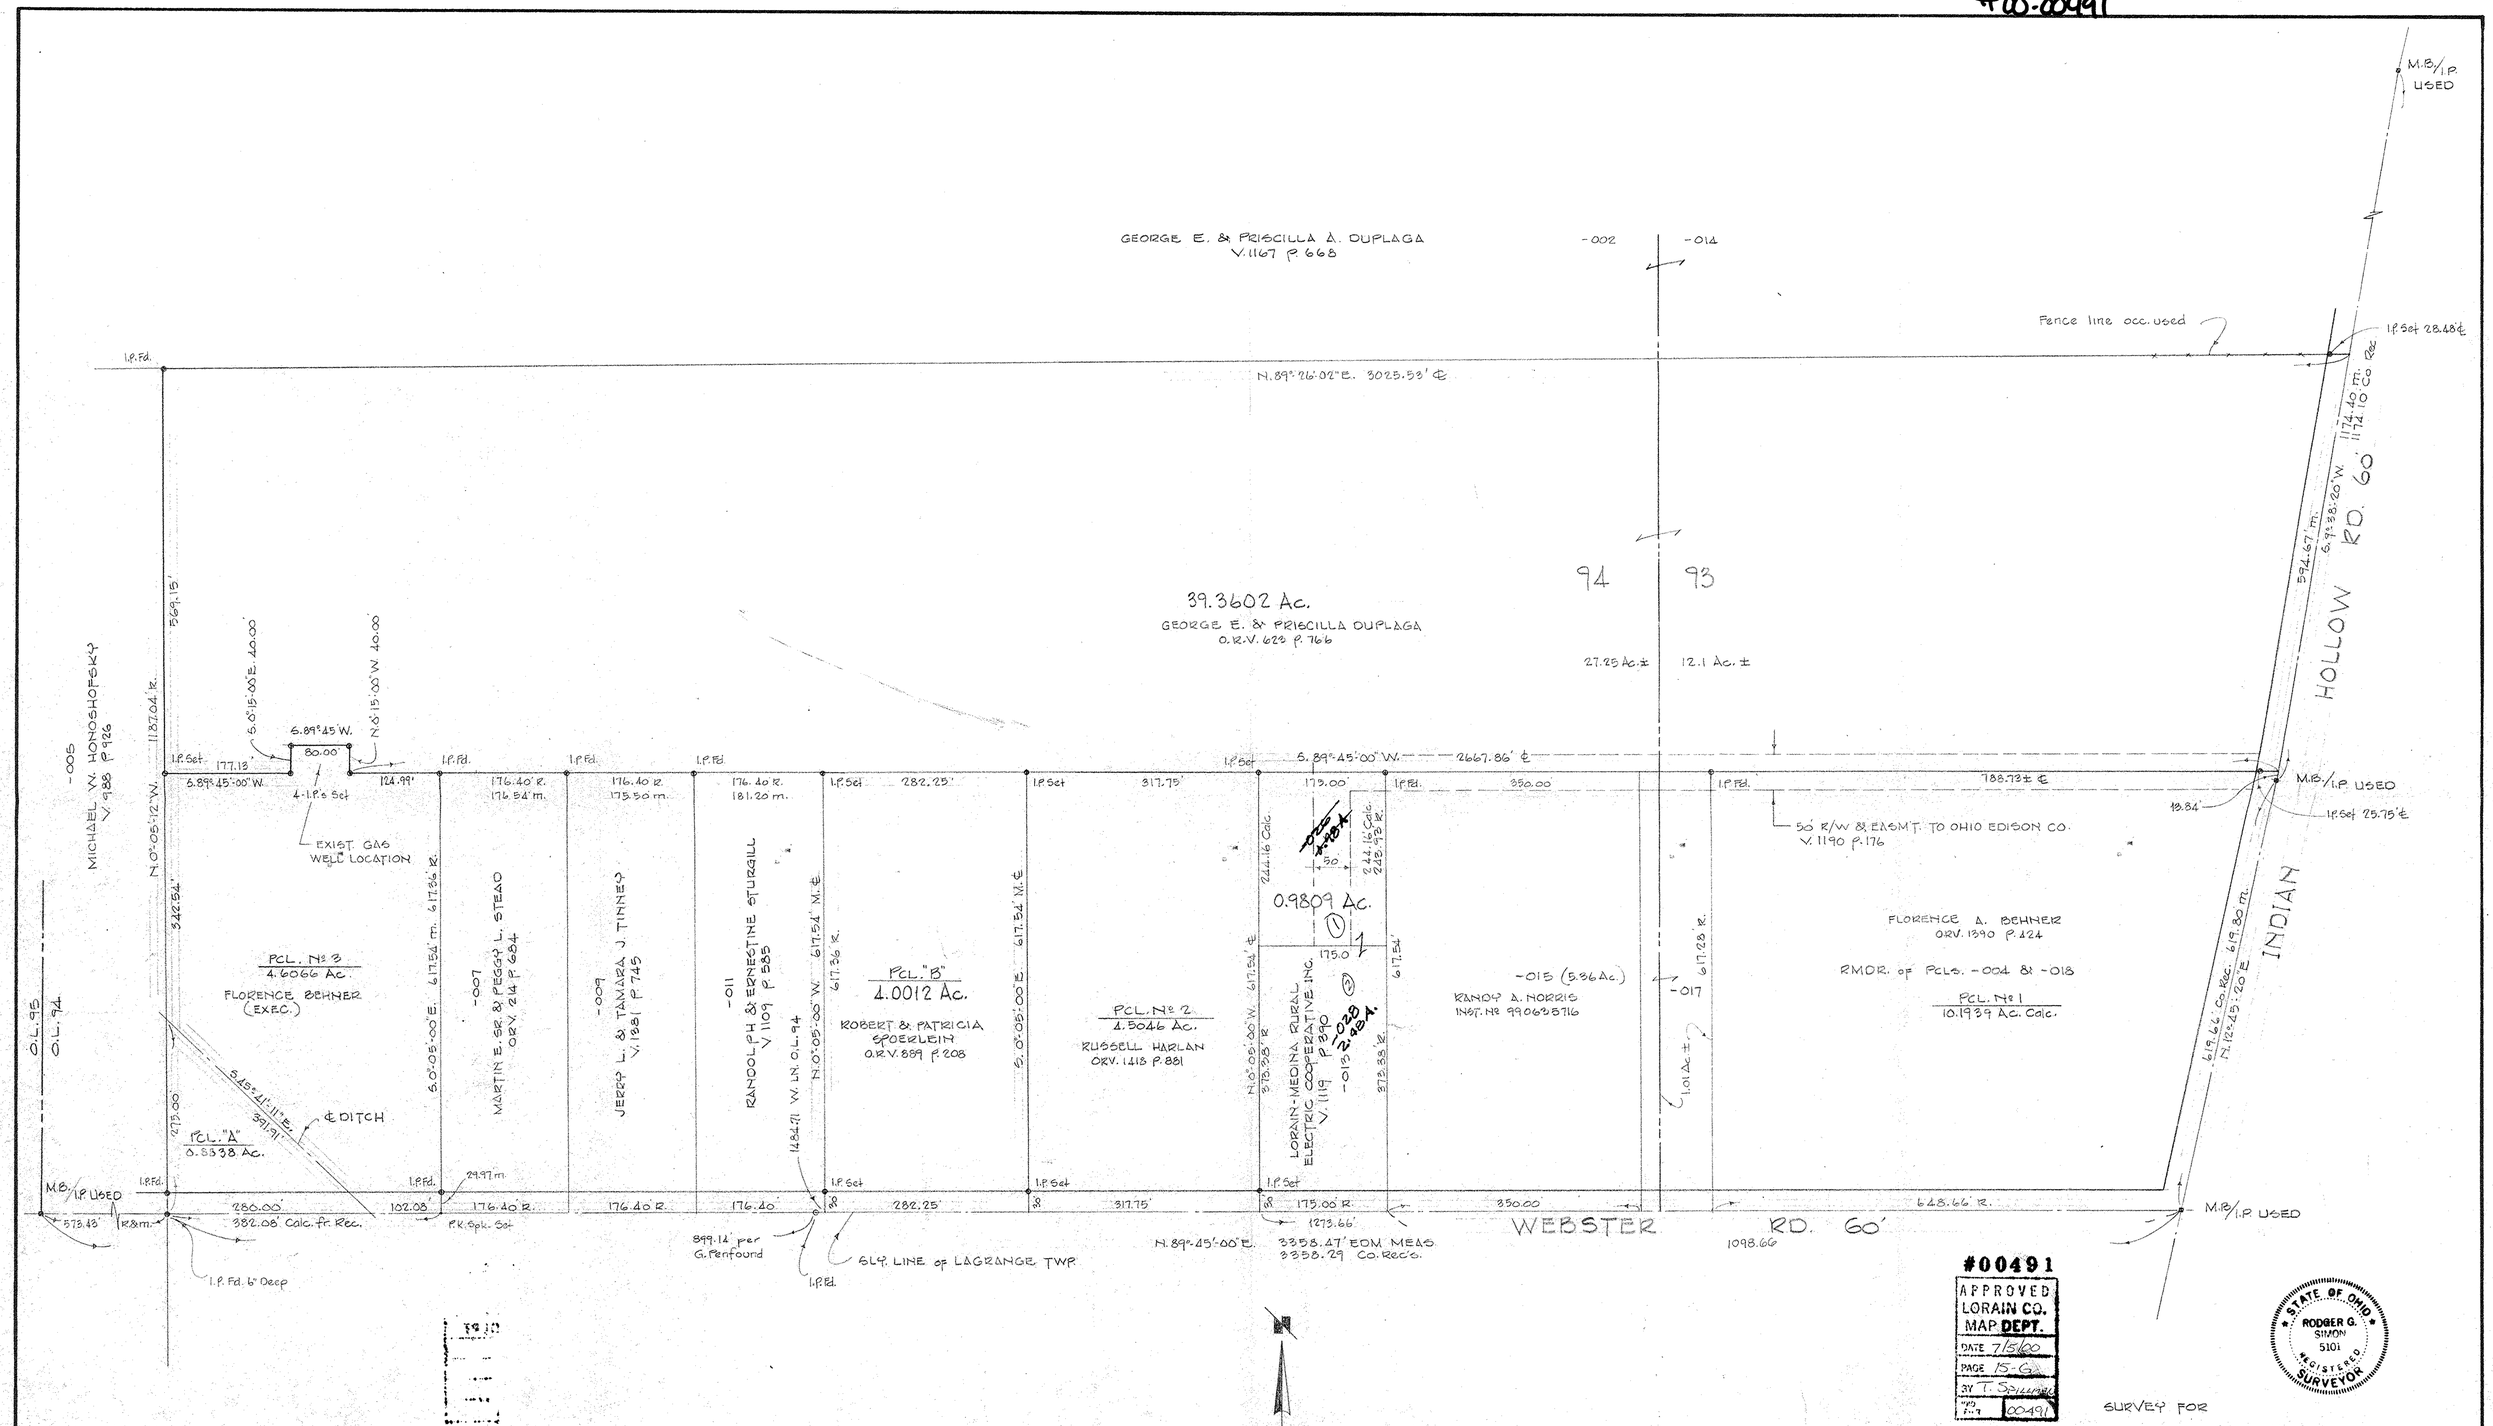

#00491

APPROVED
LORAIN CO.
MAP DEPT.
DATE 7/5/00
PAGE 15-G
BY T. Spillman
NO. 00491

STATE OF OHIO
RODGER G. SIMON
5101
REGISTERED SURVEYOR

SURVEY FOR

FLORENCE BEHNER & GEORGE E. and PRISCILLA DUPLAGA

PART OF O.L.s 93 & 94 TOWNSHIP OF LAGRANGE
COUNTY OF LORAIN STATE OF OHIO
SCALE 1" = 100' JULY 17, 1992
LAUNDON • SIMON • CAHL & ASSOC.
ENGINEERS SURVEYORS
110 MIDDLE AVE. ELYRIA, O. 44035
JOB Nº 92-2219 F.B. 218/13

REVISED 3-21-2000 Add 0.9809 Ac. to LMRE Pcl. - Update owners
REVISED 9-13-96 PCLS. 2 & 3
REVISED 10-21-93 Add PCL. "B" & Corr. Orig. Survey
REVISED 4-16-93 Add PCL. "A" R.G.S.

282