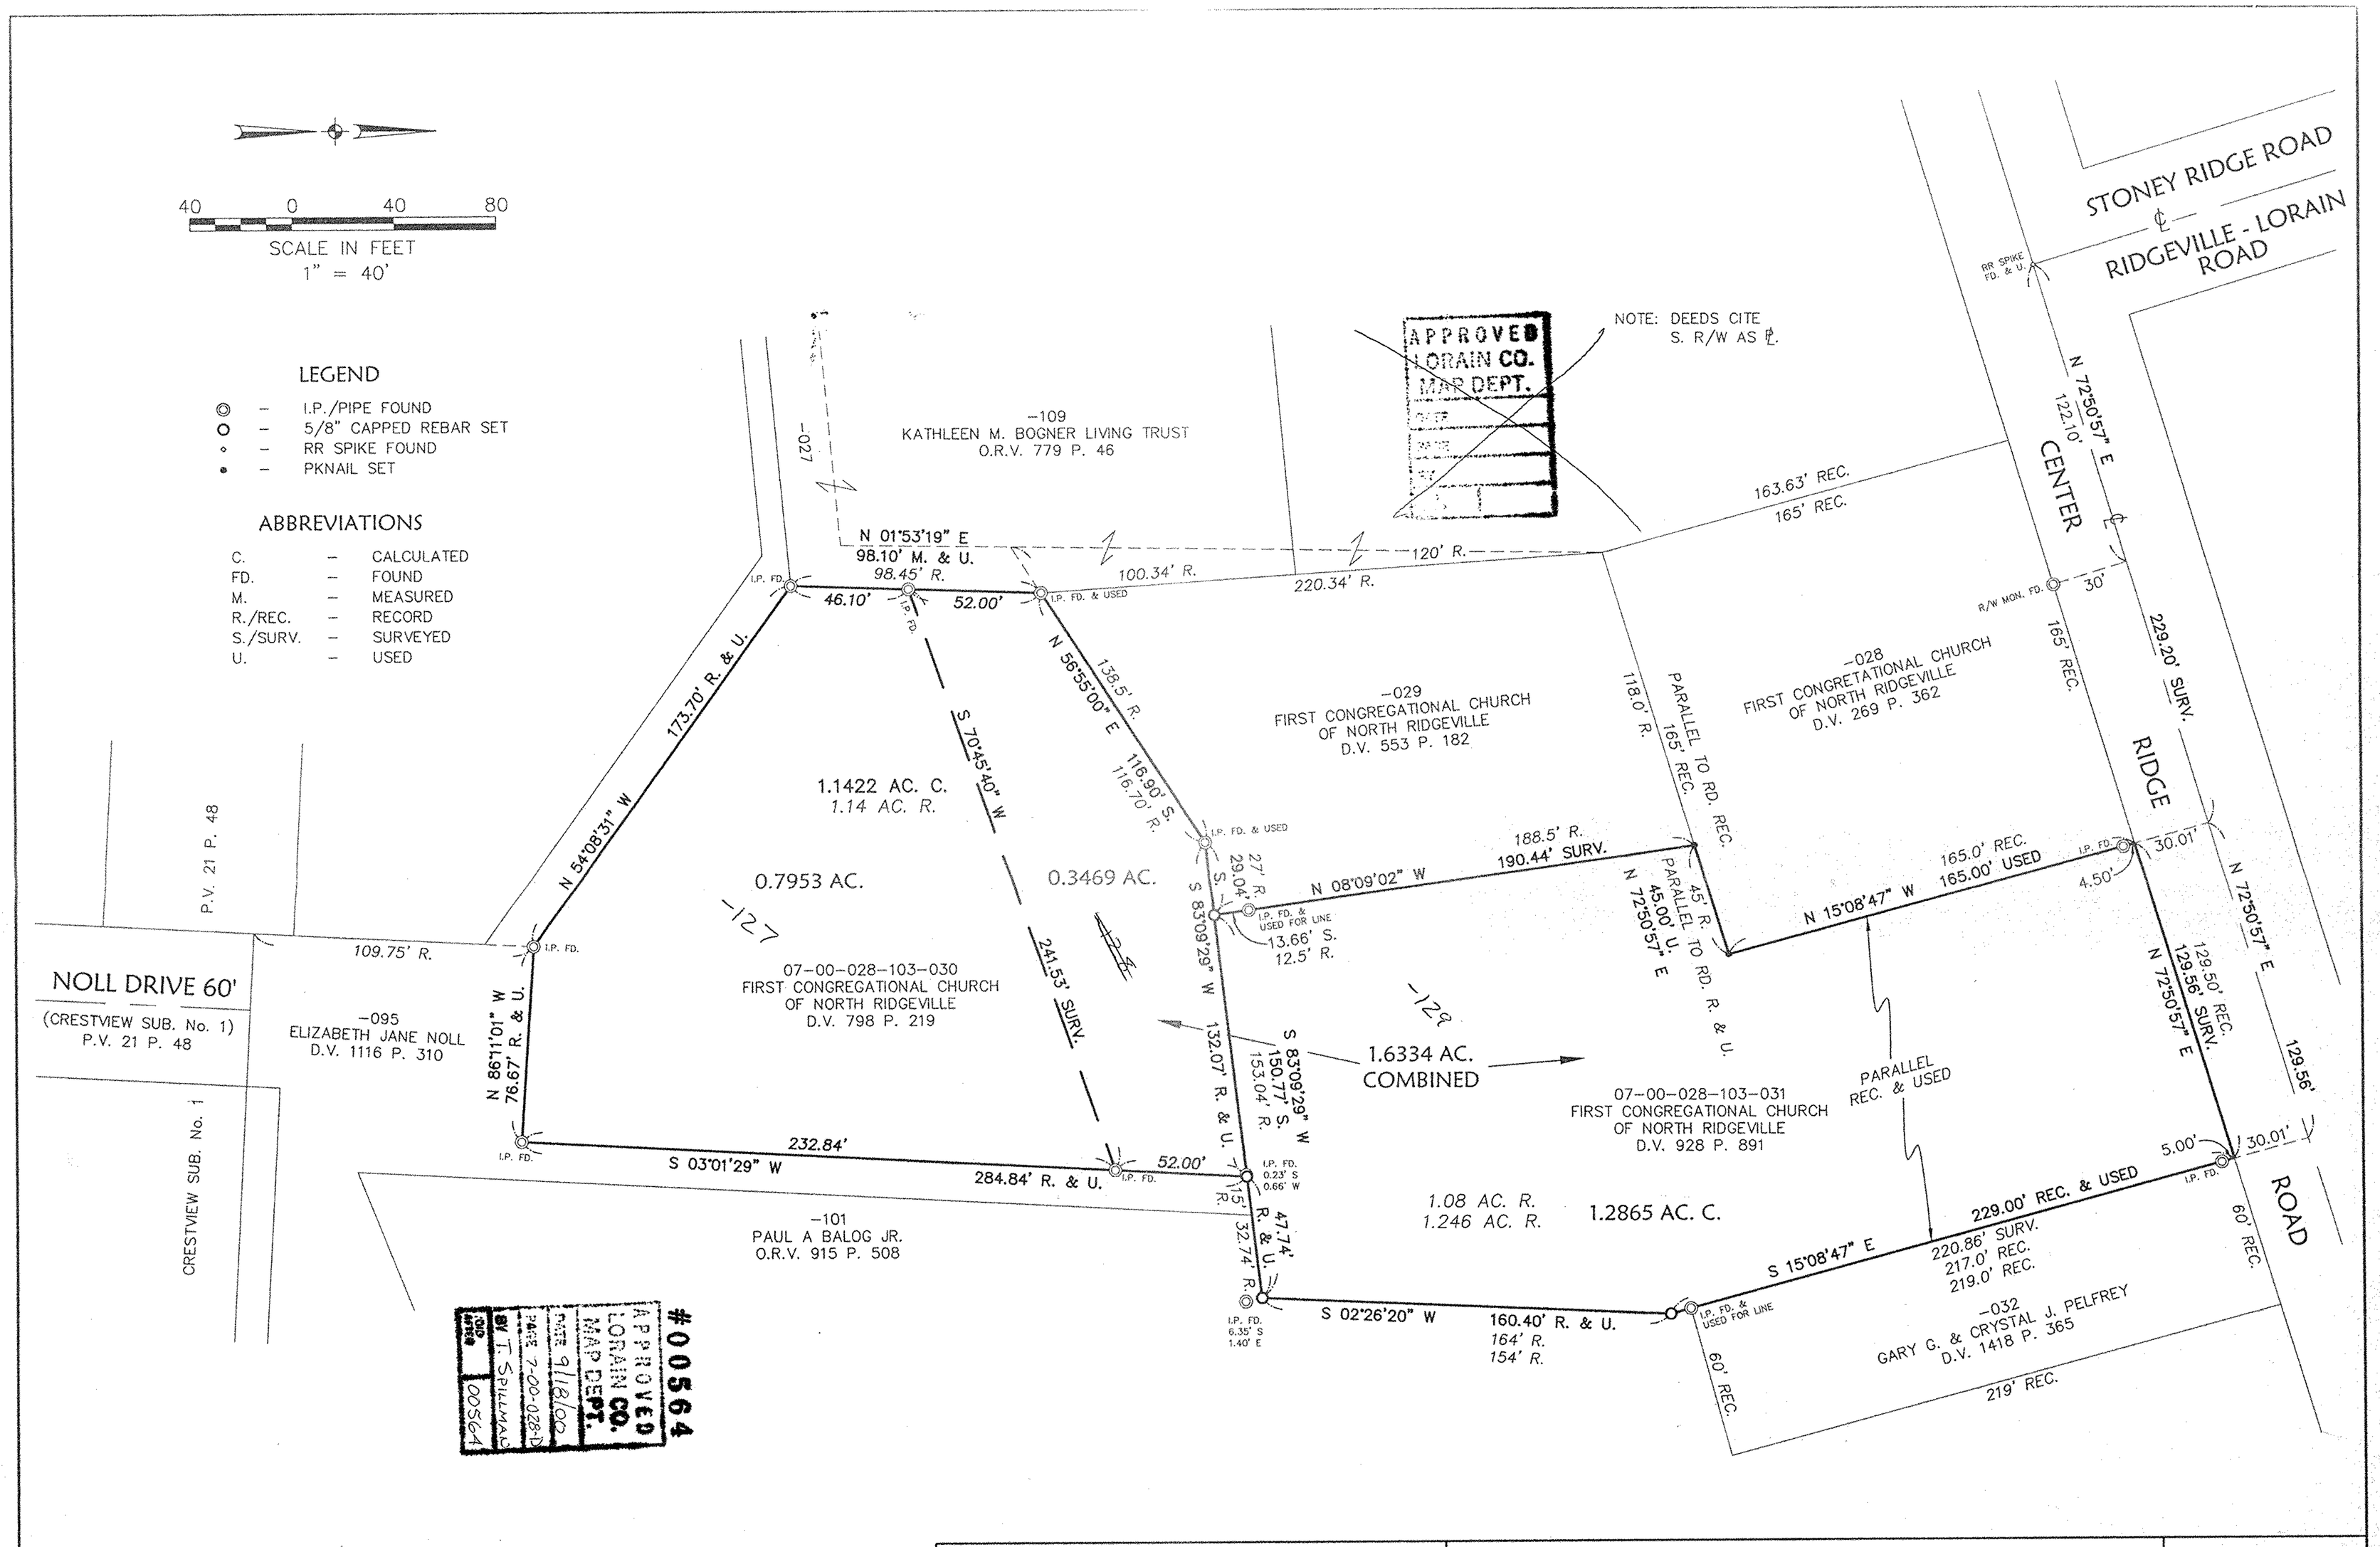

STATE OF OHIO
DAVID L. ELWELL
6333
REGISTERED SURVEYOR

David L. Elwell
DAVID L. ELWELL, REGISTERED SURVEYOR No. 6333

KS ASSOCIATES
KS ASSOCIATES, INC.
260 Burns Road, Suite 100
P.O. Box 569
Elyria, Ohio 44036
Phone (440) 365-4730
Fax (440) 365-4790
mailroom@ksassoc.com
www.ksassoc.com

SURVEY MAP

PART OF ORIGINAL RIDGEVILLE TOWNSHIP LOT NO. 28
CITY OF NORTH RIDGEVILLE
COUNTY OF LORAIN STATE OF OHIO

JOB NO. 93303-00
DATE: 7-19-00
SCALE: 1"=40'
DWG: 0-SURV01