LAUNDON • SIMON • CAHL & ASSOC. INC.
CONSULTING ENGINEERS & SURVEYORS
504 MIDDLE AVENUE ELYRIA, OHIO 44035

SURVEY FOR
HOWARD & ROSE WEISS

Orig. Lot 16	City of ELYRIA	Date JAN. 10, 1984 Scale 1"=60
Orig. Sec	Village of	Dwn. by R.G.S. Chkd. by J.C.
Tract EAST OF RIVER	County of LORAIN	Job No. 83-1251 F.B.
Township of ELYRIA	State of OHIO	Printed

S/L's 15 & 16
PADLOCK'S SUB'N.
V. 2 PG. 13

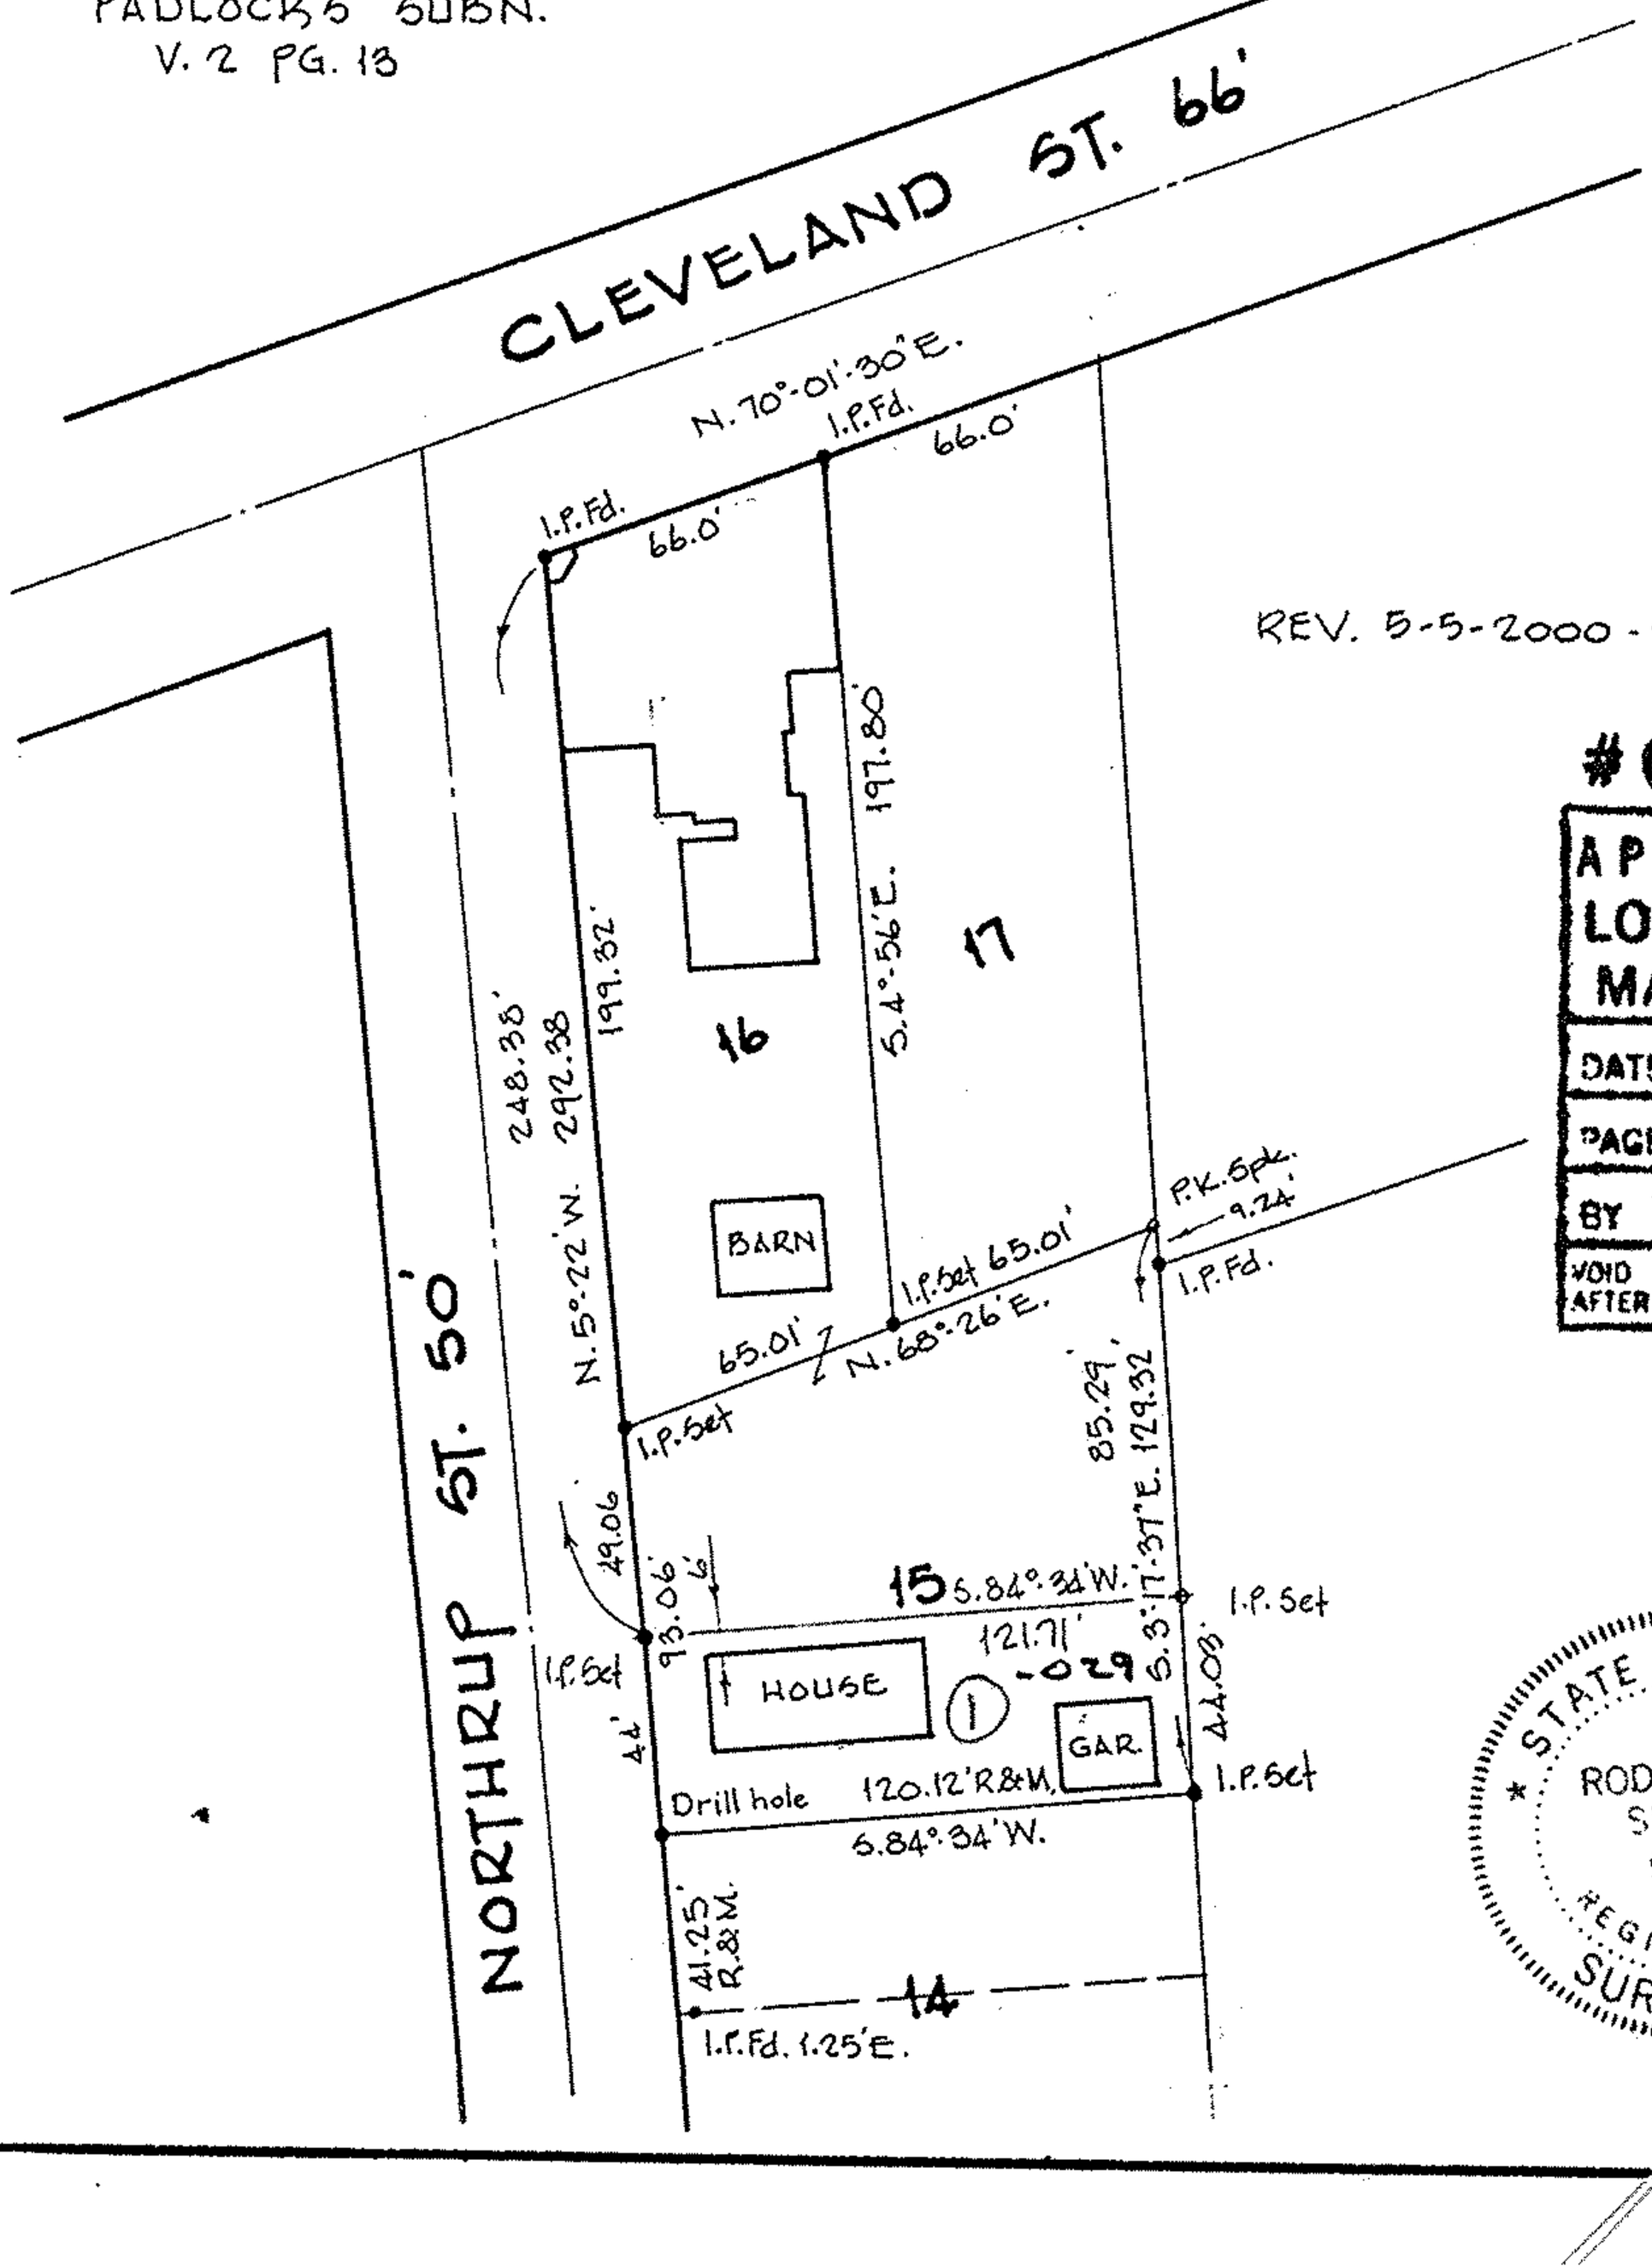

N

REV. 5-5-2000 - Split S/L 15

#00447

APPROVED
LORAIN CO.
MAP DEPT.
DATE 6/1/00
PAGE 6-105
BY T. Smith
VOID AFTER 00447

STATE OF OHIO
RODGER G. SIMON 5101
REGISTERED SURVEYOR