# HAPONEK & ASSOCIATES, INC.

Engineers & Surveyors
34100 Center Ridge Road
NORTH RIDGEVILLE, OHIO 44039
(216) 327-4776

STATE OF OHIO
DANE A. HAPONEK
S-6211
REGISTERED SURVEYOR

PREPARED FOR
WALTER RAUSCHER
959 HARRIS RD.
SHEFFIELD VILLAGE, O.

DATE: SEPT 29, 1987
SCALE: 1" = 100'

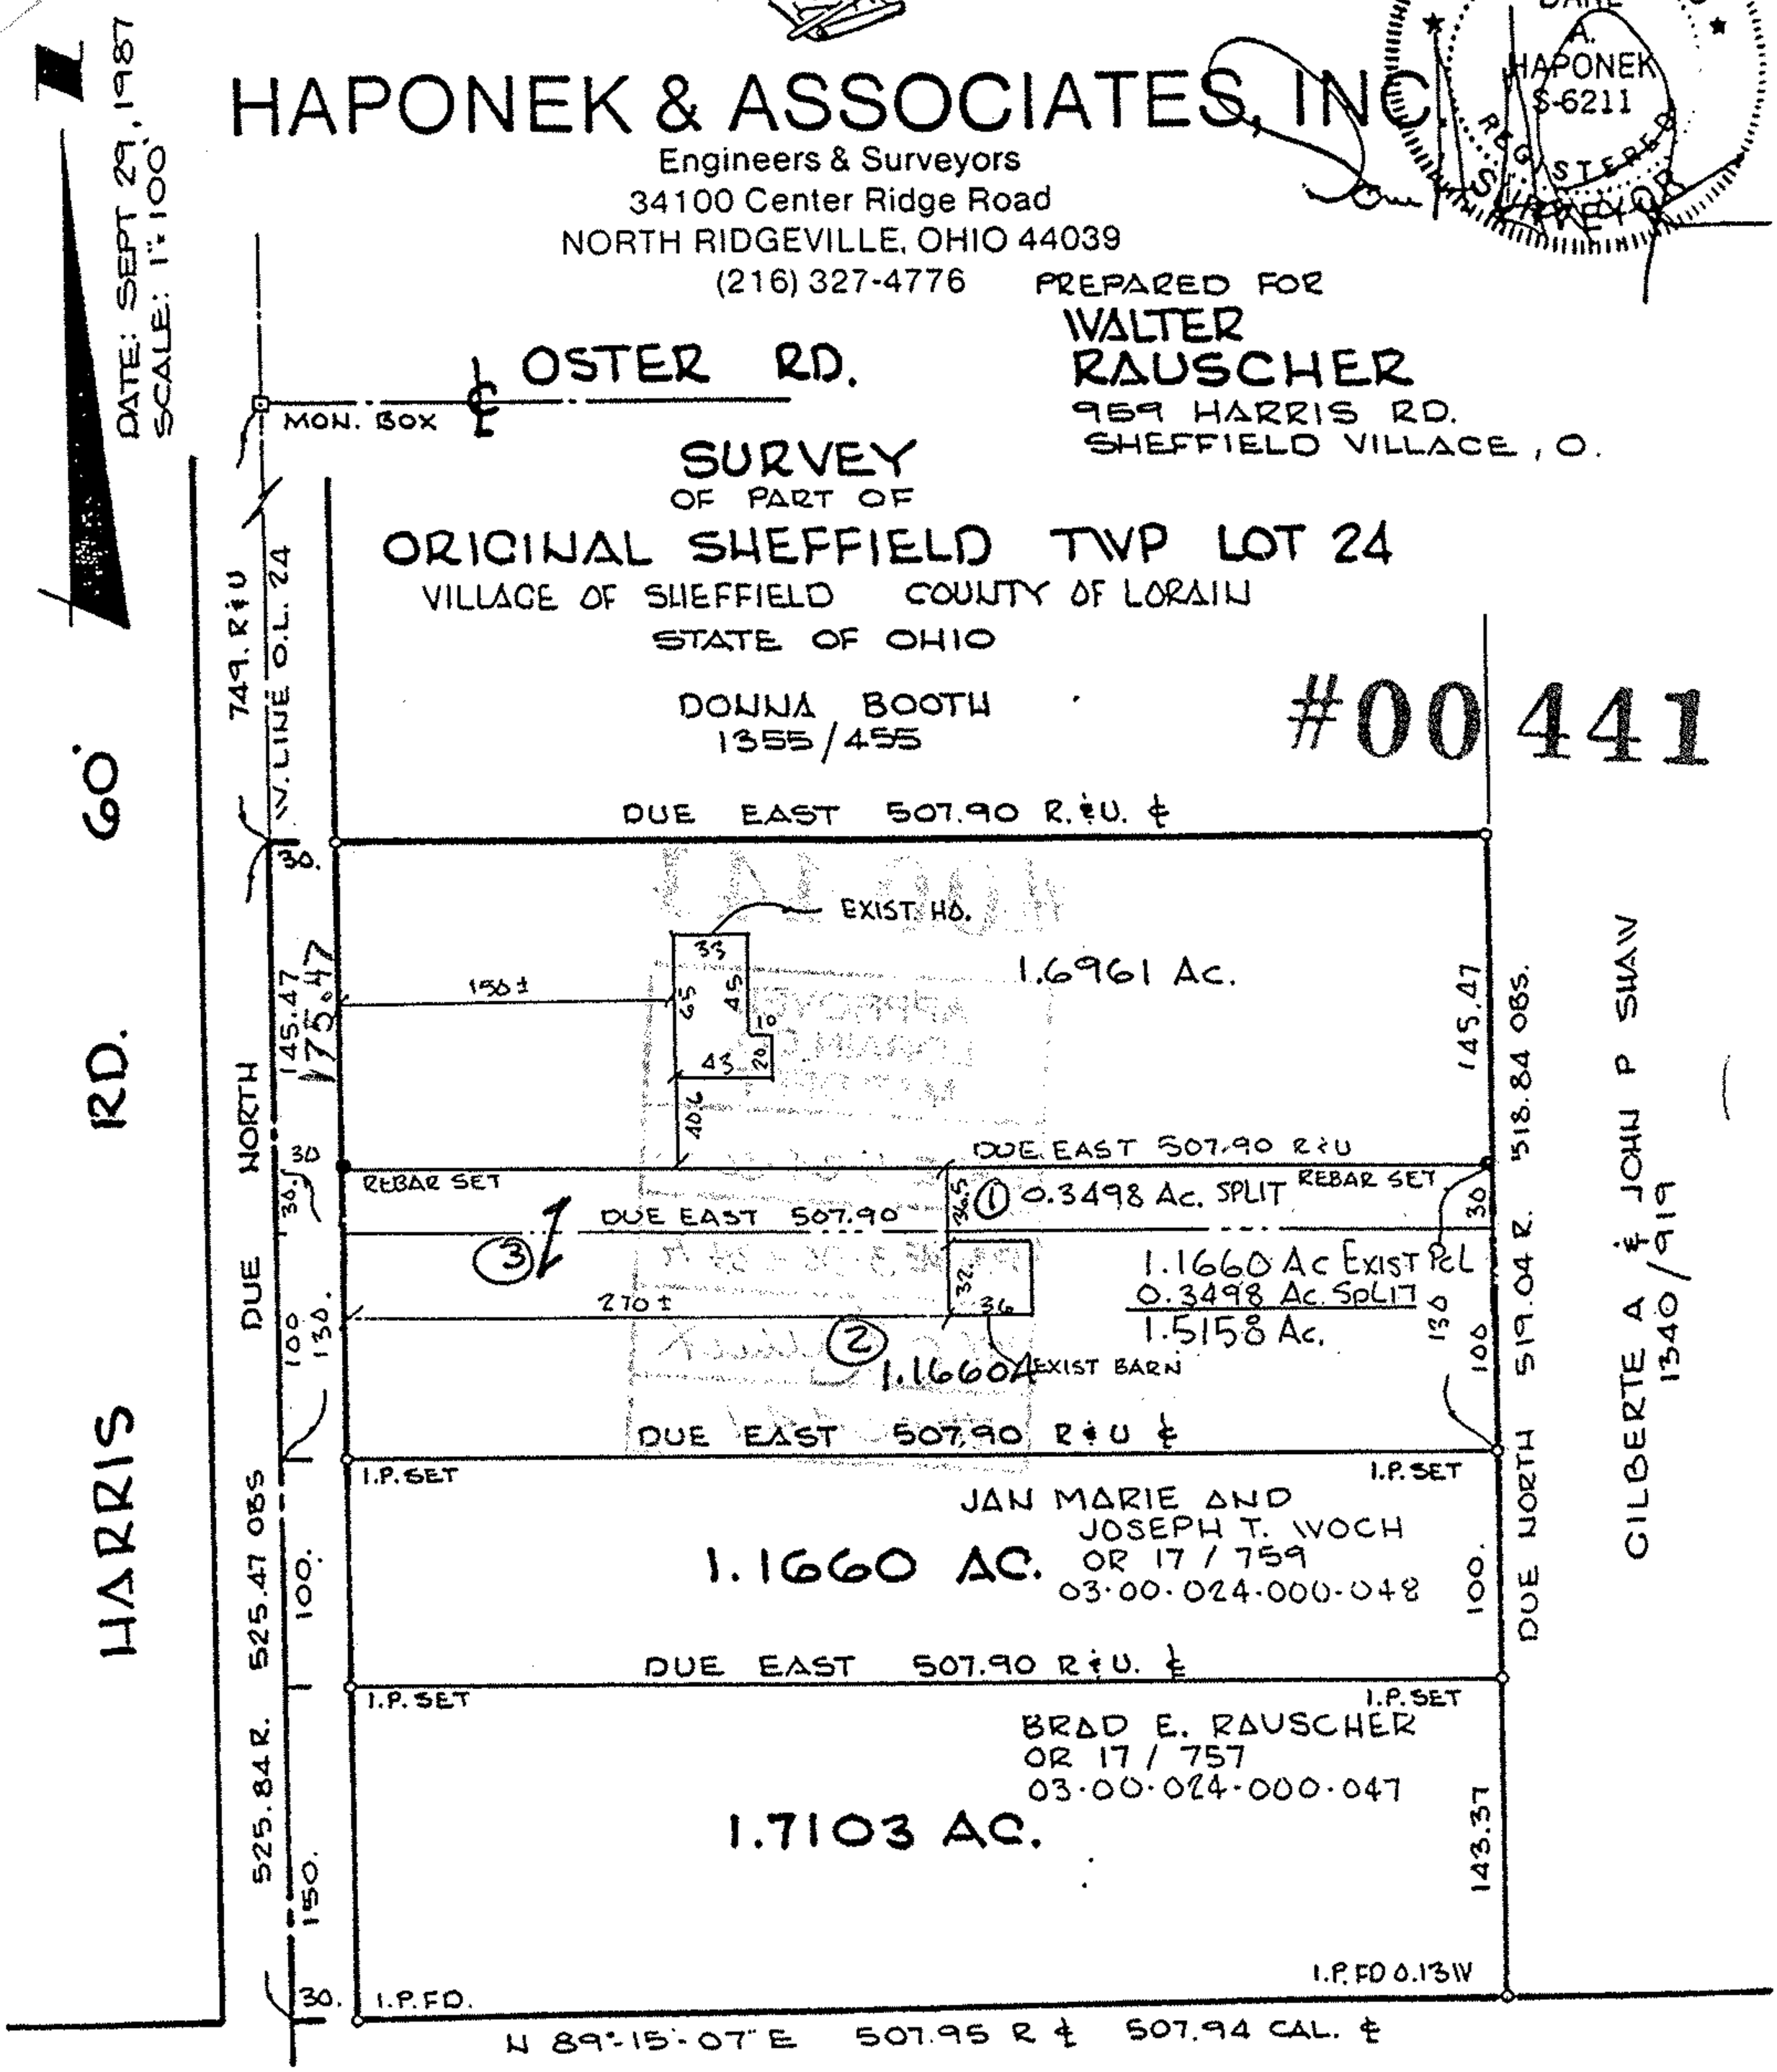


REVISED: AUG. 28, 1992
SEPT. 25, 1999

79115