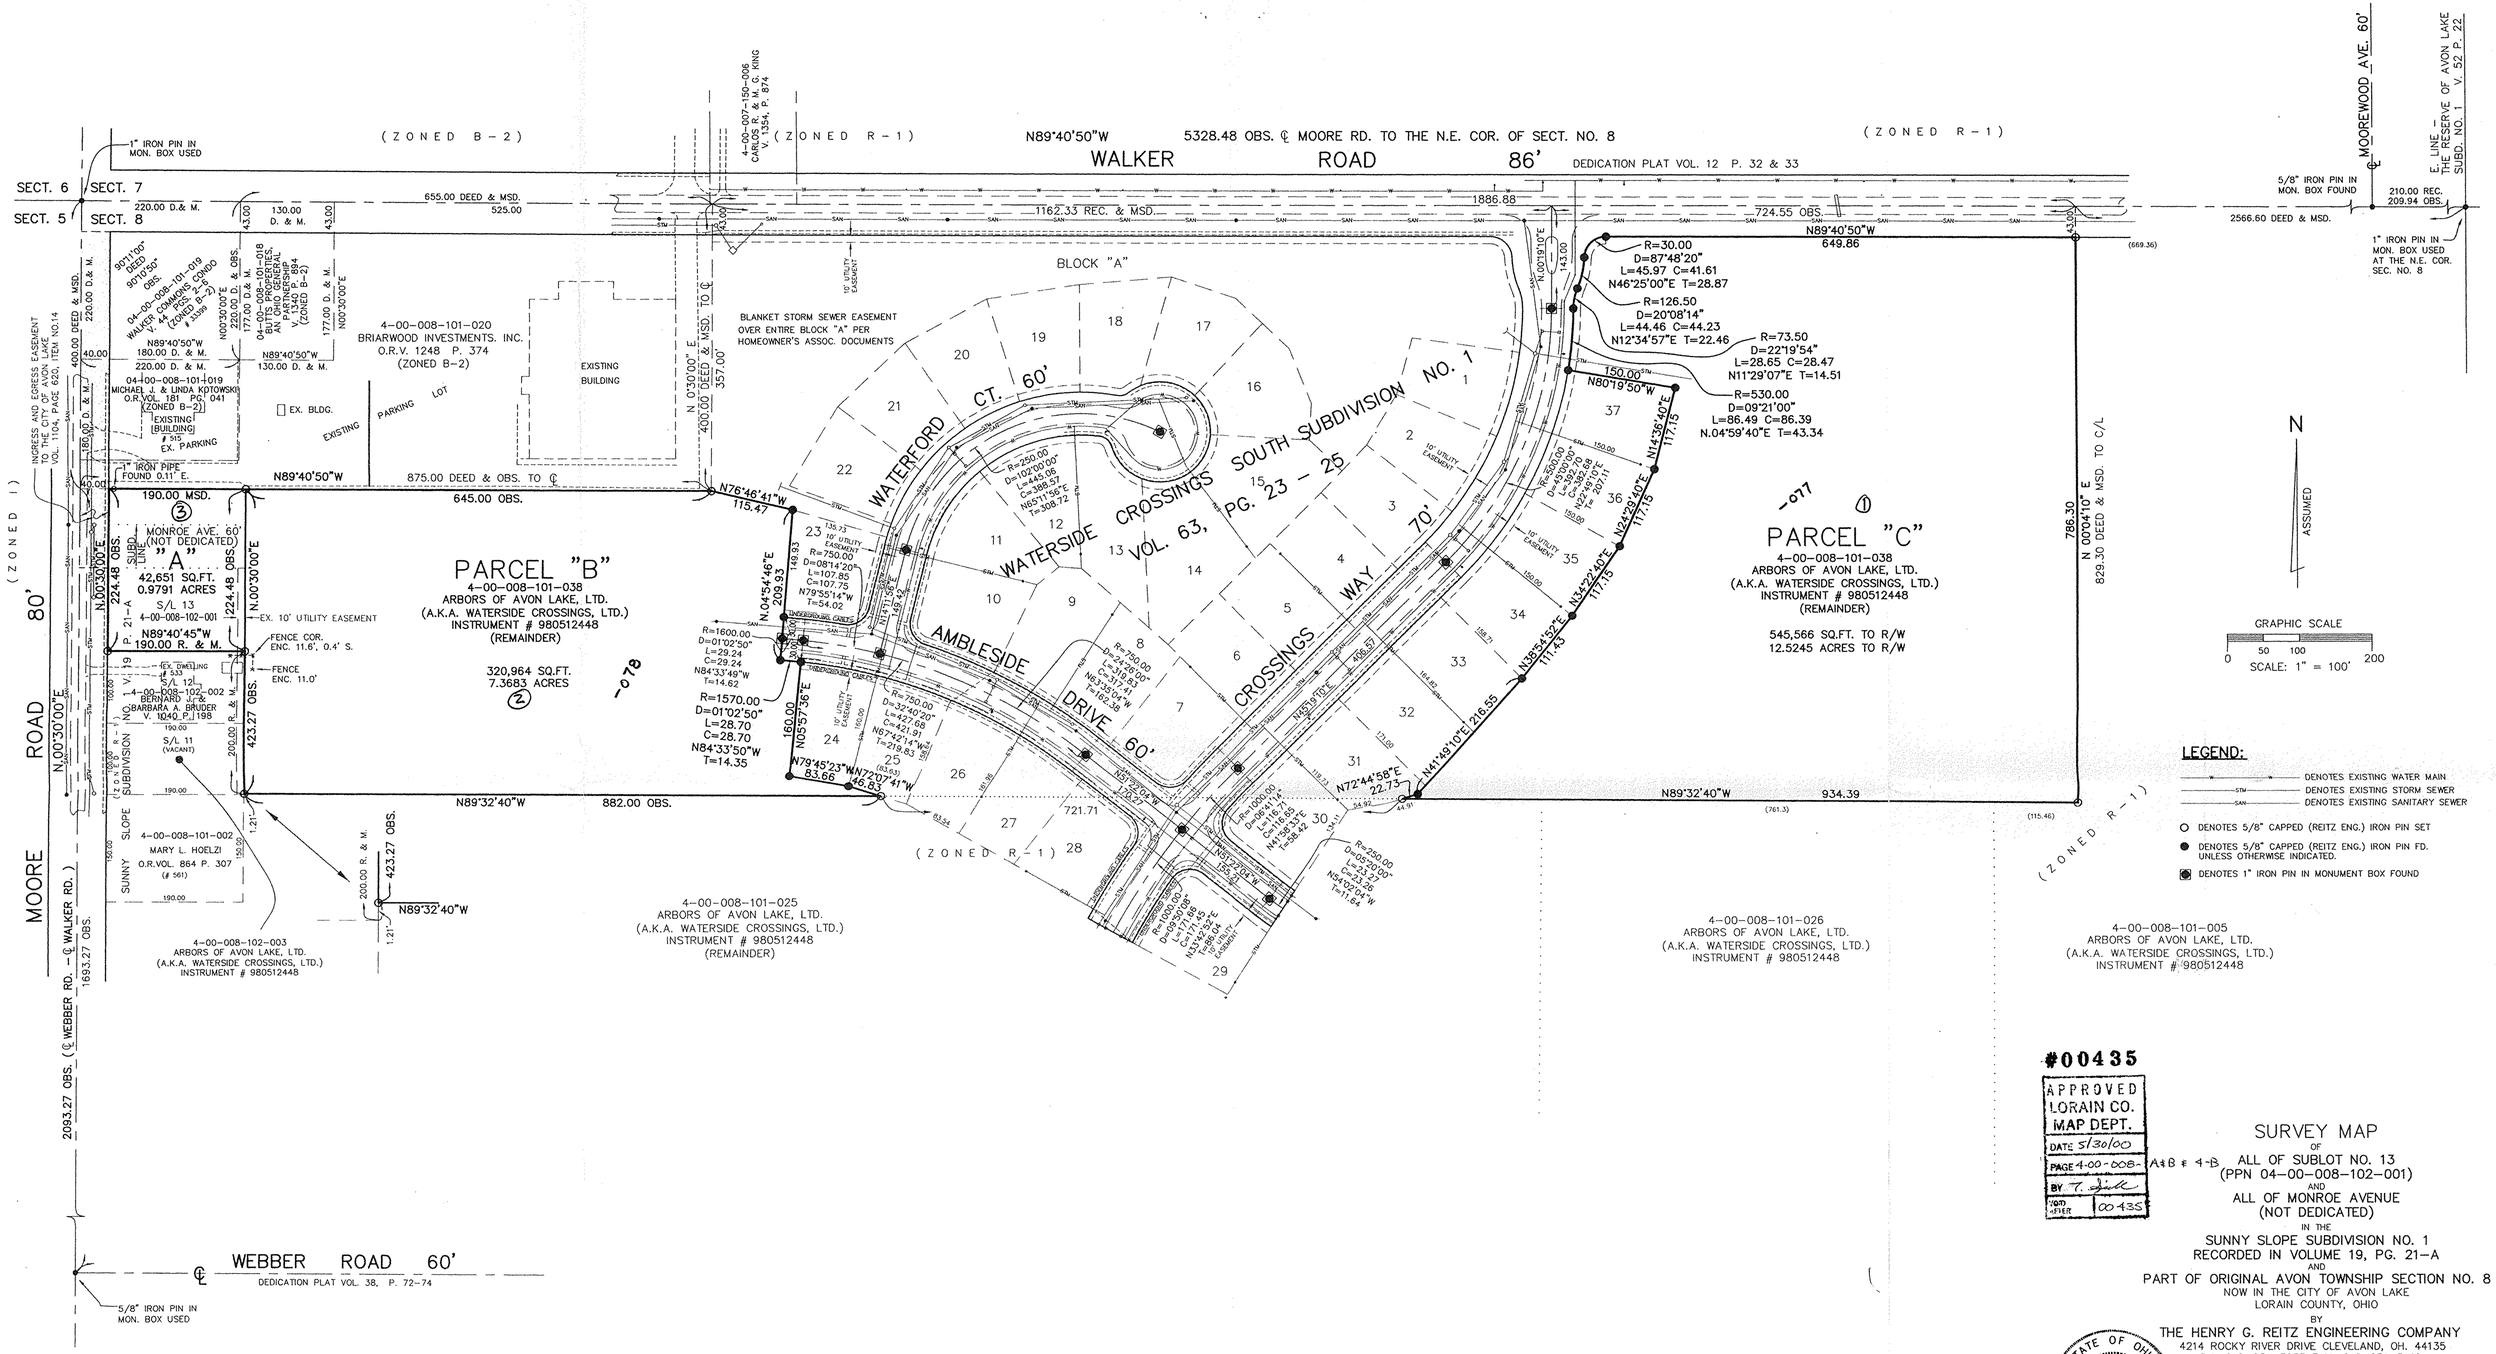


#00435

APPROVED
LORAIN CO.
MAP DEPT.
DATE 5/30/00
PAGE 4-00-008- A&B & 4-B
BY T. Shirk
(OTHER) 00435

# SURVEY MAP

OF

ALL OF SUBLOT NO. 13
(PPN 04-00-008-102-001)
AND
ALL OF MONROE AVENUE
(NOT DEDICATED)

IN THE

SUNNY SLOPE SUBDIVISION NO. 1
RECORDED IN VOLUME 19, PG. 21-A
AND
PART OF ORIGINAL AVON TOWNSHIP SECTION NO. 8
NOW IN THE CITY OF AVON LAKE
LORAIN COUNTY, OHIO

BY

THE HENRY G. REITZ ENGINEERING COMPANY
4214 ROCKY RIVER DRIVE CLEVELAND, OH. 44135
PH: 216-251-3033 FAX: 216-251-5149

STATE OF OHIO
DONALD E. WOIKE
5547
REGISTERED
SURVEYOR

BY Donald E. Woike PRES.

DONALD E. WOIKE, OHIO REG. SURV. NO. 5547
SCALE: 1" = 100' FEBRUARY, 2000
REV. 3/22/2000 (ADDED EASEMENTS)
REV. 5/30/2000 (ADD CURVE TANGENT DATA)