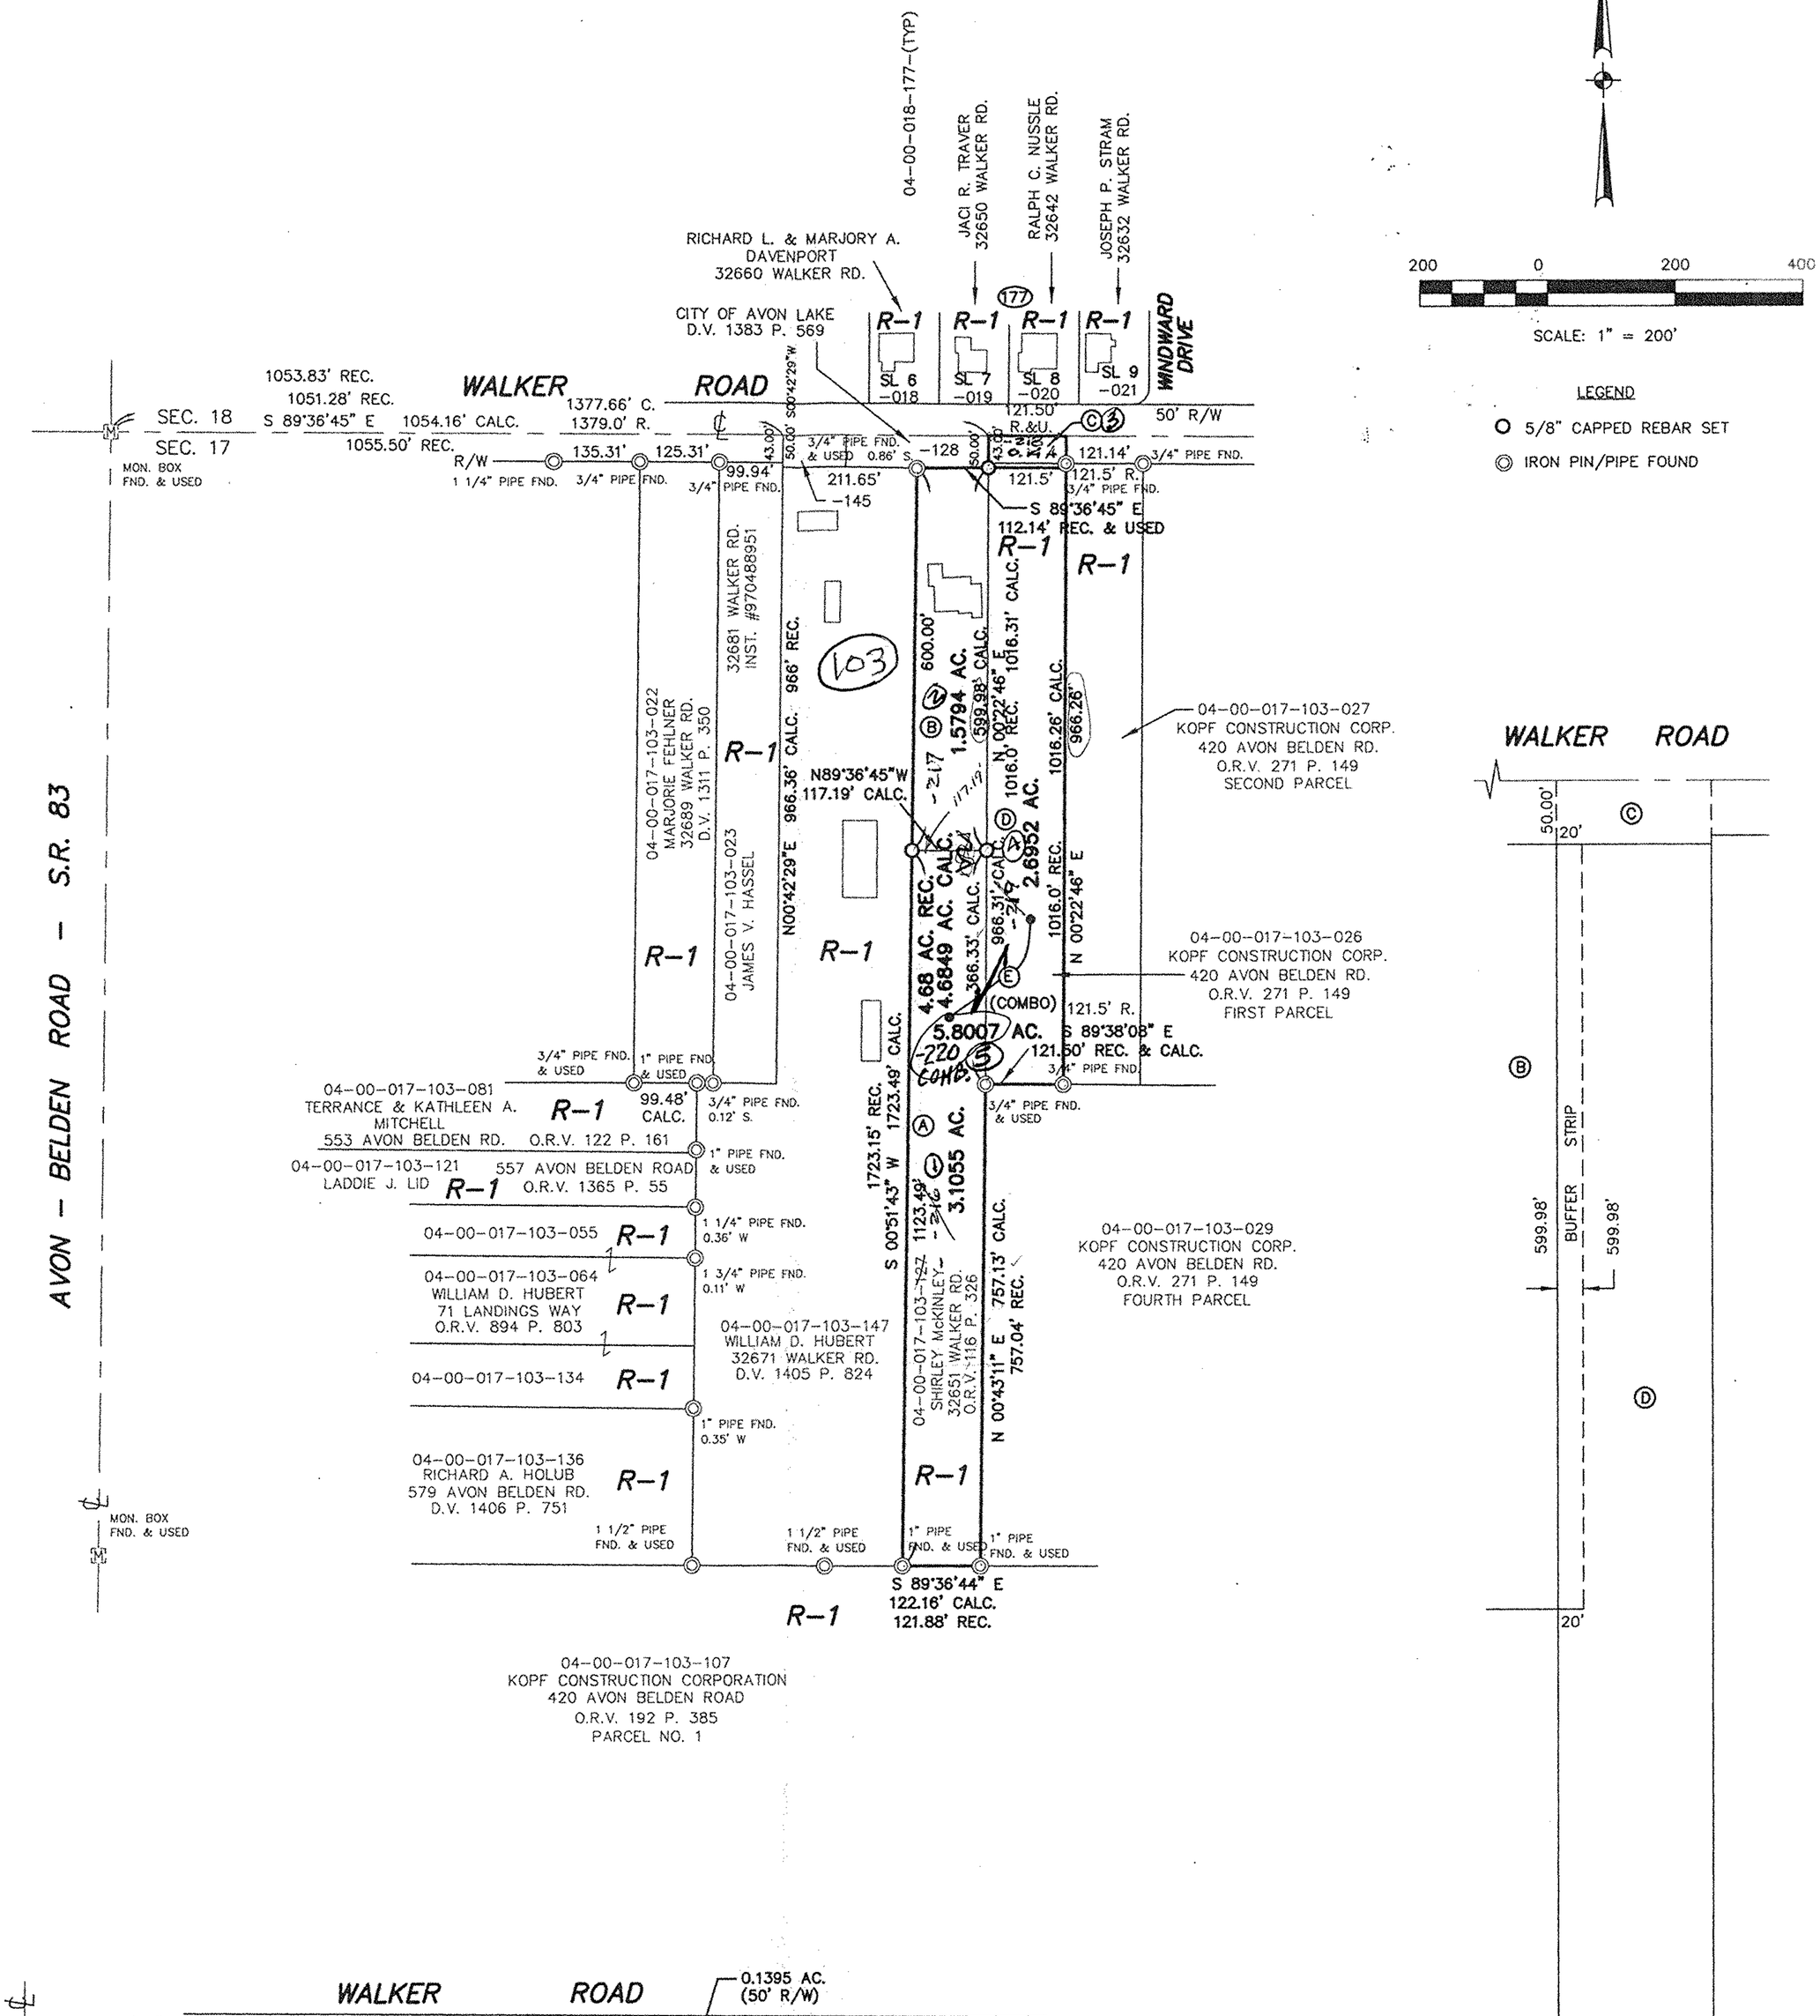

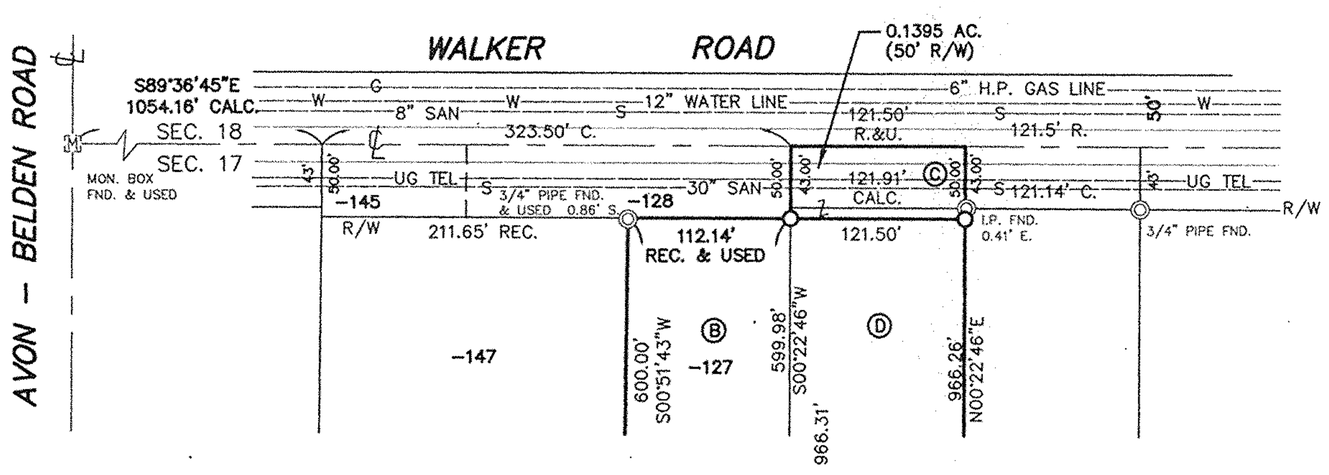

DETAIL
SCALE: 1" = 100'

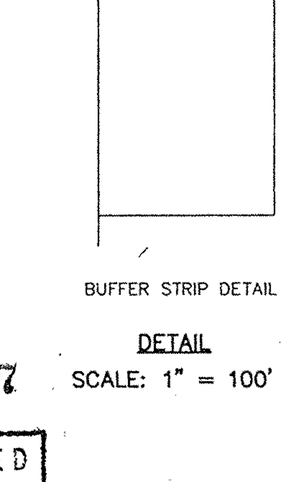

BUFFER STRIP DETAIL

DETAIL
SCALE: 1" = 100'

#00437

APPROVED
LORAIN CO.
MAP DEPT.
DATE 5-31-00
PARCEL 4-00-017-C#D
BY T.McNair
SUR. #00437

DAVID L. ELWELL, REGISTERED SURVEYOR NO. 6333

STATE OF OHIO
DAVID L ELWELL
6333
REGISTERED SURVEYOR

REVISION DATE: MARCH 9, 2000

KS ASSOCIATES
424 Middle Avenue
P.O. Box 569
Elyria, Ohio 44036
Phone (440) 322-6317
Fax (440) 284-0623
mailroom@ksassoc.com
www.ksassoc.com

SURVEY MAP
OF PART OF
ORIGINAL AVON TOWNSHIP SECTION NO. 17
CITY OF AVON LAKE COUNTY OF LORAIN STATE OF OHIO
JANUARY 18, 2000

JOB NO. 99003-MC

DWG. NAME R:\99003\R:\DWGS\0-SURV03