MAP OF LOT SPLIT & CONSOLIDATION
MADE AT THE INSTANCE OF
EUGENE SMOLIK
ORIGINAL COLUMBIA TOWNSHIP LOT N° 73
LORAIN COUNTY, OHIO

ORDER N° 00-020 F.B. 743, PG. 14
MARCH 2, 2000

HOFMANN-METZKER, INC.
REGISTERED PROFESSIONAL SURVEYORS
24 BEECH STREET
BEREA, OHIO 44017
(440)-234-7350

BY: GEORGE A. HOFMANN
REGISTERED SURVEYOR N° 6752

STATE OF OHIO GEORGE A. HOFMANN 6752 REGISTERED SURVEYOR

#00 428

APPROVED LORAIN CO. MAP DEPT
DATE 5-12-2000
PAGE 12-E
BY
#00428

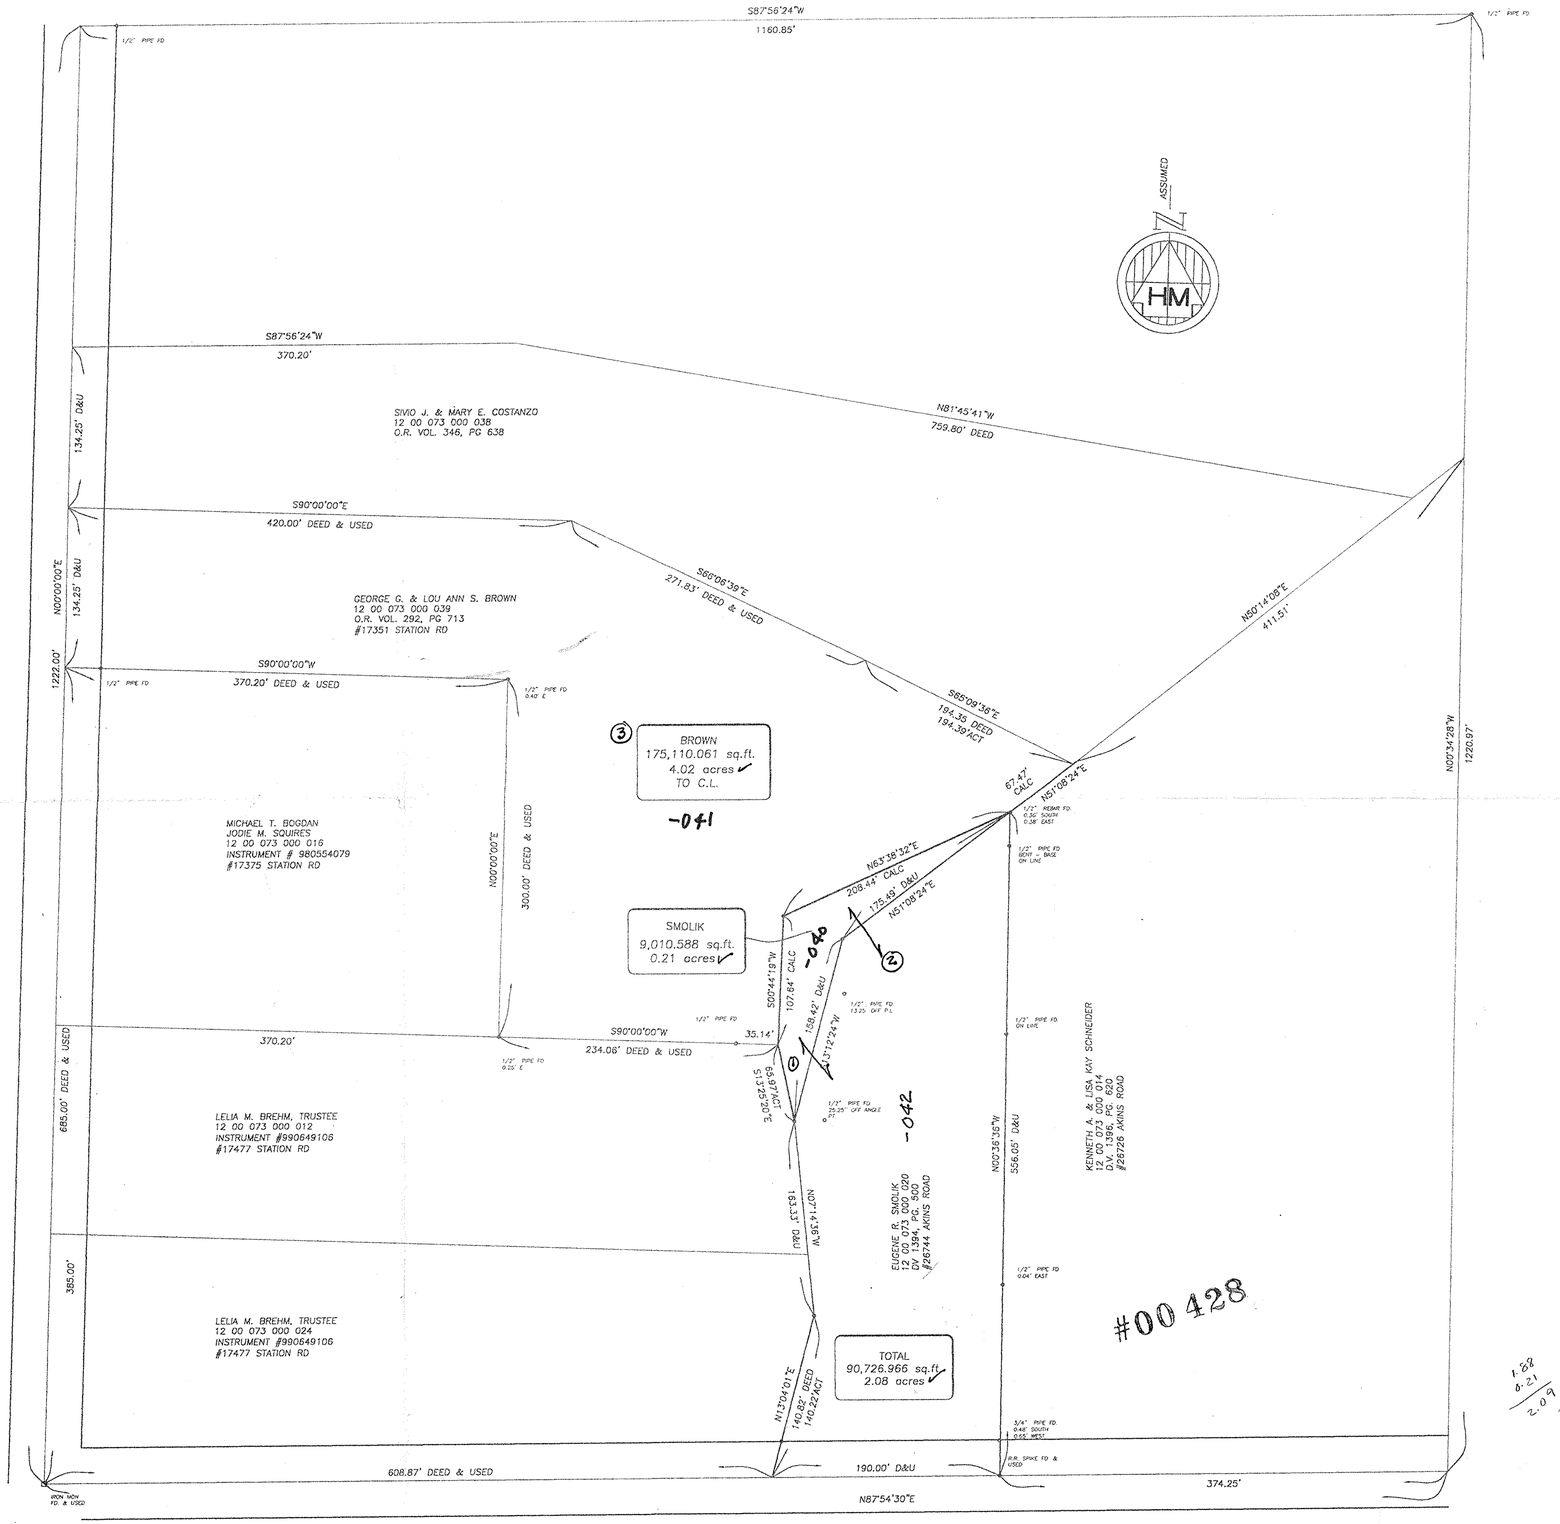

#00 428

APPROVED LORAIN CO. MAP DEPT
DATE
PAGE
BY

O I.P.S. INDICATES 5/8" IRON PIN SET AND CAPPED 6752/7477

GRAPHIC SCALE
60 0 30 60 120 240
(IN FEET)
1 inch = 60 ft.

1.88
0.21
2.09

LORAIN COUNTY TAX MAP DEPT
P.P. NO.