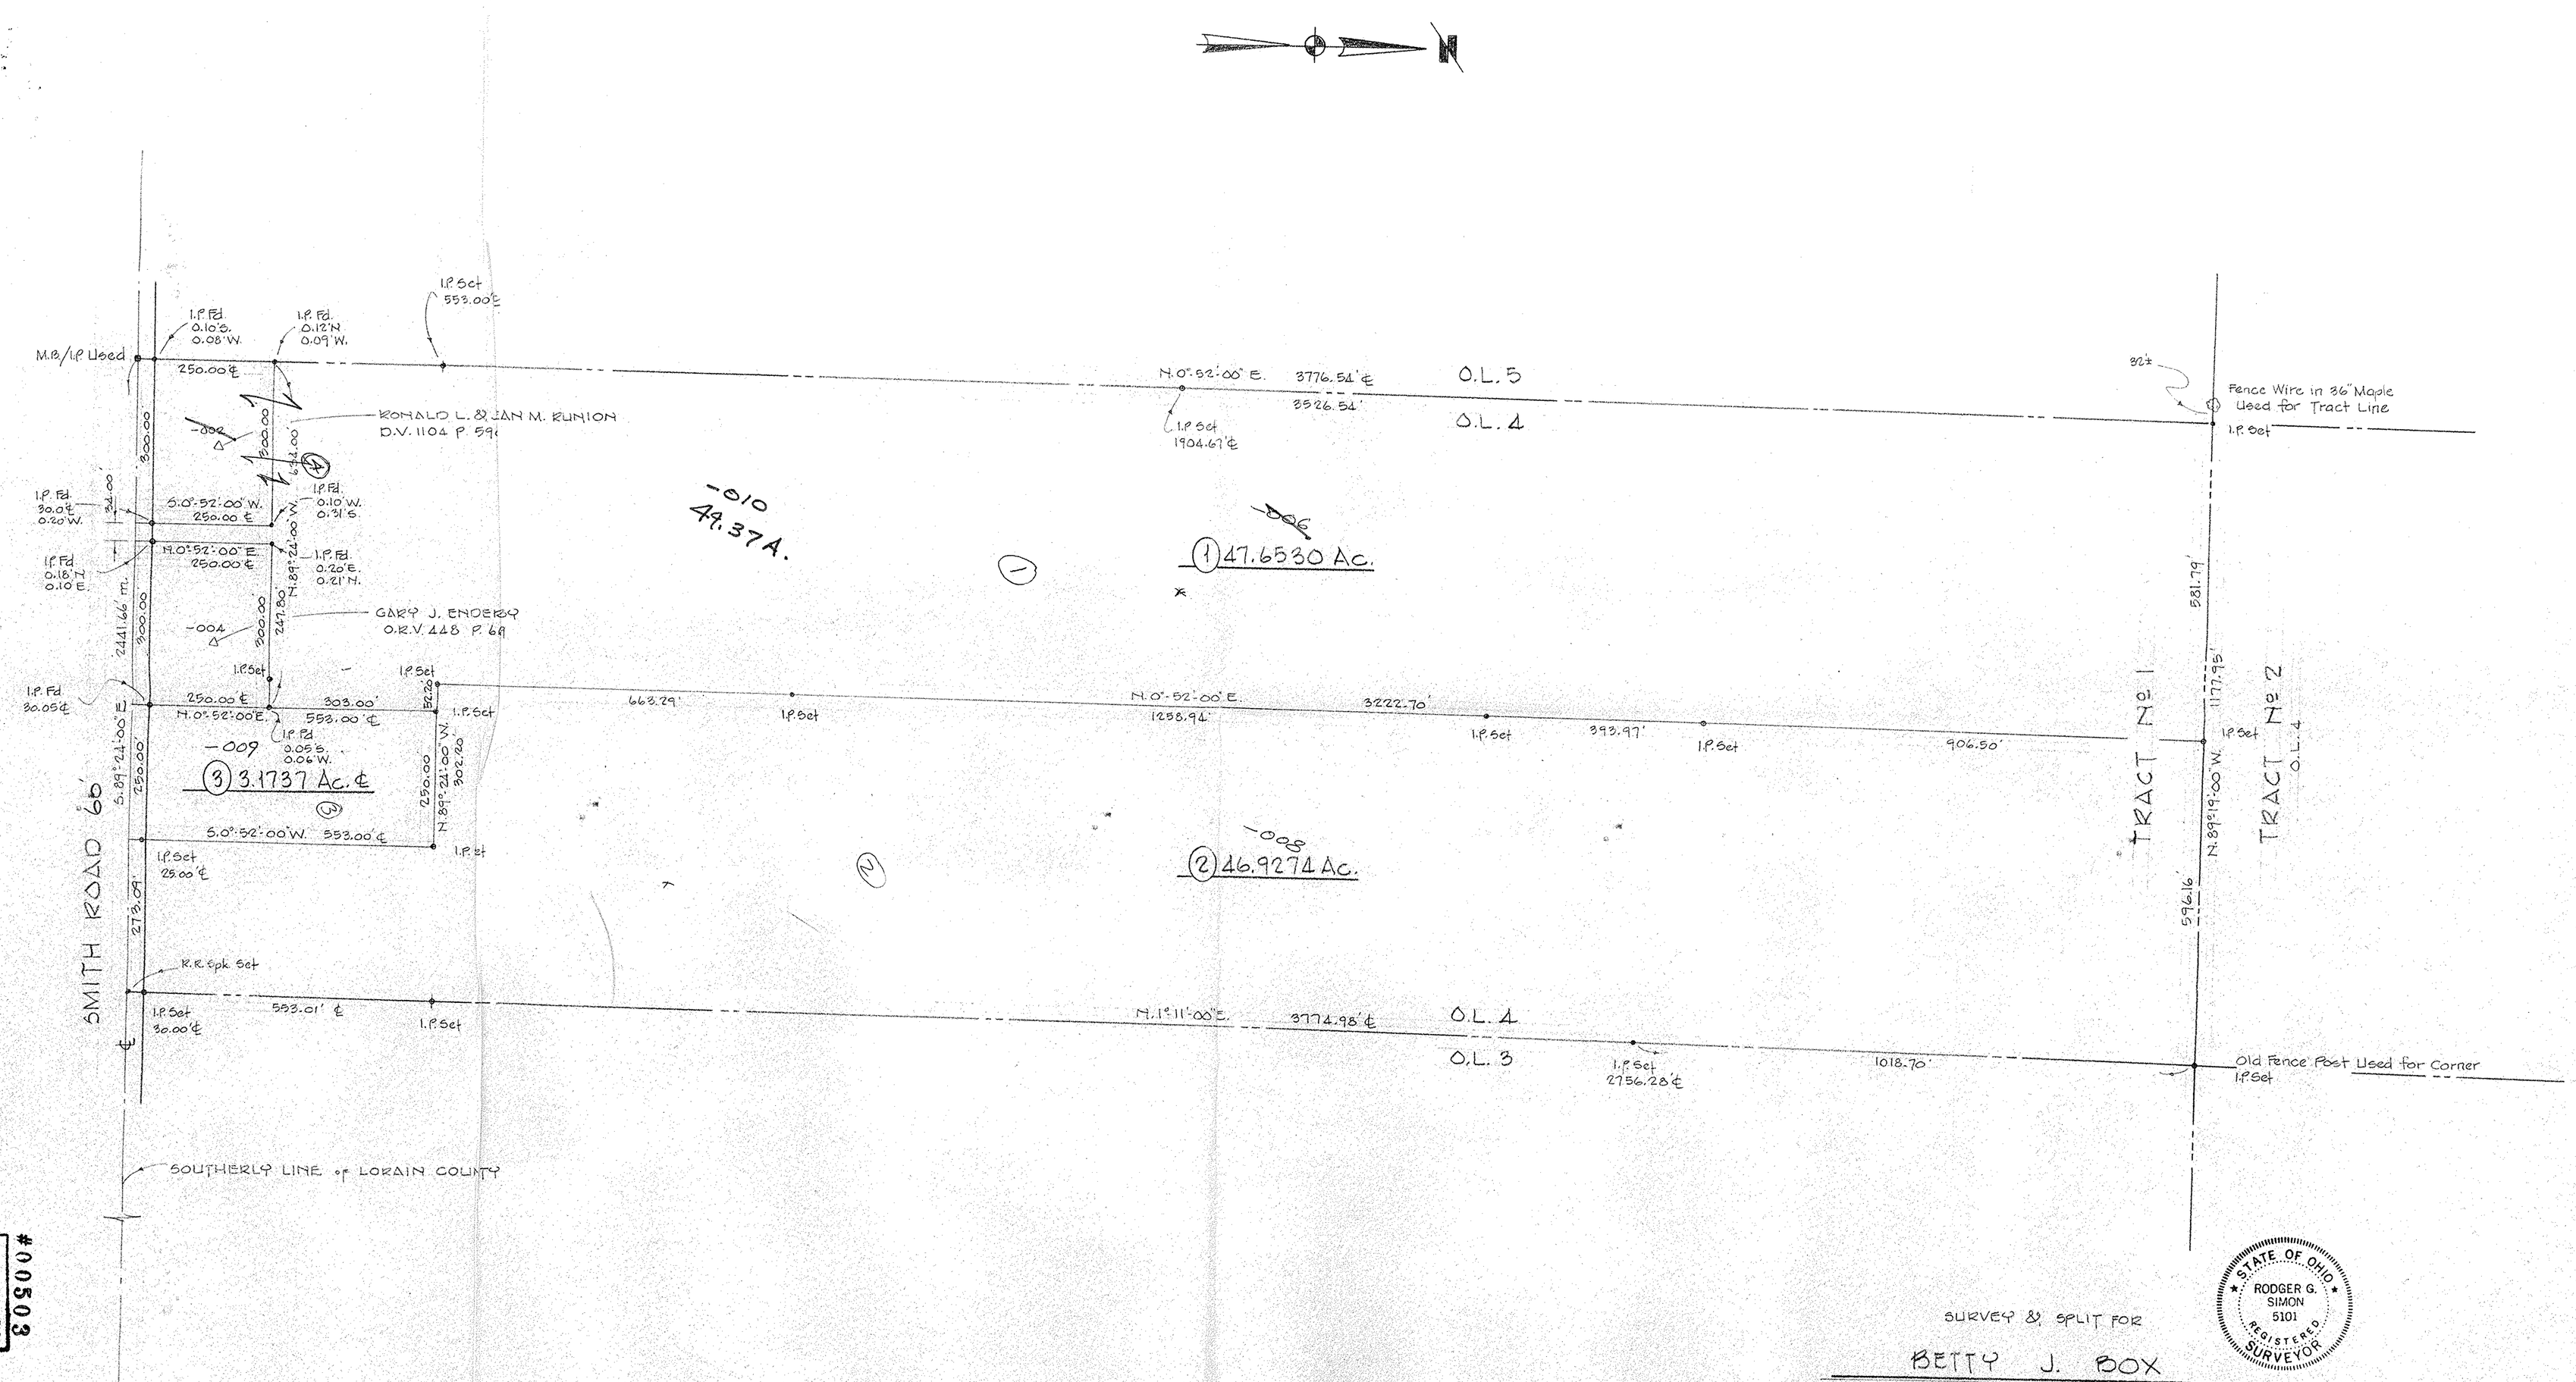


APPROVED
LORAIN CO.
MAP DEPT.
DATE 7/18/00
PAGE 19-E
BY T. Sullivan
00503
#00503

STATE OF OHIO
RODGER G. SIMON
5101
REGISTERED SURVEYOR

SURVEY & SPLIT FOR

BETTY J. BOX

PART of O.L. 4 IN TRACT No. 1 of PENFIELD TOWNSHIP
COUNTY of LORAIN STATE of OHIO
SCALE 1" = 150' MARCH, 2000
BY
LAUNDON • SIMON • CAHL & ASSOC.
PROFESSIONAL LAND SURVEYORS
JOB No. 00-3222 F.B. 247 P. 50-51