LOT-SPLIT SURVEY

for

HOWARD A. BORN & DONALD L. ORTNER, ET AL

SITUATED IN THE TOWNSHIP OF PITTSFIELD, COUNTY OF LORAIN, STATE OF OHIO AND
KNOWN AS BEING PART OF ORIGINAL PITTSFIELD TOWNSHIP LOT NUMBERS 49 & 50.

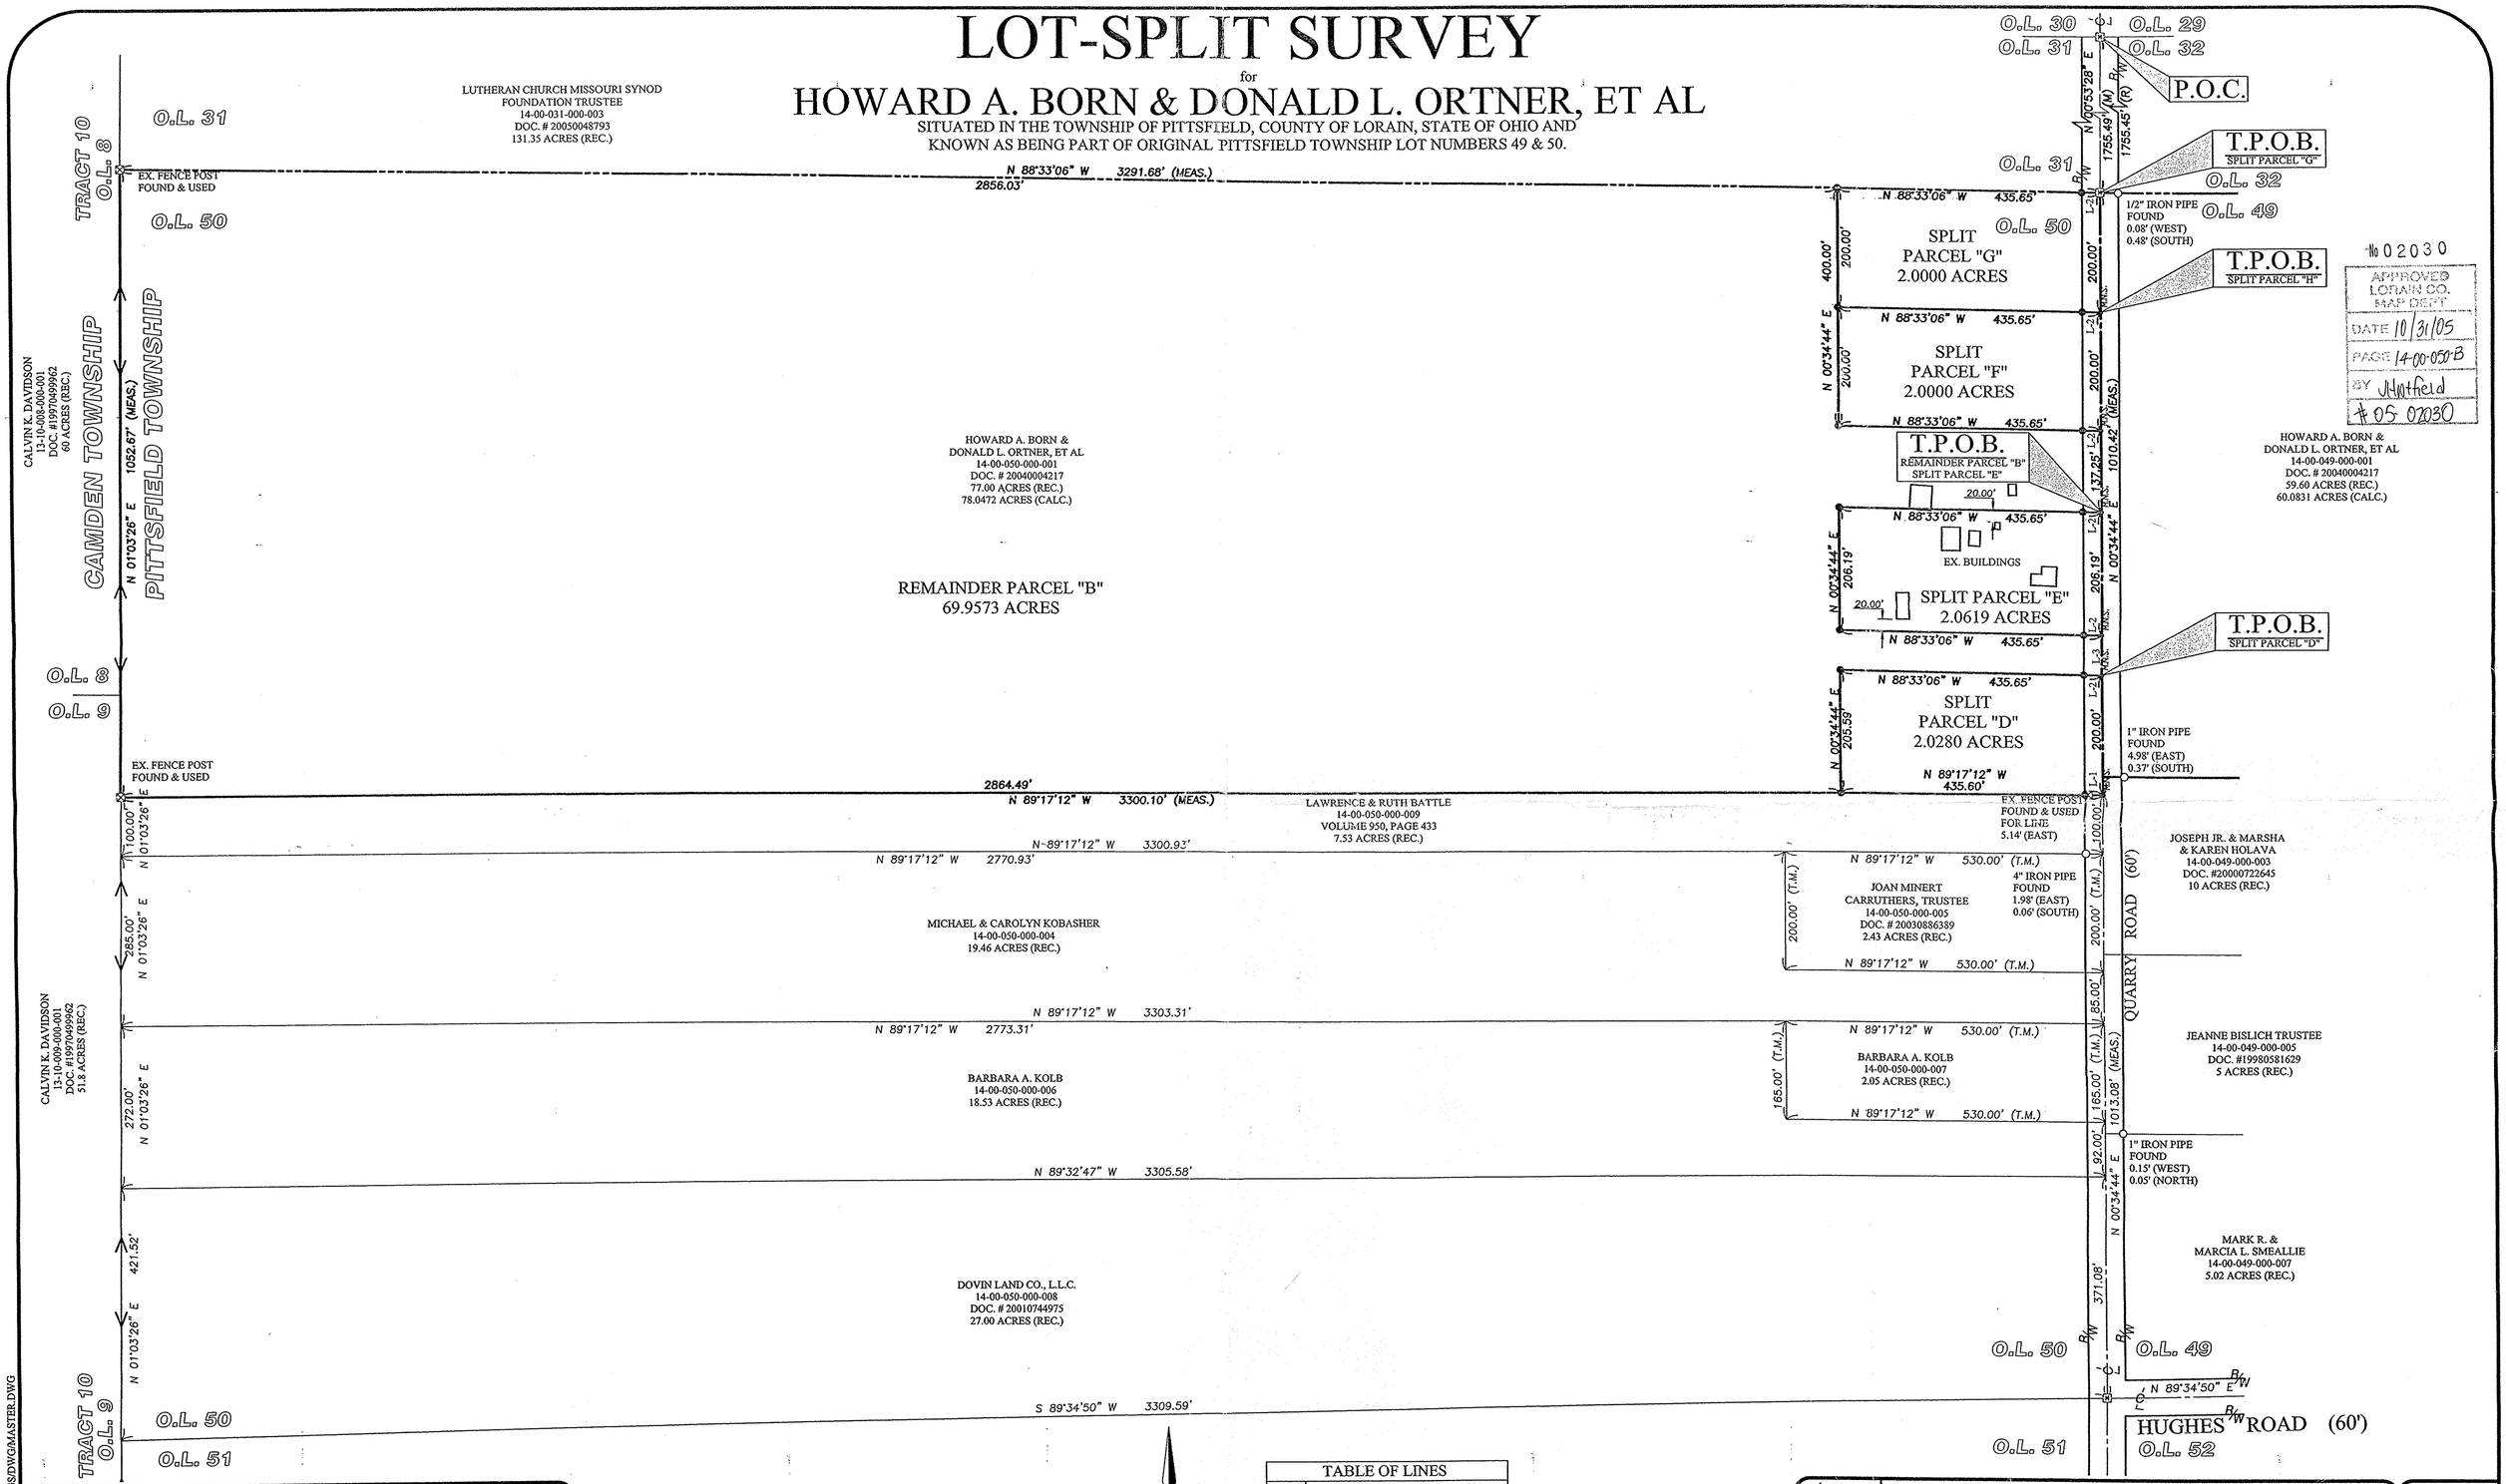

DATE:	BY:	DESCRIPTION:
10/06/04	CMH	ISSUE TO CLIENT
03/01/05	CMH	REVISED PER CLIENT

REVISION

BASIS OF BEARINGS:

A PORTION OF THE CENTERLINE OF QUARRY ROAD WHICH WAS ASSUMED TO BE NORTH 00° 34' 44" EAST

AS SURVEYED IN JULY OF 2004

GRAPHIC SCALE

0 60 120 240

(IN FEET)
SCALE: 1"=120'

TABLE OF LINES

LINE	BEARING	DISTANCE
L-1	N 89°17'12" W	30.00'
L-2	N 88°33'06" W	30.00'
L-3	N 00°34'44" E	66.98'

DRAWN BY: BDA

CHECKED BY: CMH

BRAMHALL
ENGINEERING AND SURVEYING CO., INC.
37307 HARVEST DRIVE AVON, OHIO 44011
(440) 934 - 7878 (440) 934 - 7879 FAX

SHEET 2 OF 3

JOB NO. 04-1892

J:\041892\DRAWINGS\DWGMASTER.DWG