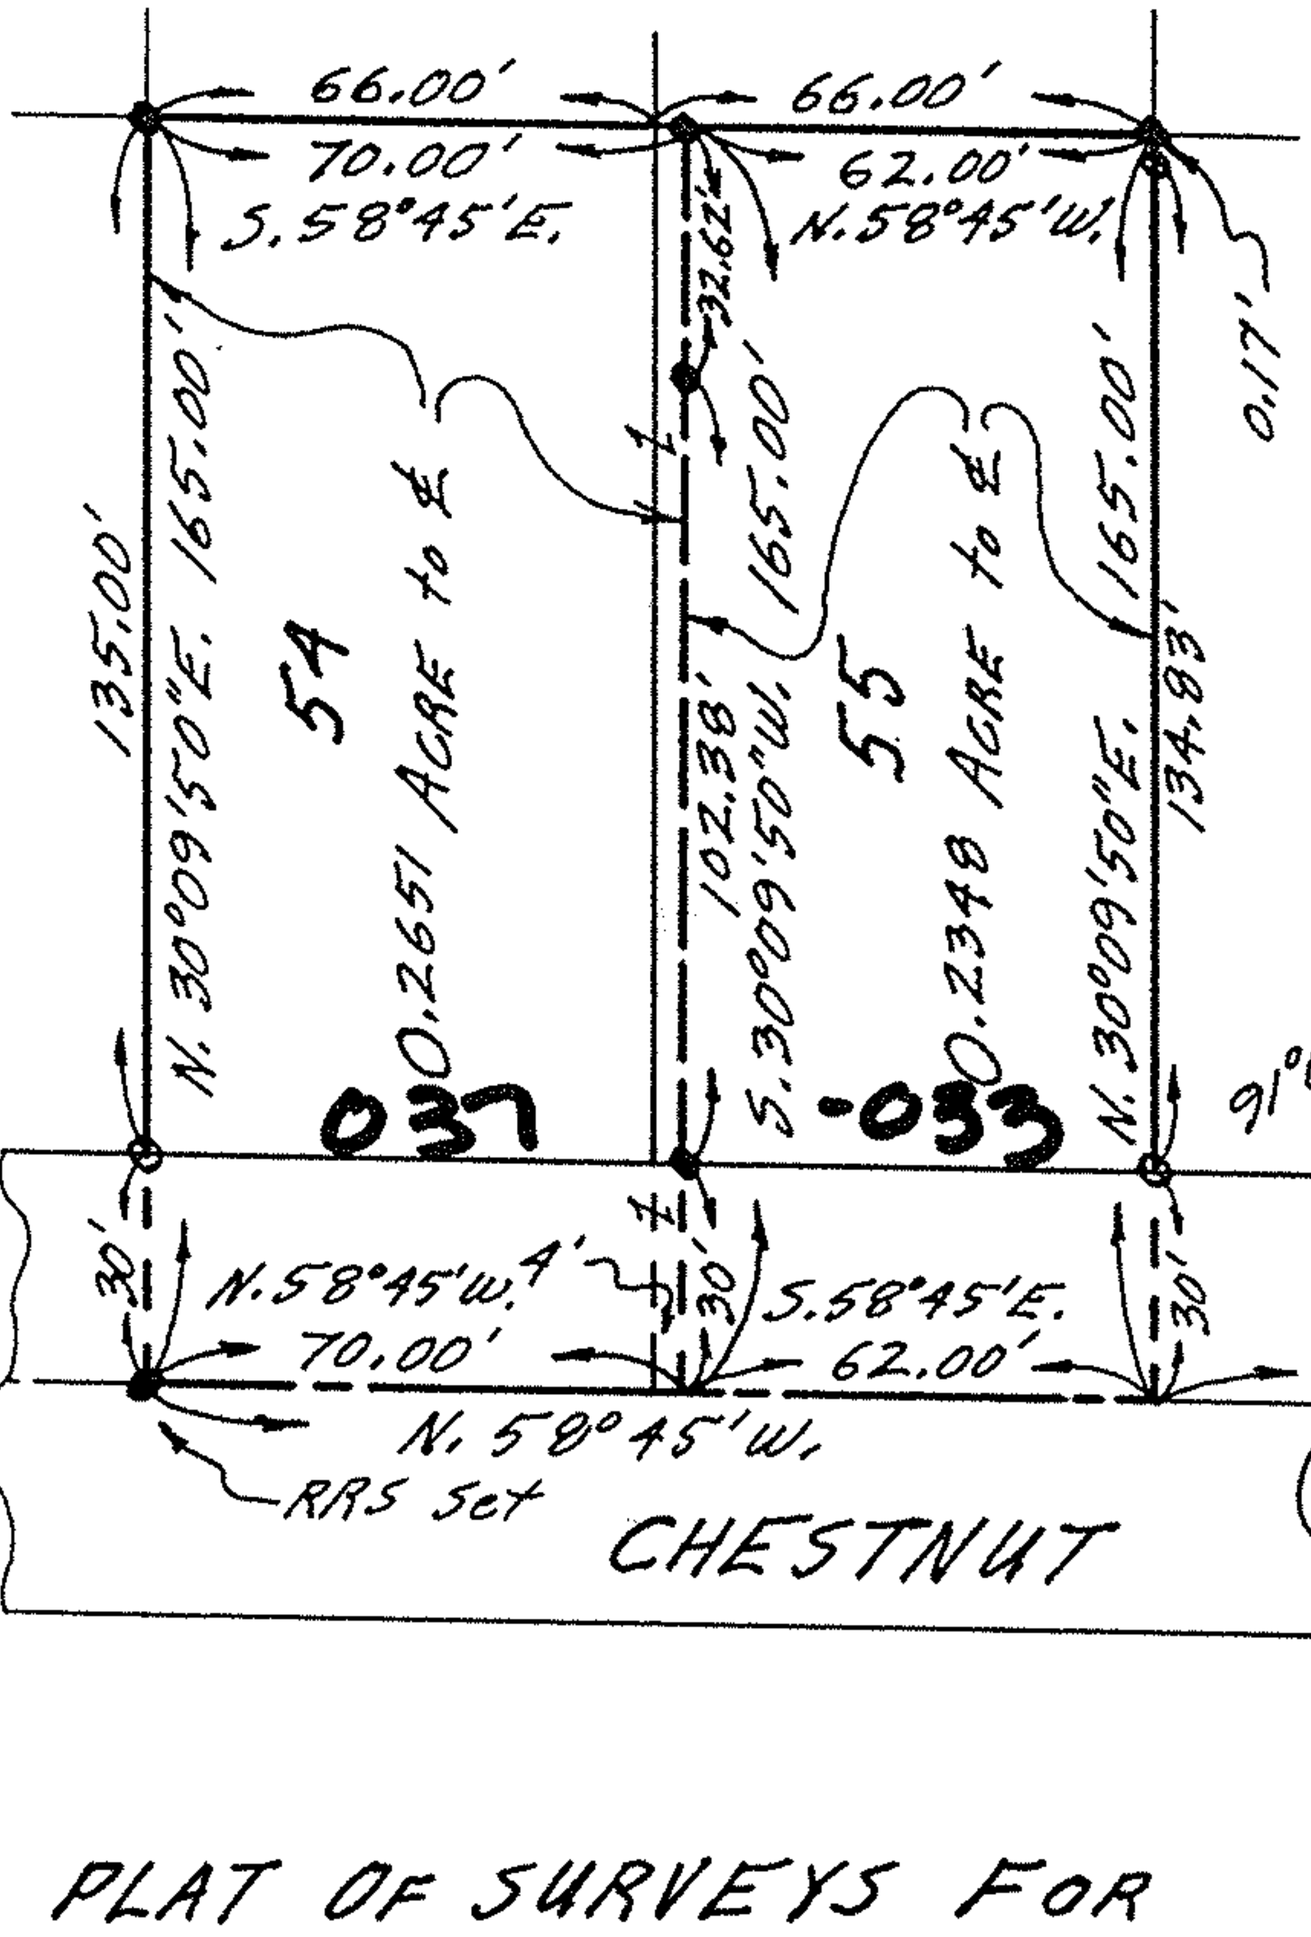

PLAT OF SURVEYS FOR STANLEY McALPIN

DIVISION OF SUB-LOTS 54 & 55 OF TOWN PLATS OF RAWSONVILLE

VOL. 1 - PGS. 23 & 24 PLAT RECORDS

ORIGINAL LOT 1 - GRAFTON TWP.

GRAFTON VILLAGE

LORAIN COUNTY OHIO

SCALE: 1"=40' OCTOBER - 1974

Gary E. Penfound

Reg. Surveyor No. 4457

No. 00.001.107.033037