ORIGINAL LOT Nº 12 OF AMHERST TOWNSHIP, NOT AMHERST VILLAGE, LORAIN COUNTY, OHIO
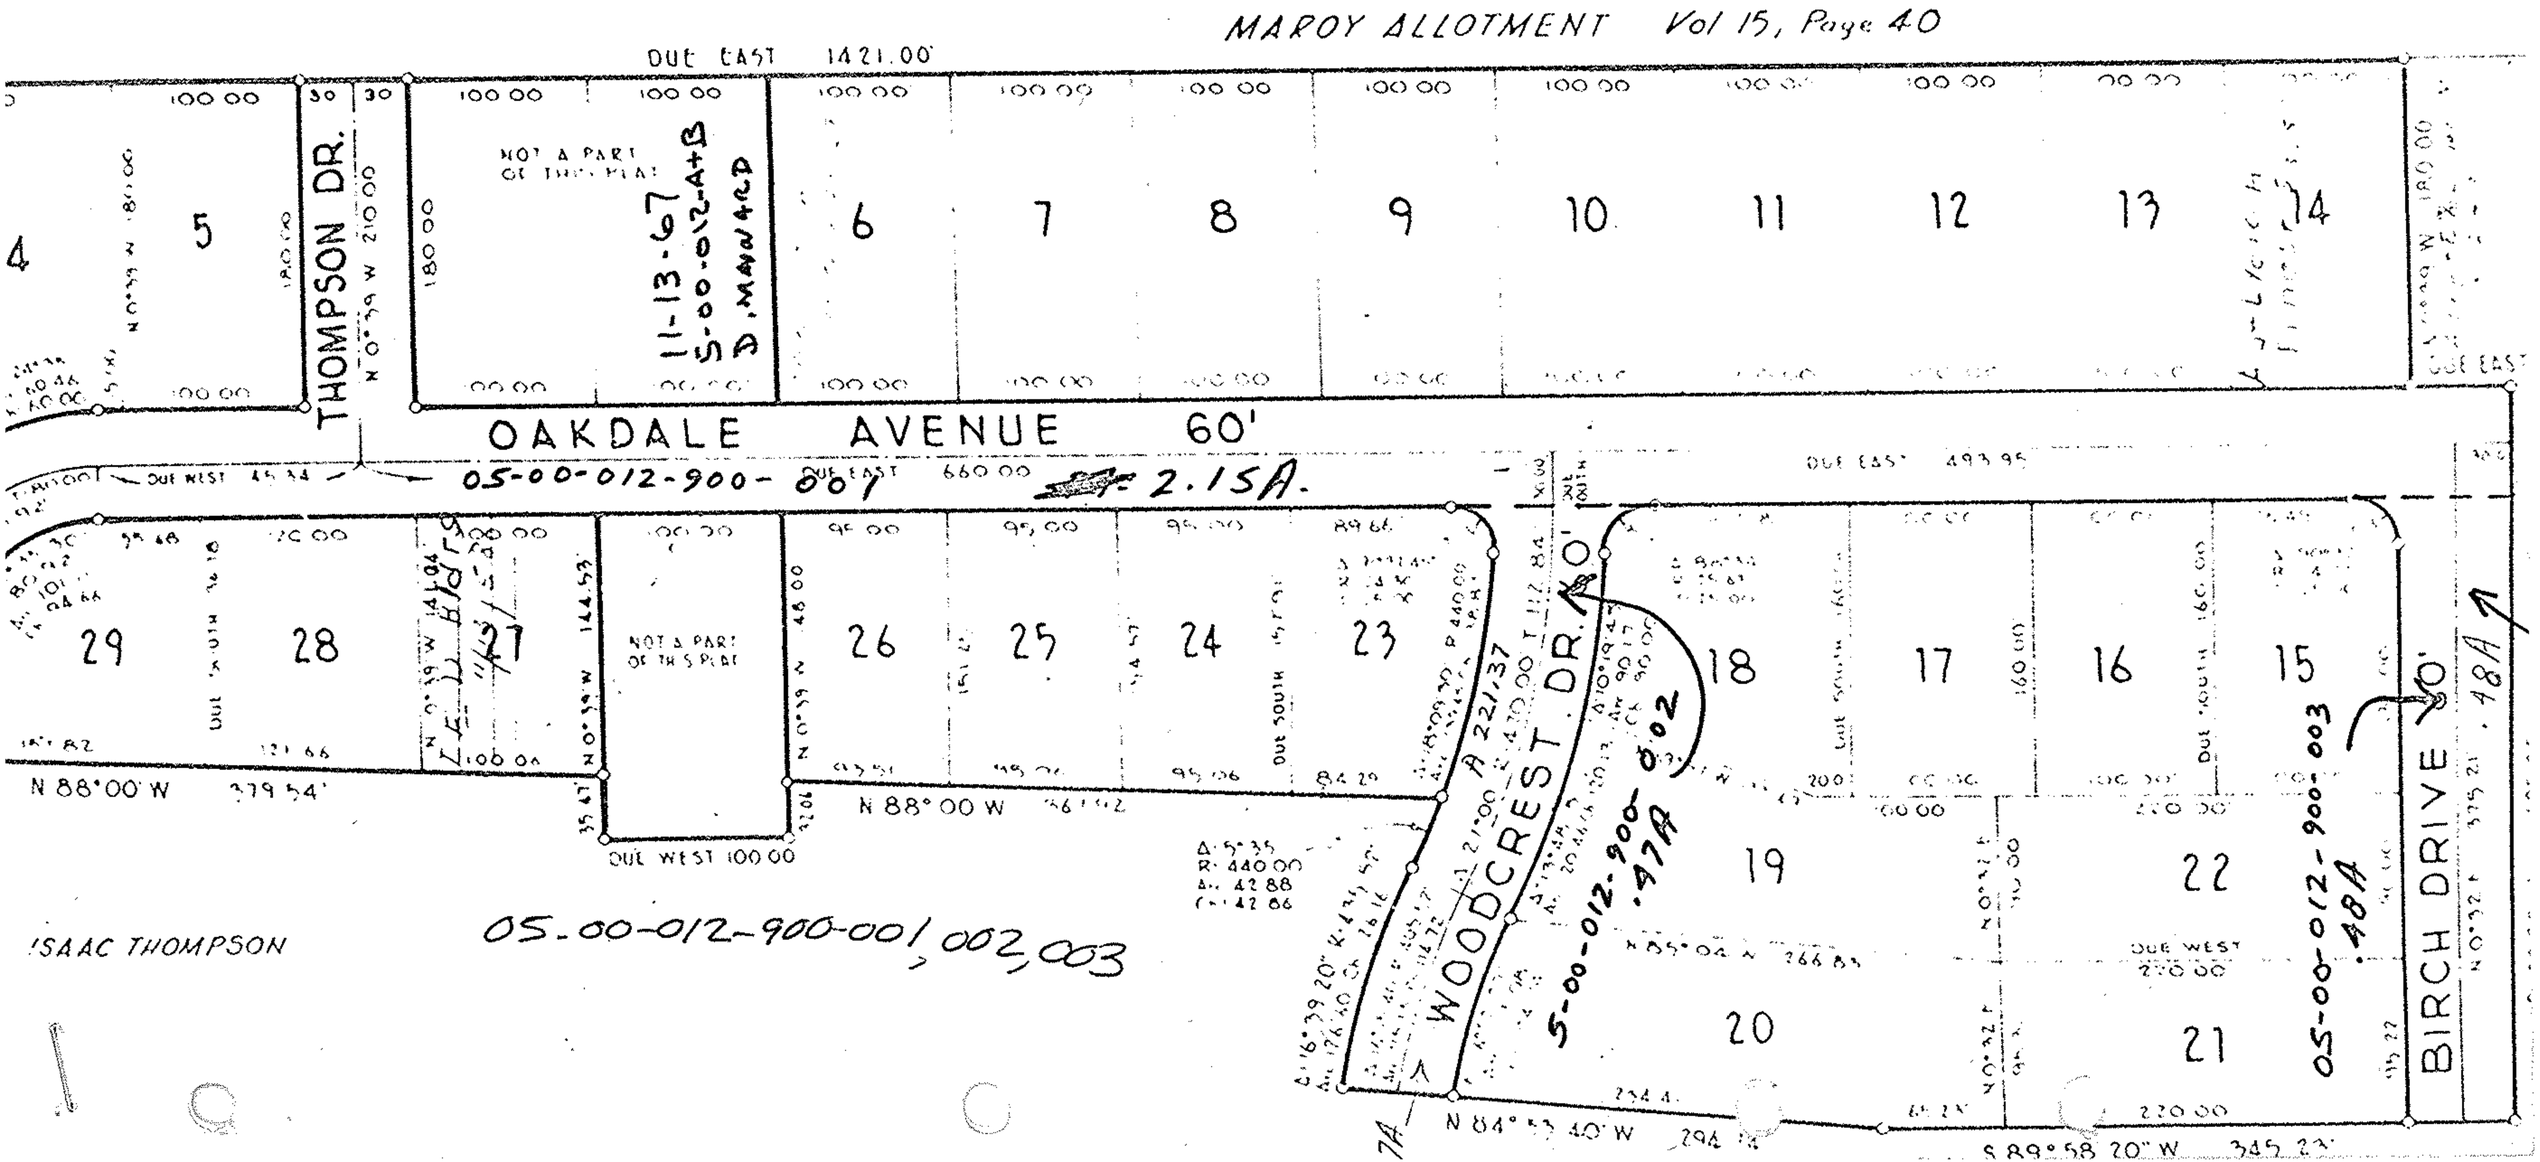
1957 ~ Scale 1" = 100' ~ by RAY E. HOLLIS, registered surveyor